


Scale of maps. 8 in to 1 mi.

Township 20 S. R. 5. W

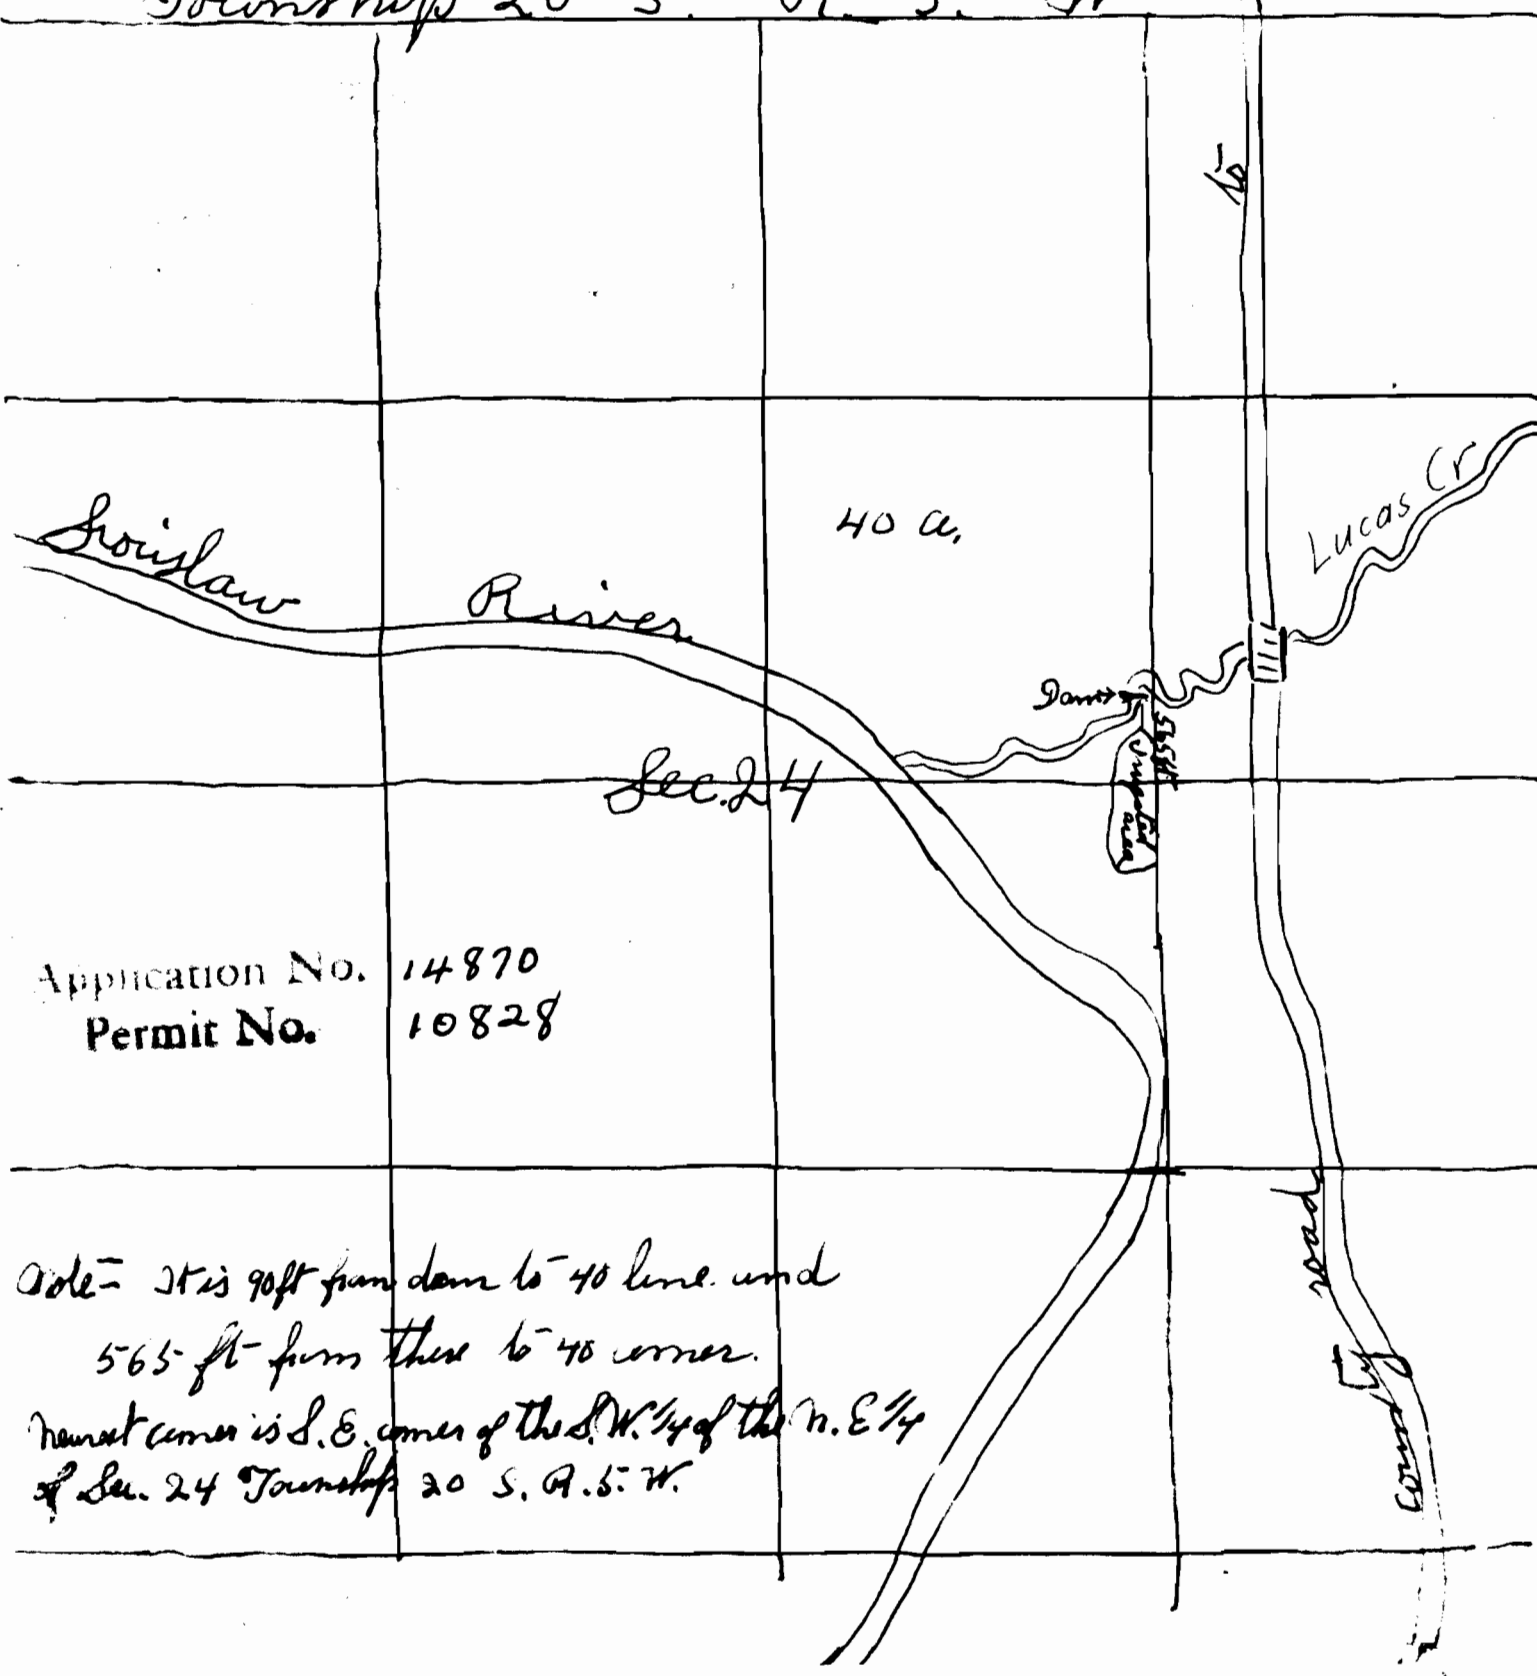

Application No. 14870
Permit No. 10828

Note - It is 90 ft from dam to 40 line and
565 ft from there to 40 corner.

Nearest corner is S.E. corner of the S.W. 1/4 of the N.E. 1/4
of Sec. 24 Township 20 S. R. 5. W.