


SECTION

TOWNSHIP 38 S, RANGE 8 W, W. M.

North

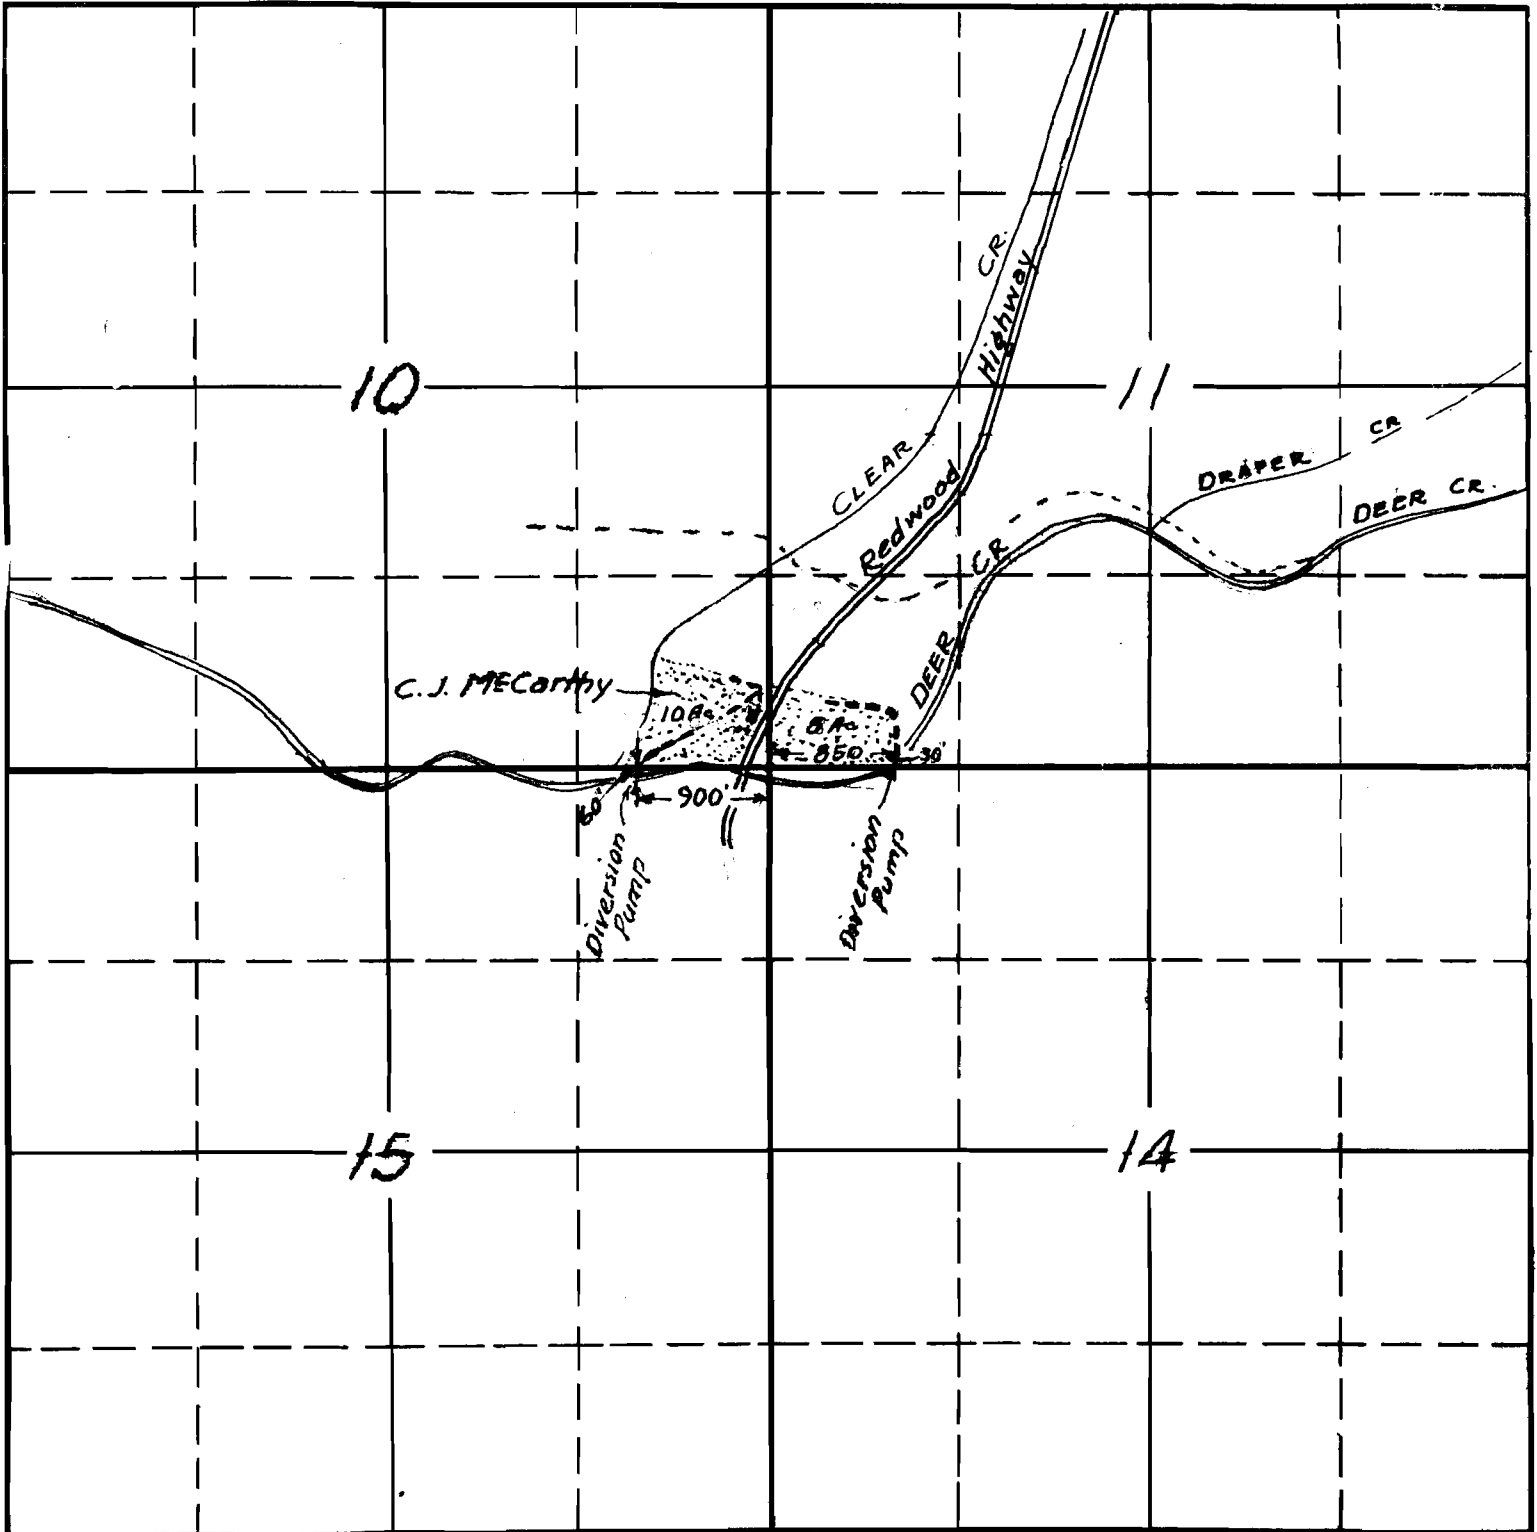

East

South

STATE ENGINEER
 REGISTERED
 MAR 25 1937
 SALEM, OREGON

APPLICATION No. 14889
 PERMIT No. 10836