


SECTION

TOWNSHIP 15, RANGE 2 E, W. M.

North

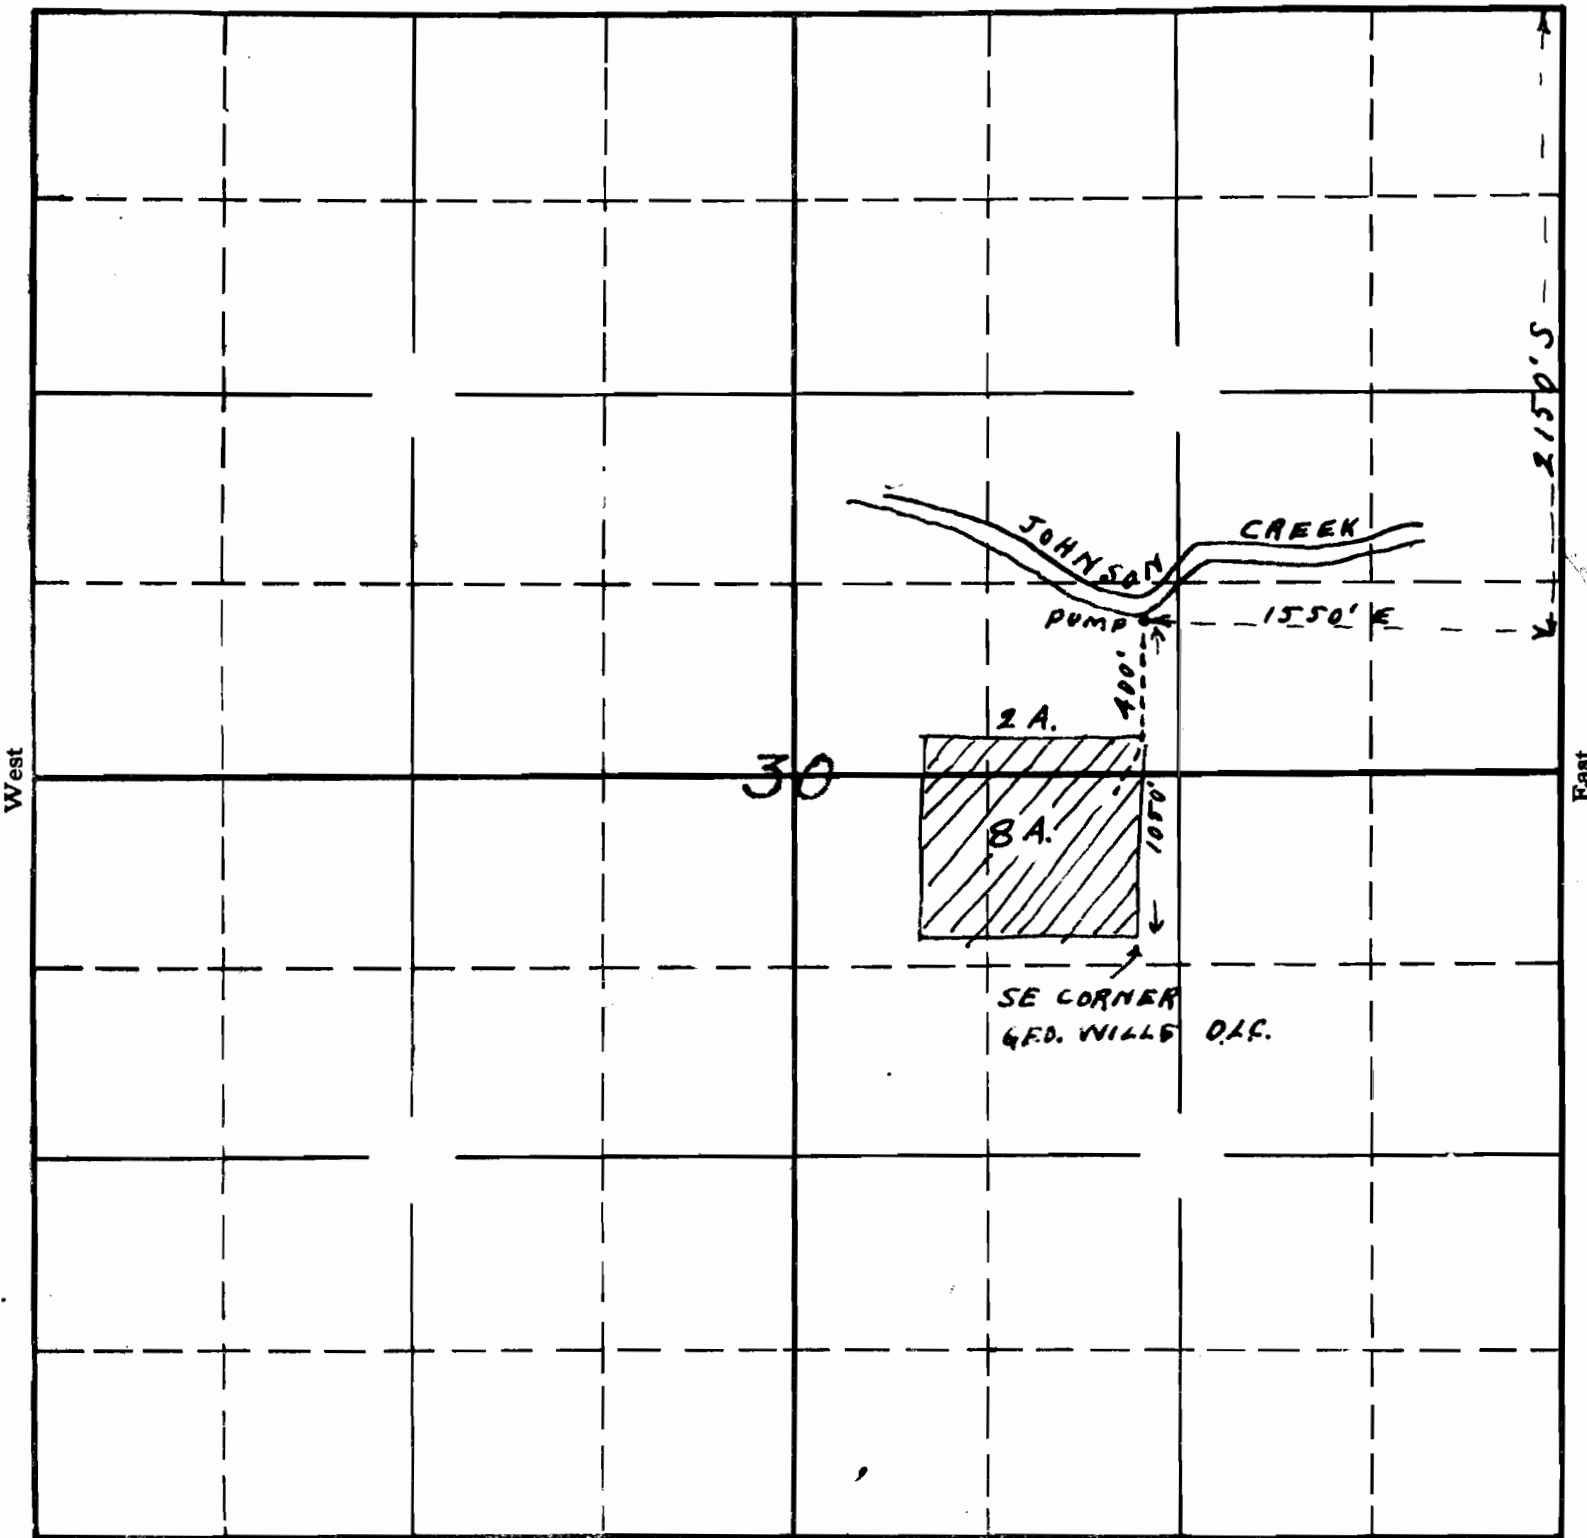

South

APPLICATION No. 14480  
PERMIT No. 10845

SE CORNER  
GEO. WILLS  
D.L.C.