


SECTION

TOWNSHIP 185, RANGE 44 SE, W. M.

North

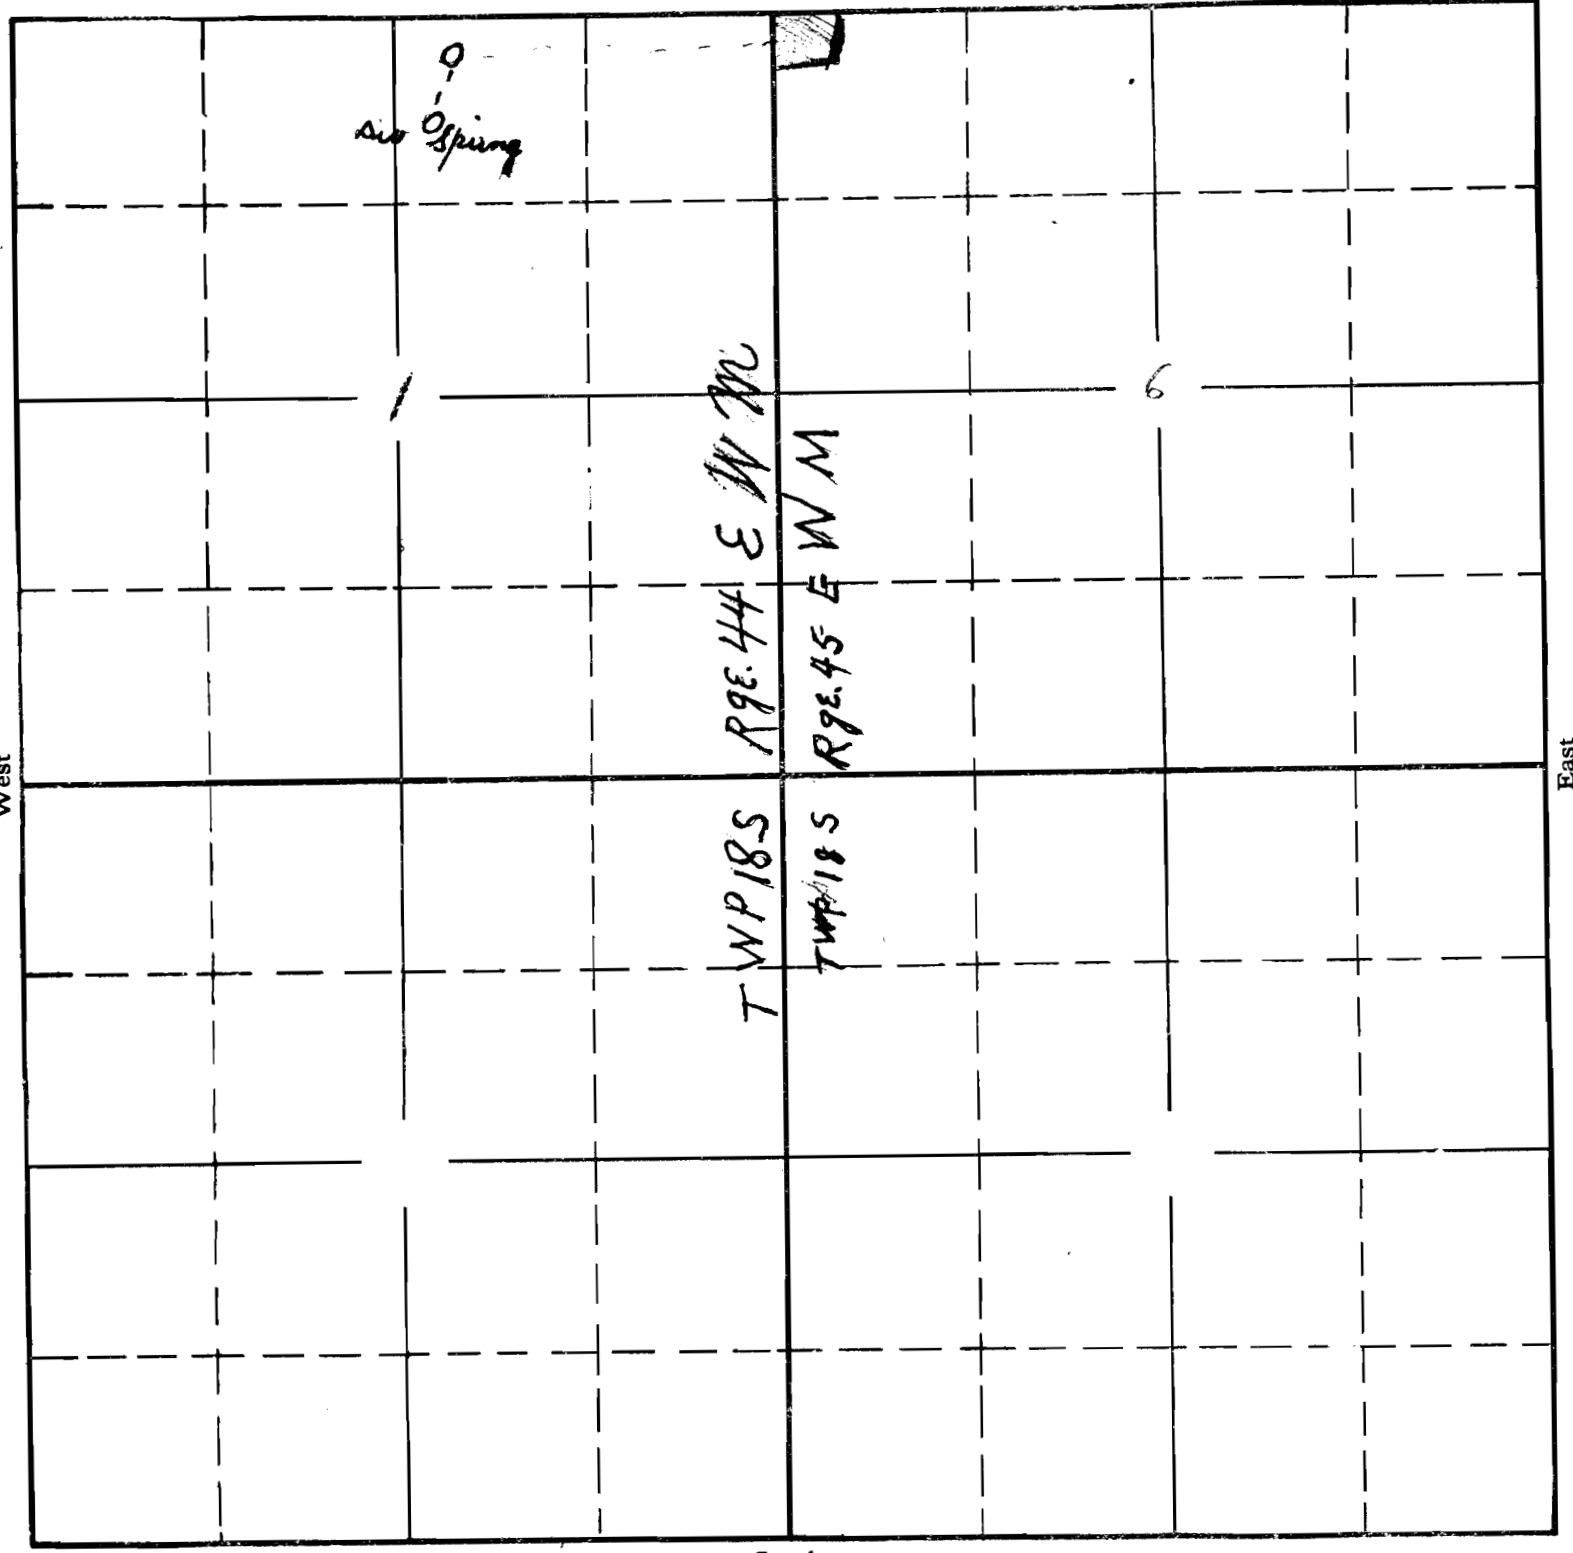

South

RECEIVED
SEP 13 1934

STATE ENGINEER
SALEM, OREGON

APPLICATION No. 14874
PERMIT No. 10850