


# T. 5S. R. 7W.W.M.

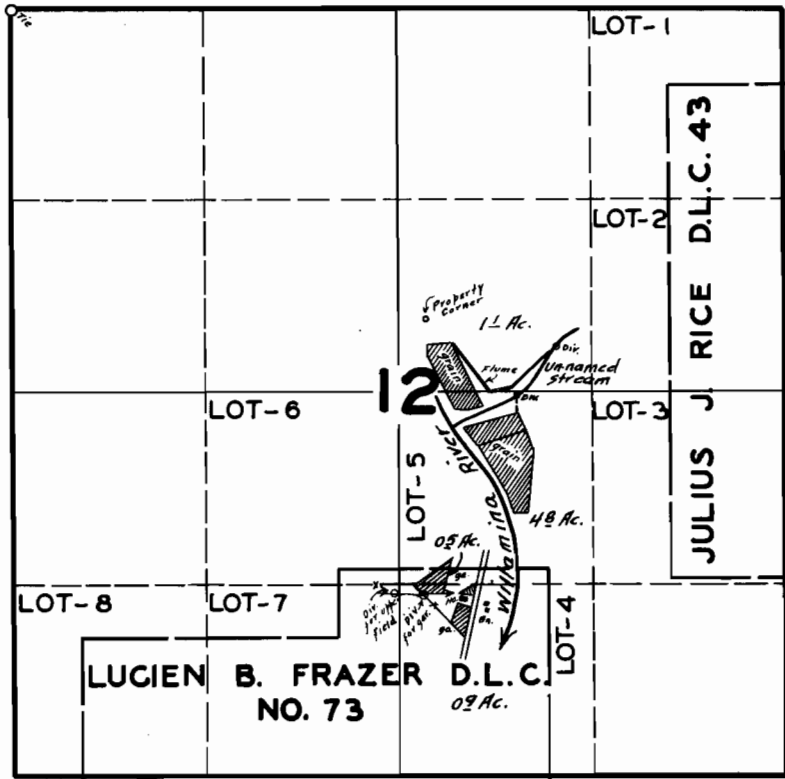

MAP SHOWING LANDS ACTUALLY  
IRRIGATED UNDER PERMIT NO. 10862  
SURVEYED MAR. 1 1946 BY J.E.B.