


NORTH

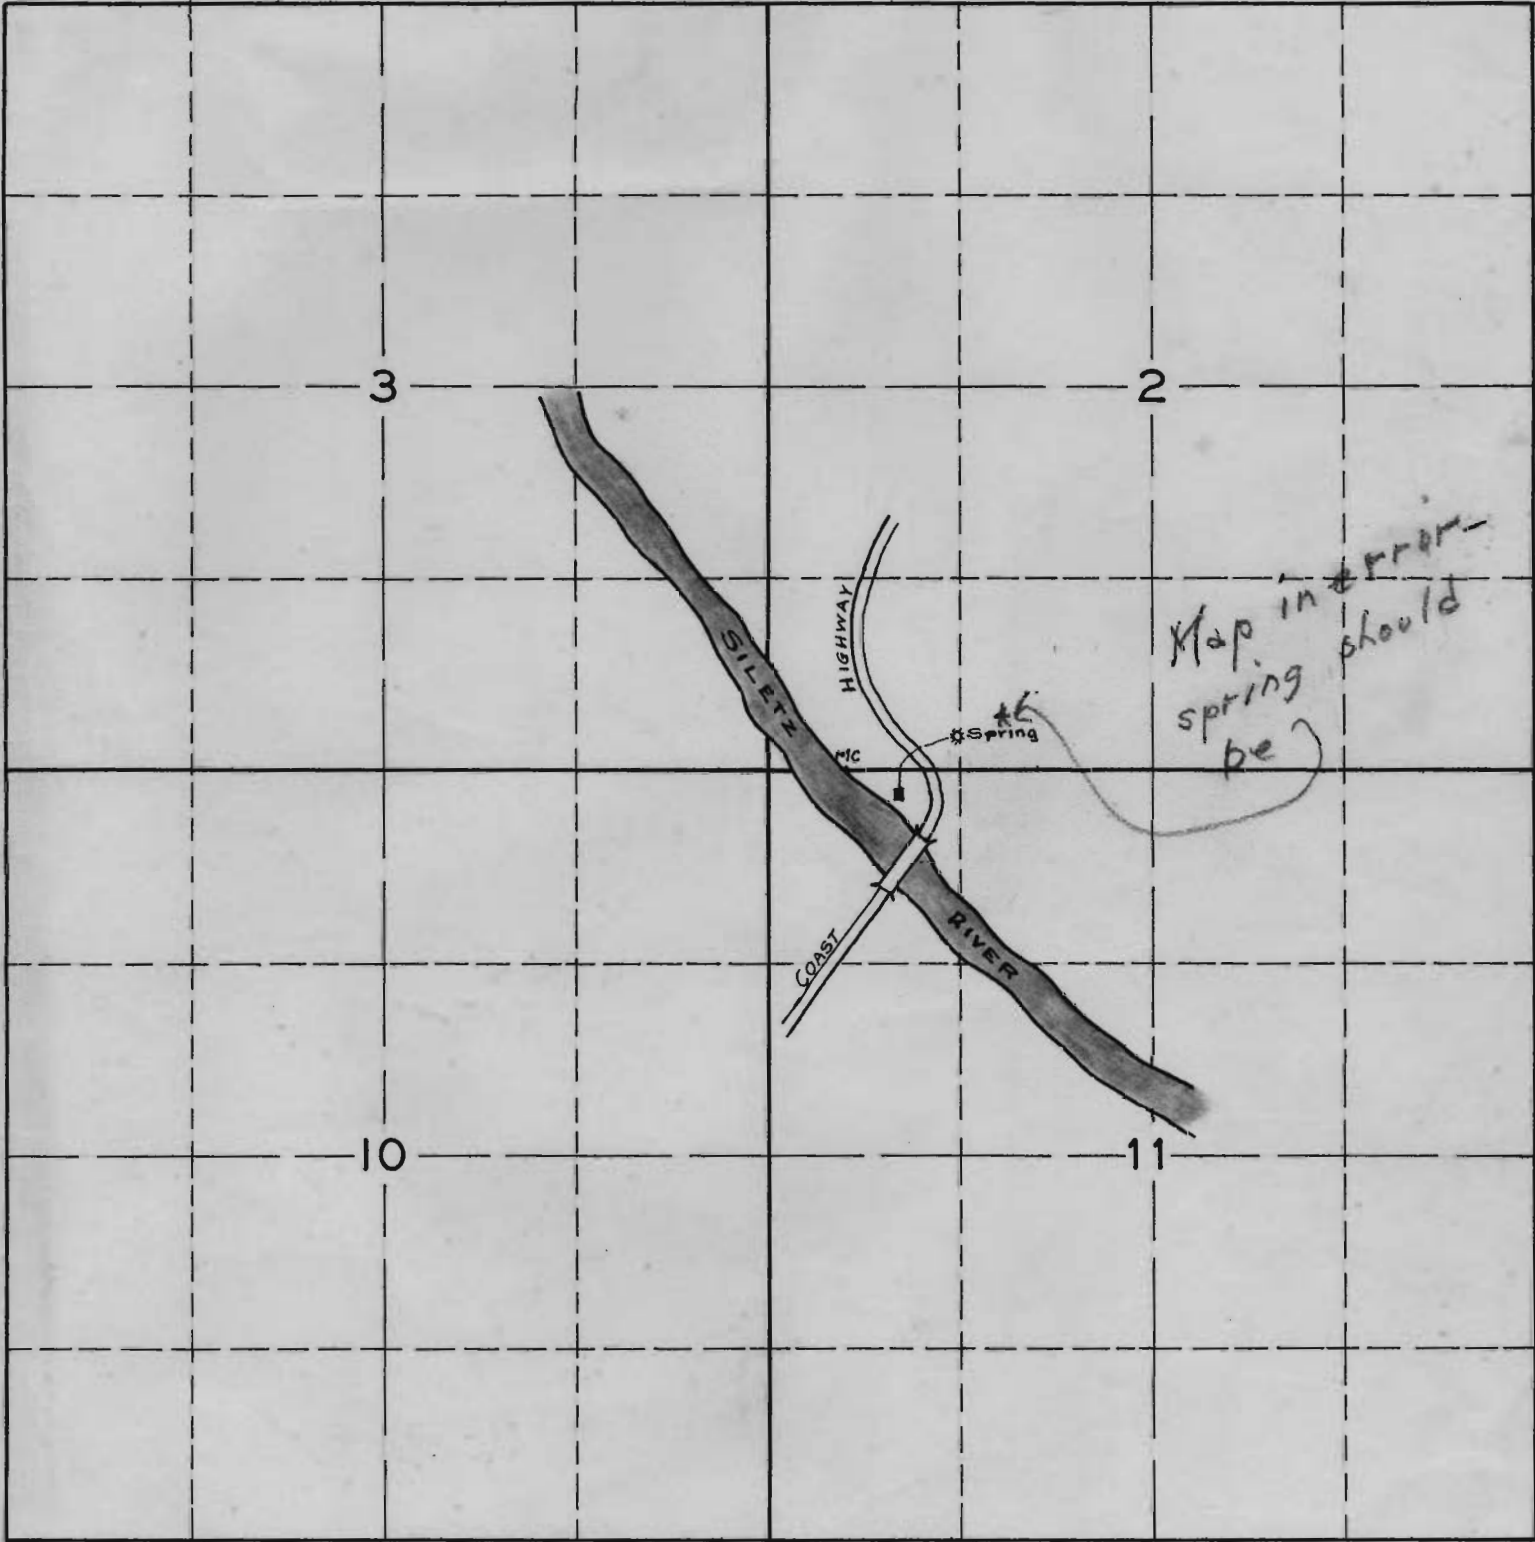

TOWNSHIP 8 SOUTH, RANGE 11 WEST. W.M.

MAP TO ACCOMPANY APPLICATION NO. 14919
PERMIT NO. 10877

TRACED FROM ORIGINAL MAP SUBMITTED BY APPLICANT.