
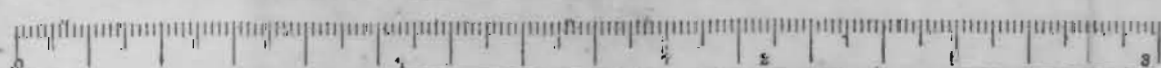


Township 35;

Range 3 N. W.M.

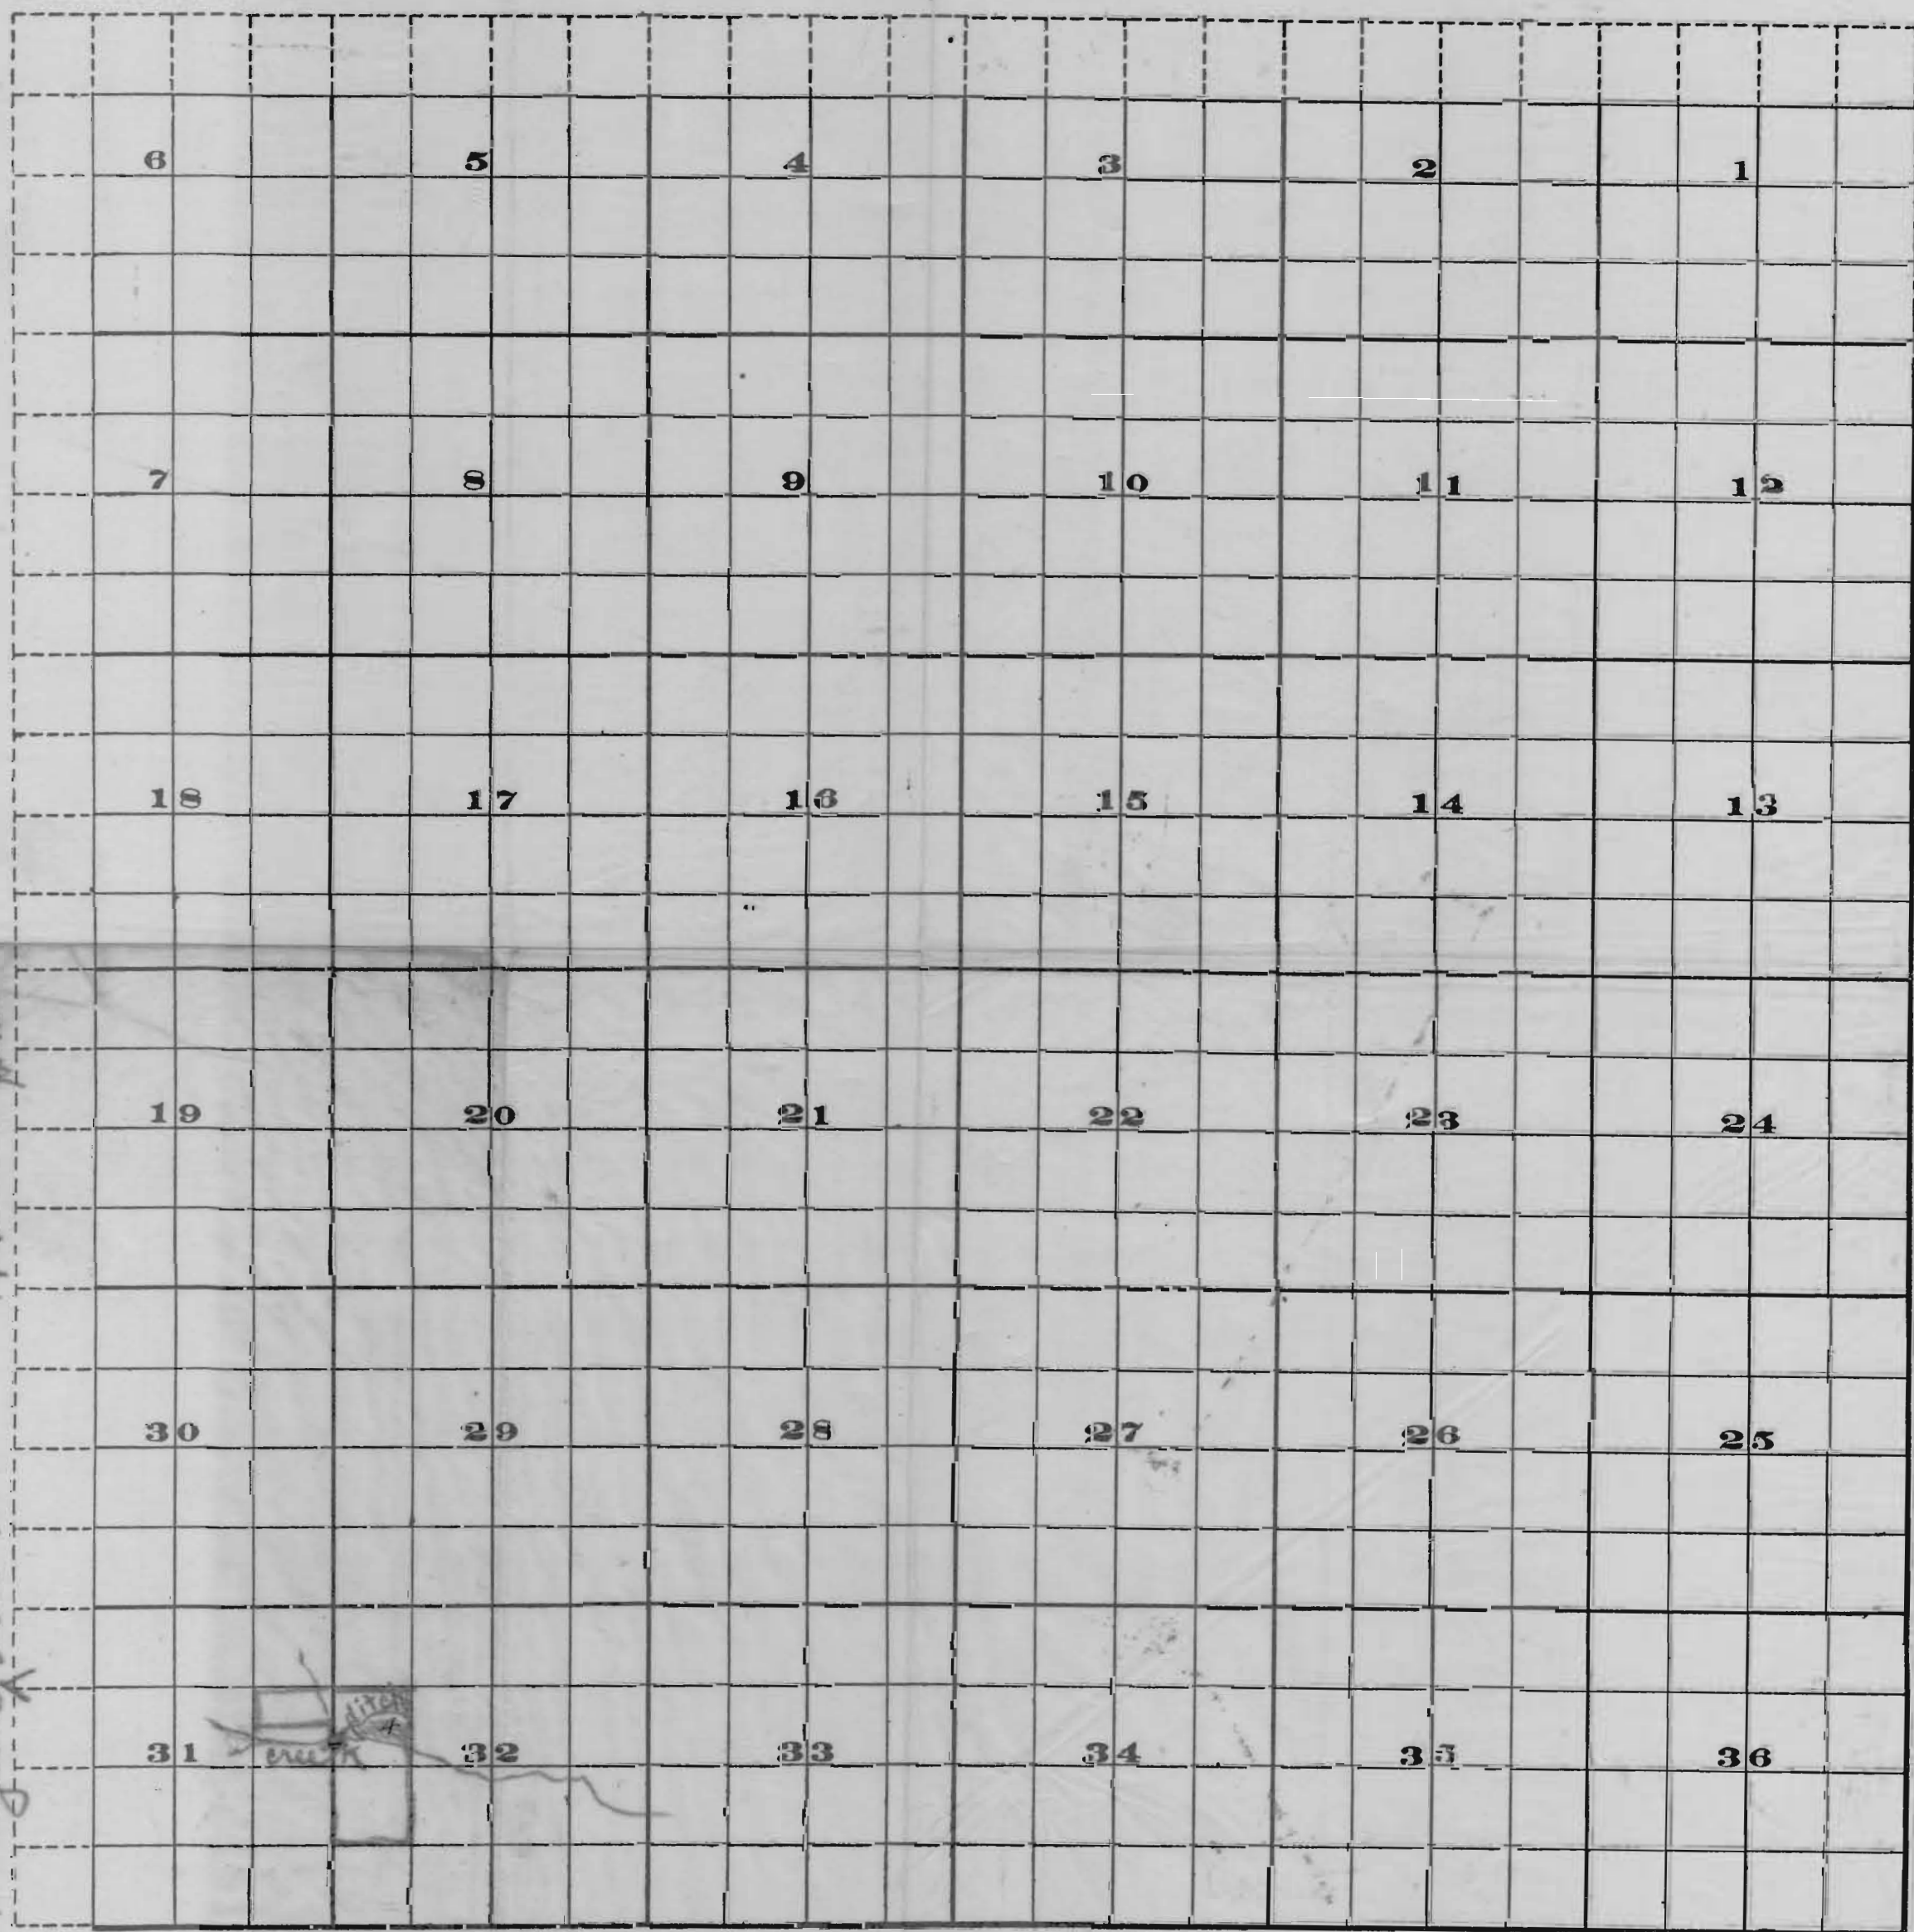

Scale of Feet.

FROM OFFICE OF THE STATE ENGINEER, SALEM, OREGON

The water is taken out of the creek at the west line of

the S.W. 1/4 of the N.W. 1/4 Sec. 32, Tow 3 R. 3 W. about 1350 ft from the S.W. corner of same and water is to irrigate this same 1/4 Sec.

OFFICE OF STATE ENGINEER
RECEIVED
FEB 17 1912
SALEM, OREGON

Application No. 2029
Permit No. 1090

2029

2029

2029