
TOWNSHIP 45, RANGE 3 E, W. M.

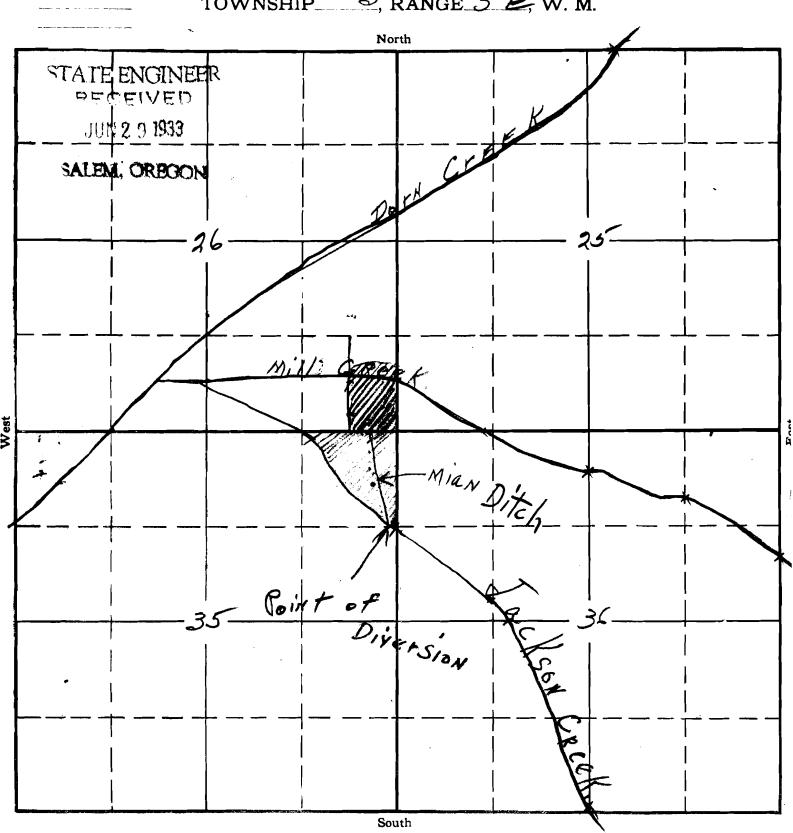

APPLICATION No. 15014
PERMIT No. 10944