


SECTION

TOWNSHIP 35 S, RANGE 6 W, W. M.

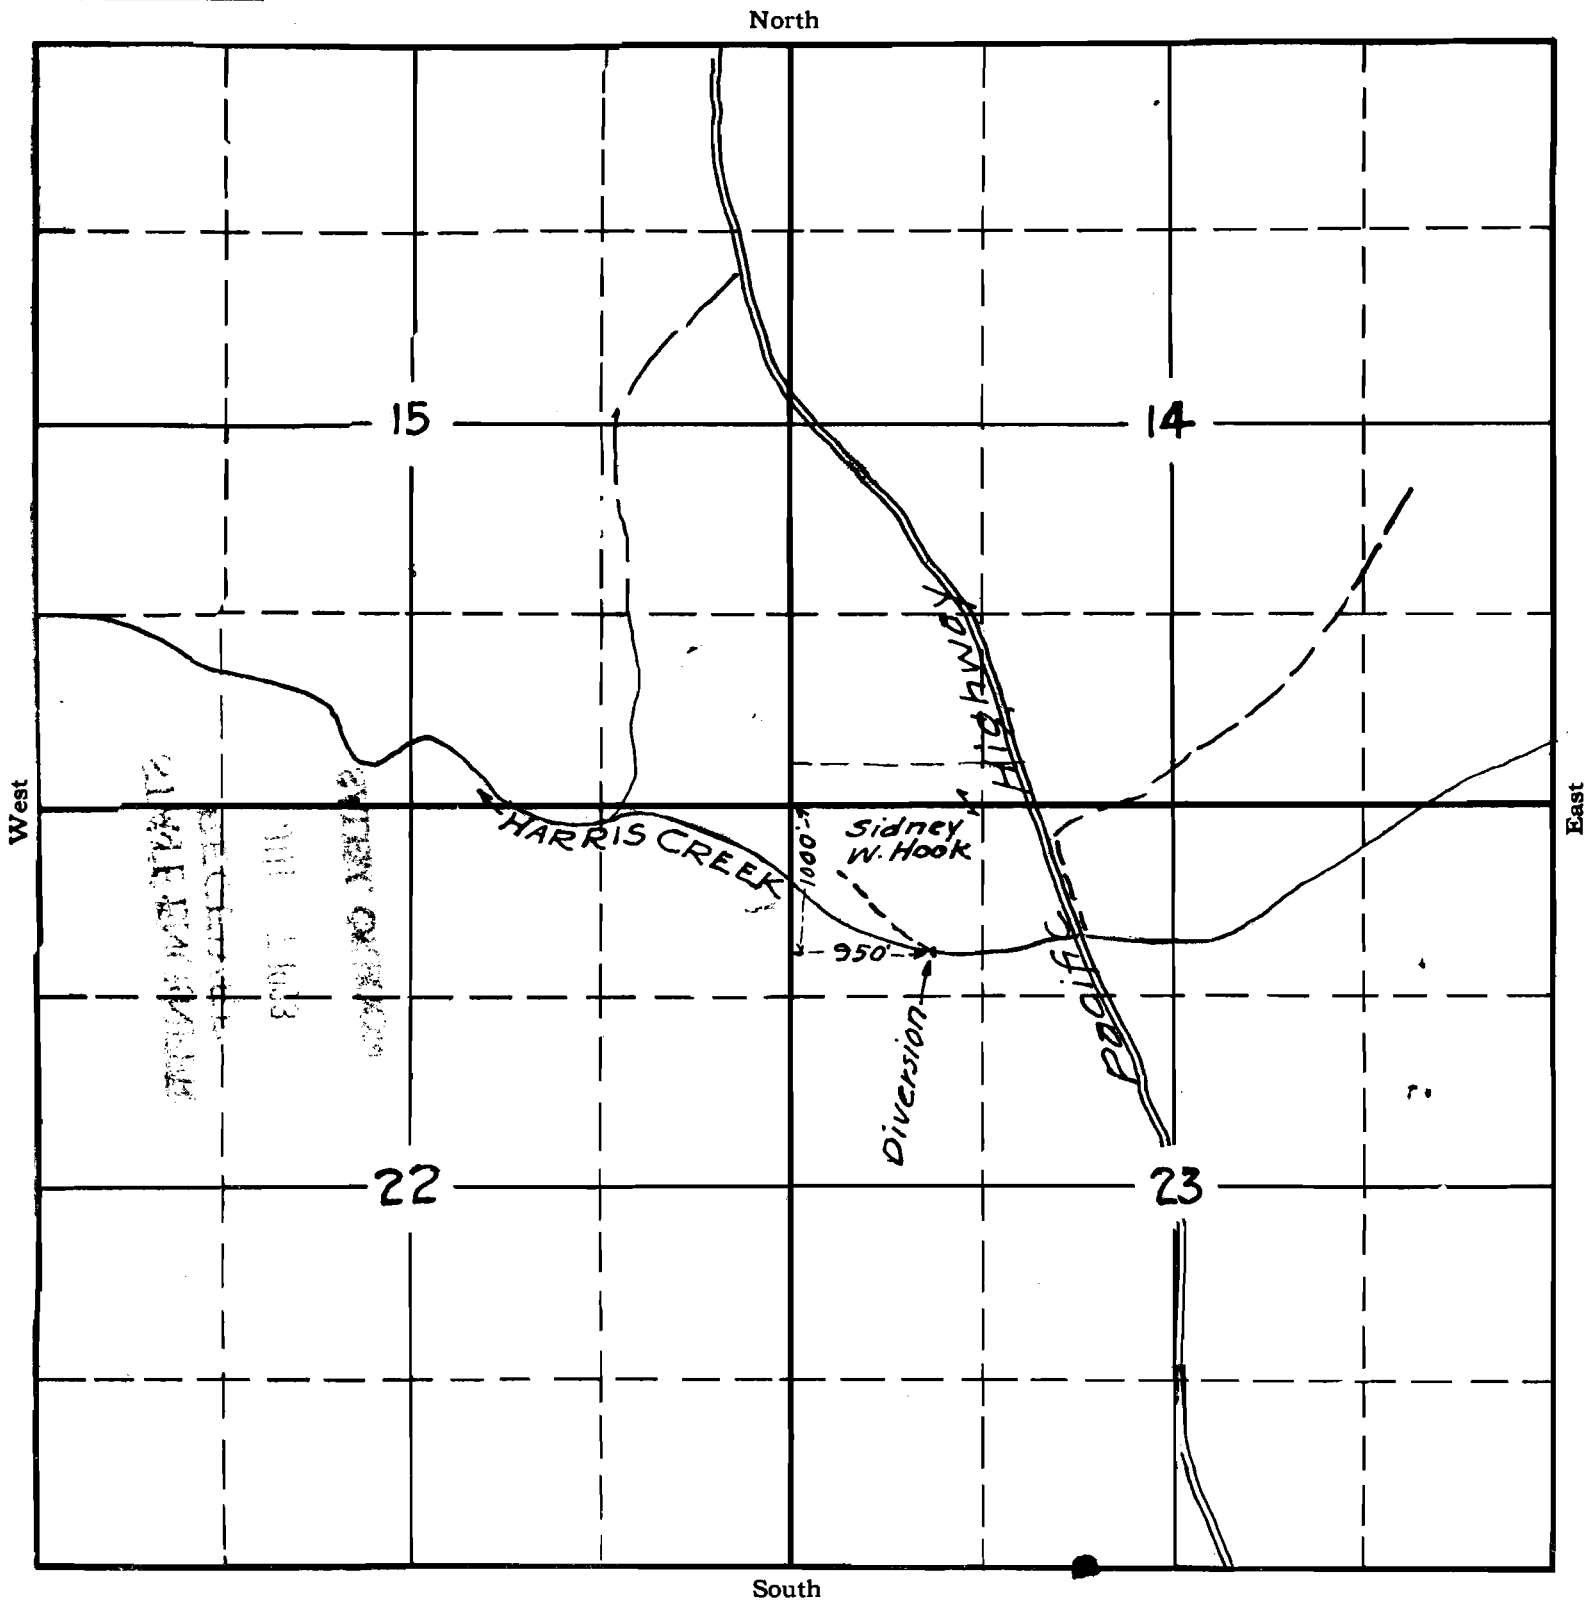

APPLICATION No. 15028  
PERMIT No. 10952