


SECTION

\_\_\_\_\_  
\_\_\_\_\_  
\_\_\_\_\_  
\_\_\_\_\_

TOWNSHIP 25, RANGE 2E, W. M.

North

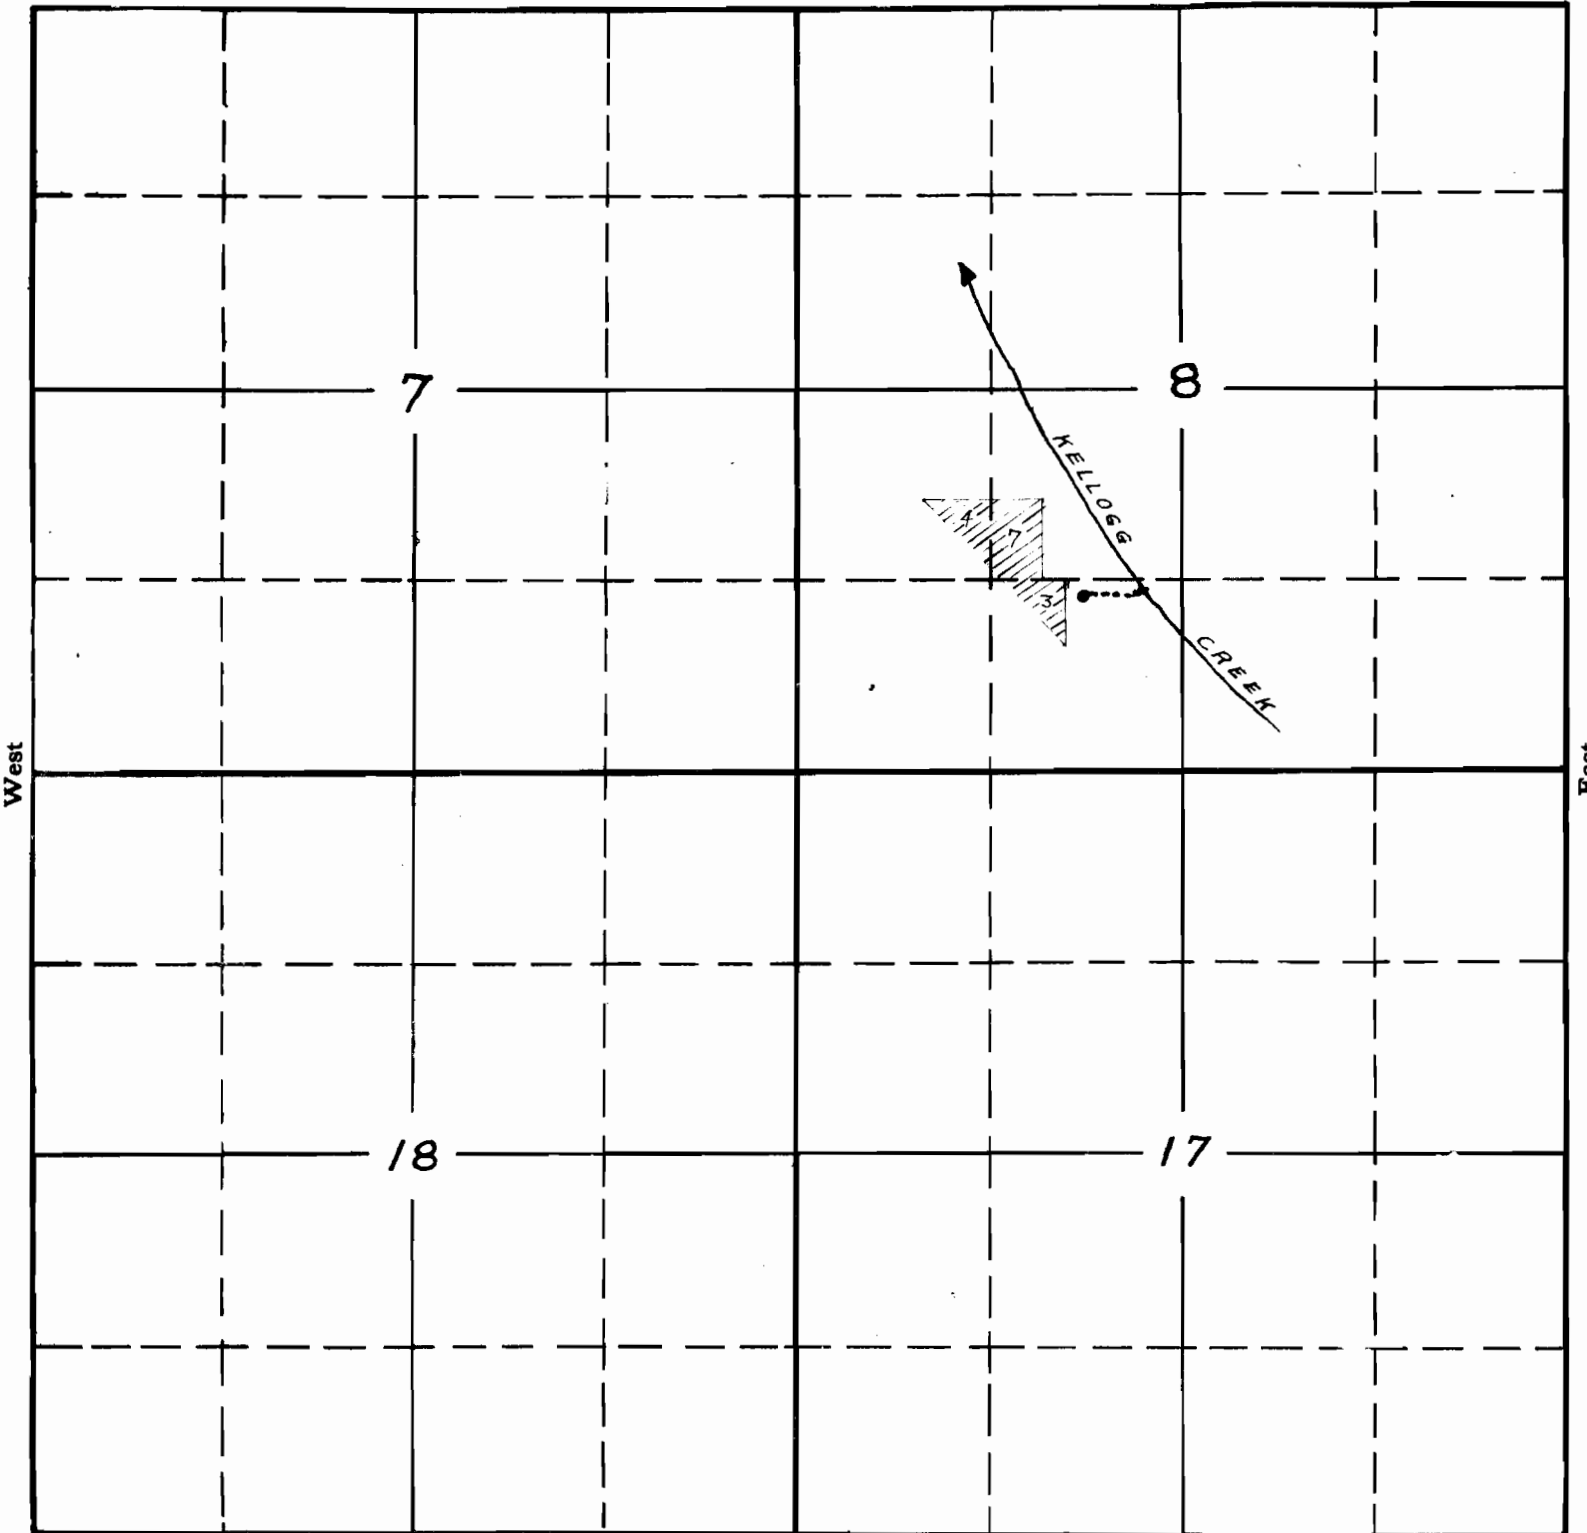

West

East

South


APPLICATION No. 15057

PERMIT No. 10965

SECTION

TOWNSHIP 25, RANGE 2E, W. M.

North

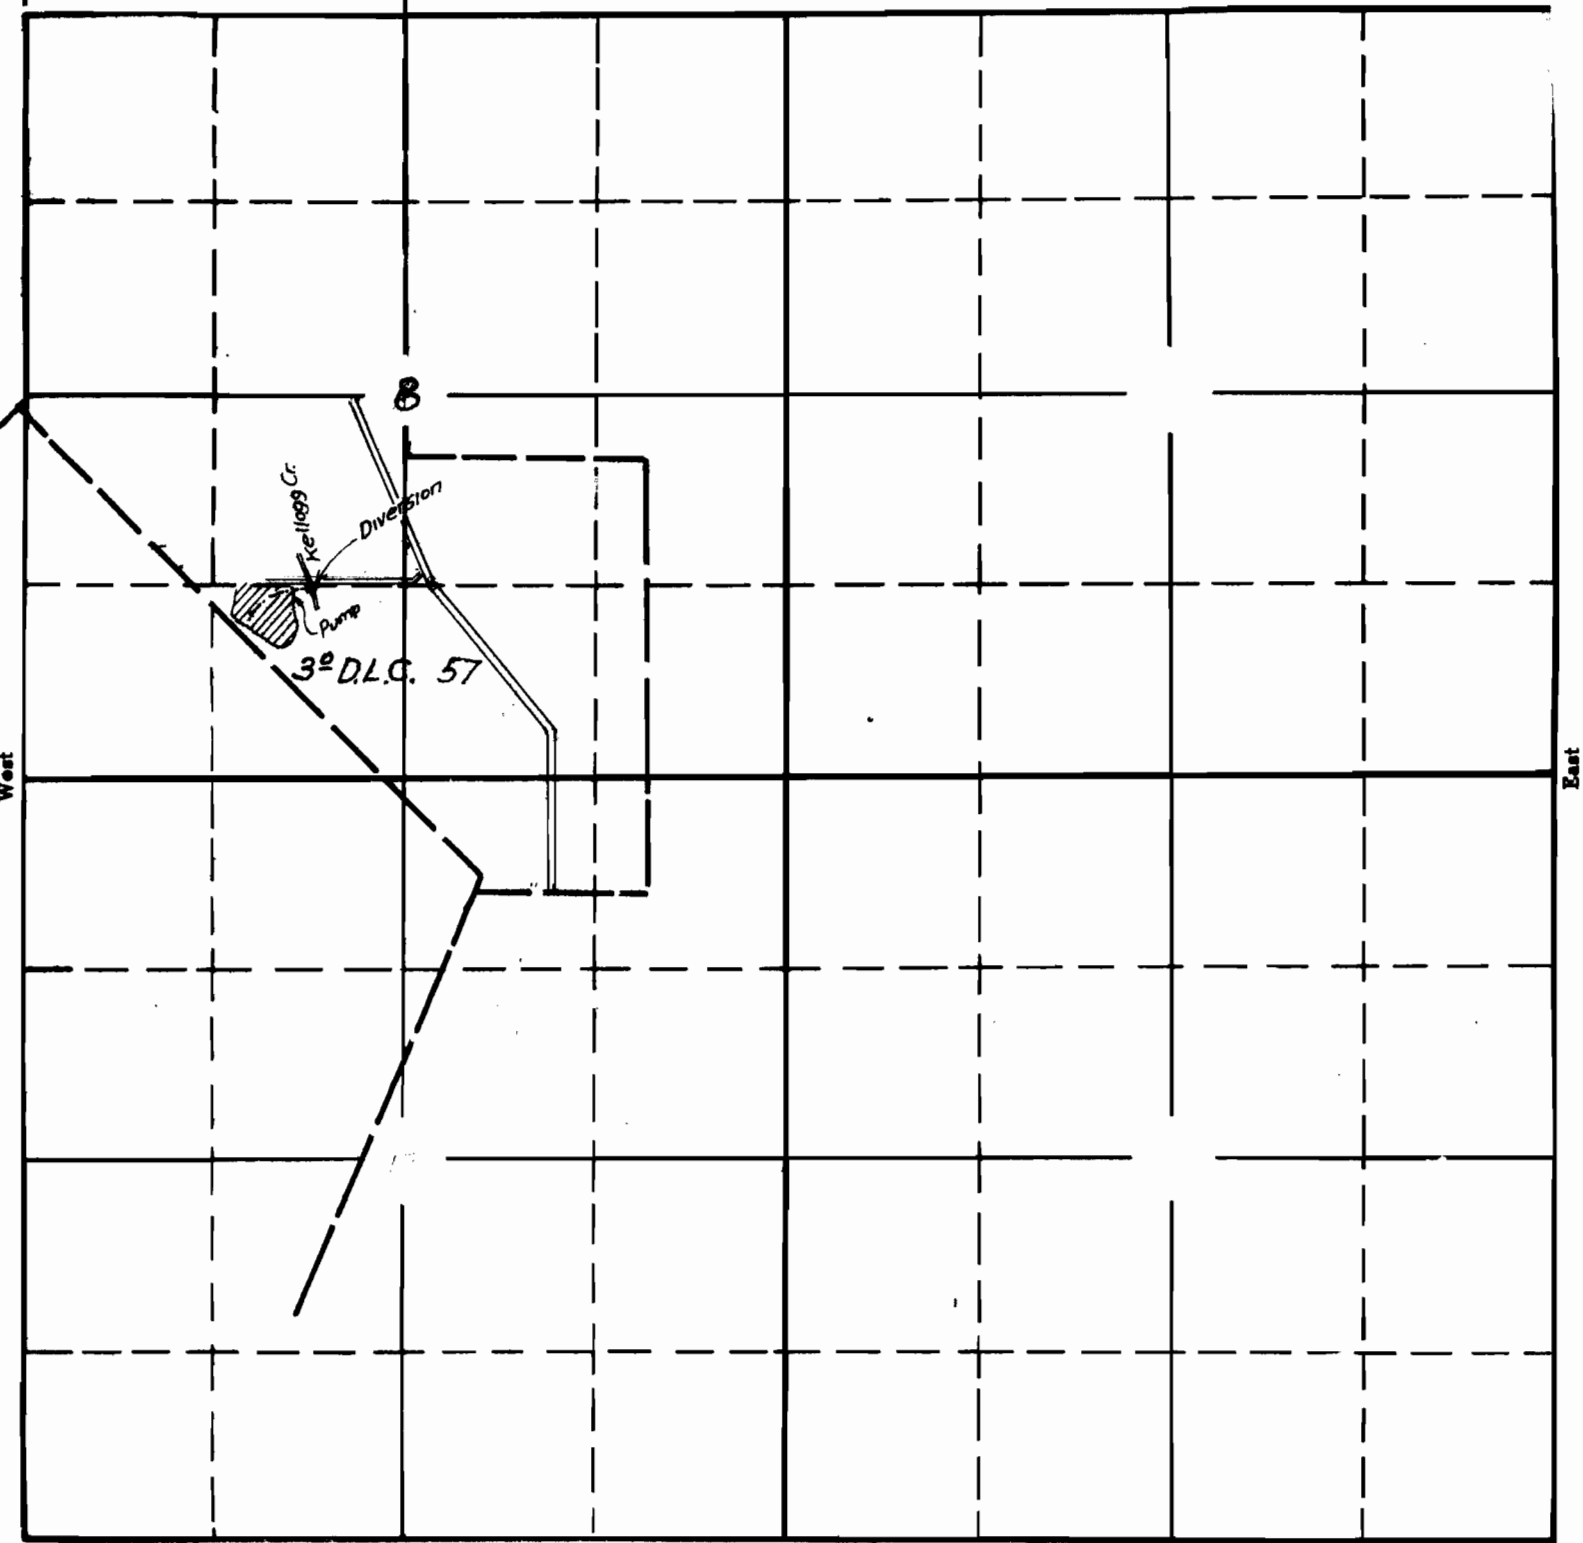

South

APPLICATION No. 15057

PERMIT No. 10965

*filed with permit*