


SECTION

22

27

TOWNSHIP 8^S, RANGE 6^W, W. M.

North
22

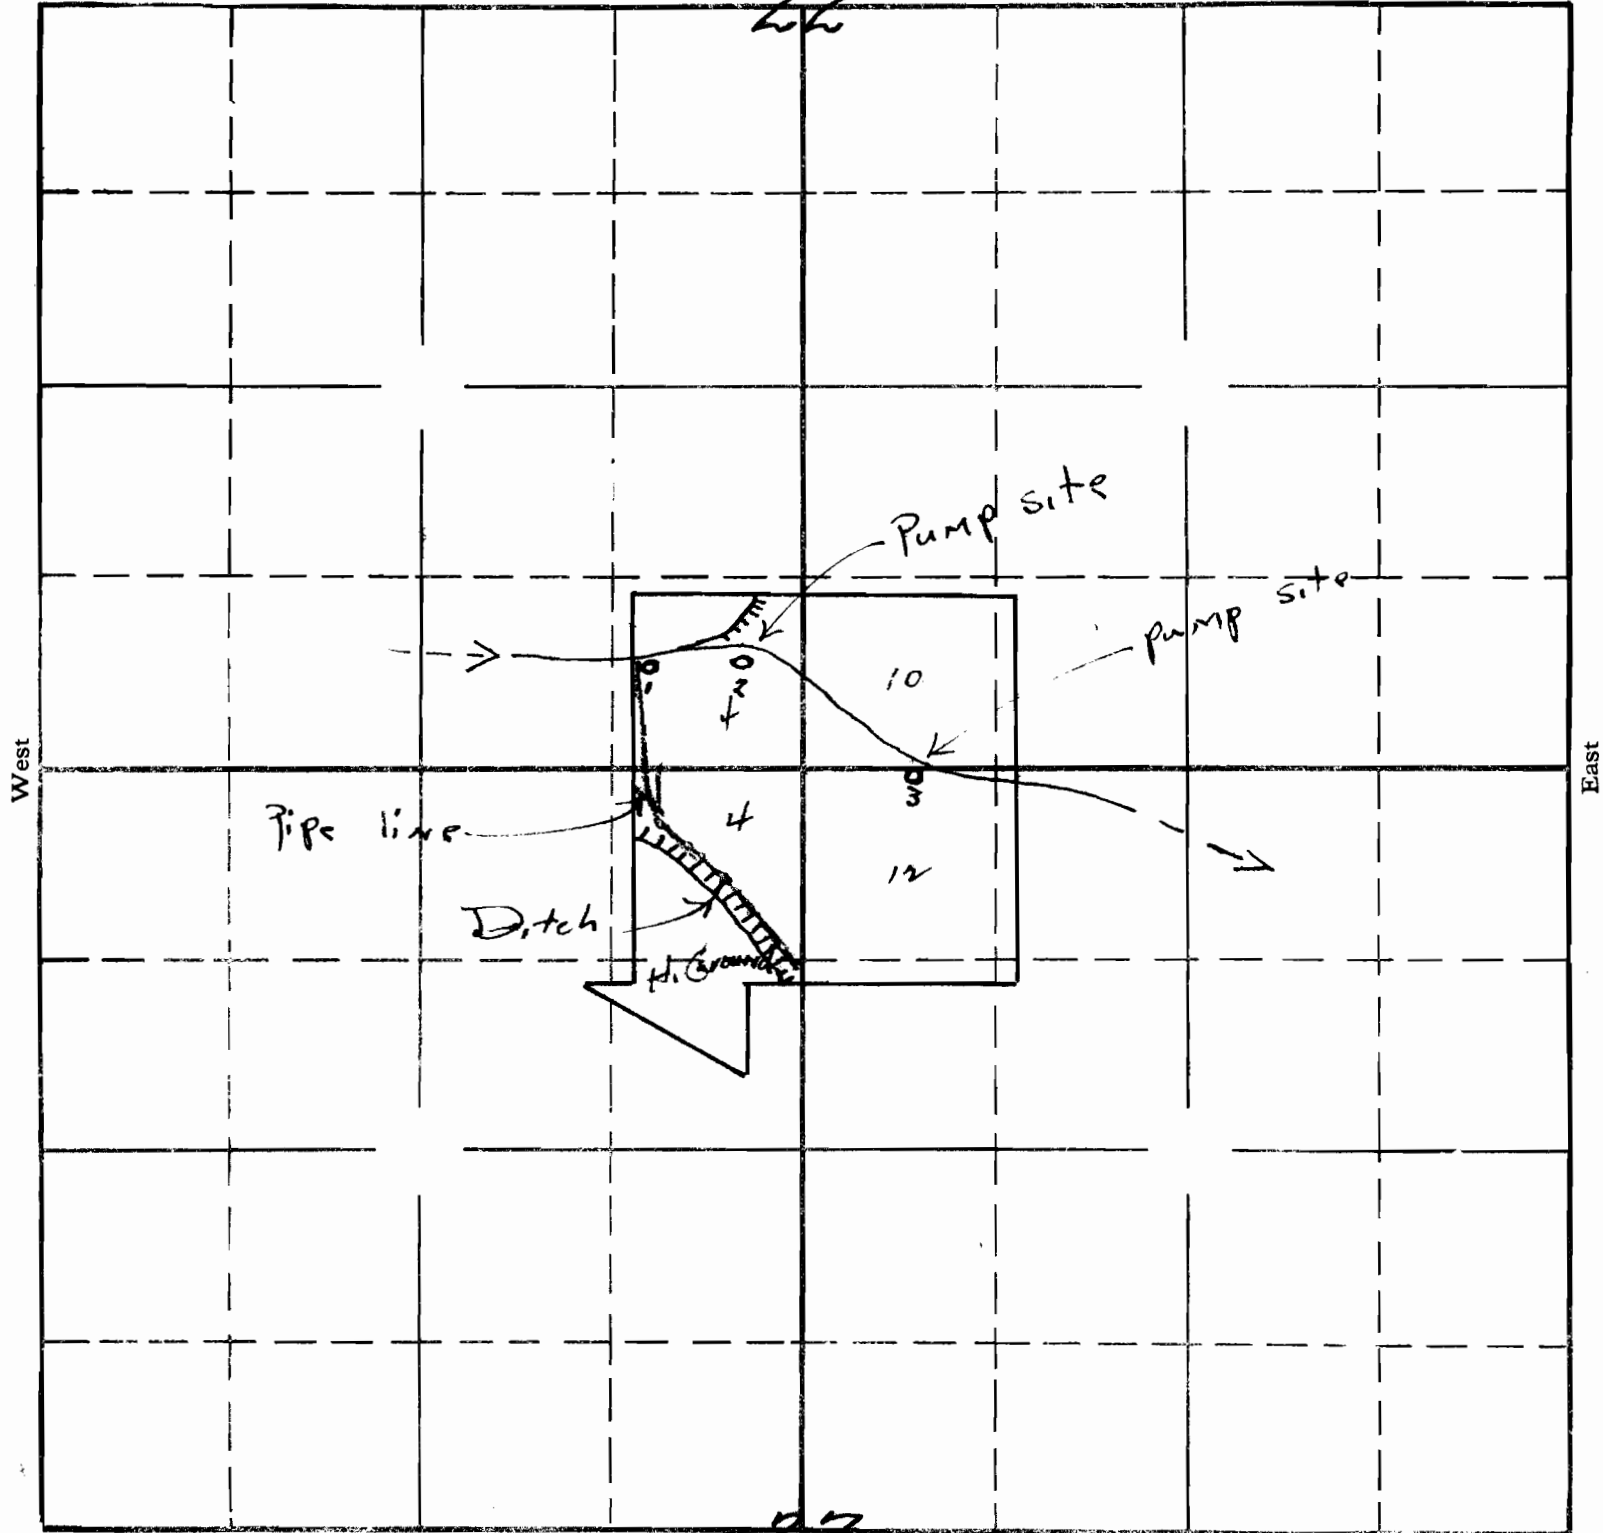


South
27

APPLICATION No. 15063

PERMIT No. 10969

SECTION

TOWNSHIP 8S, RANGE 6W, W. M.

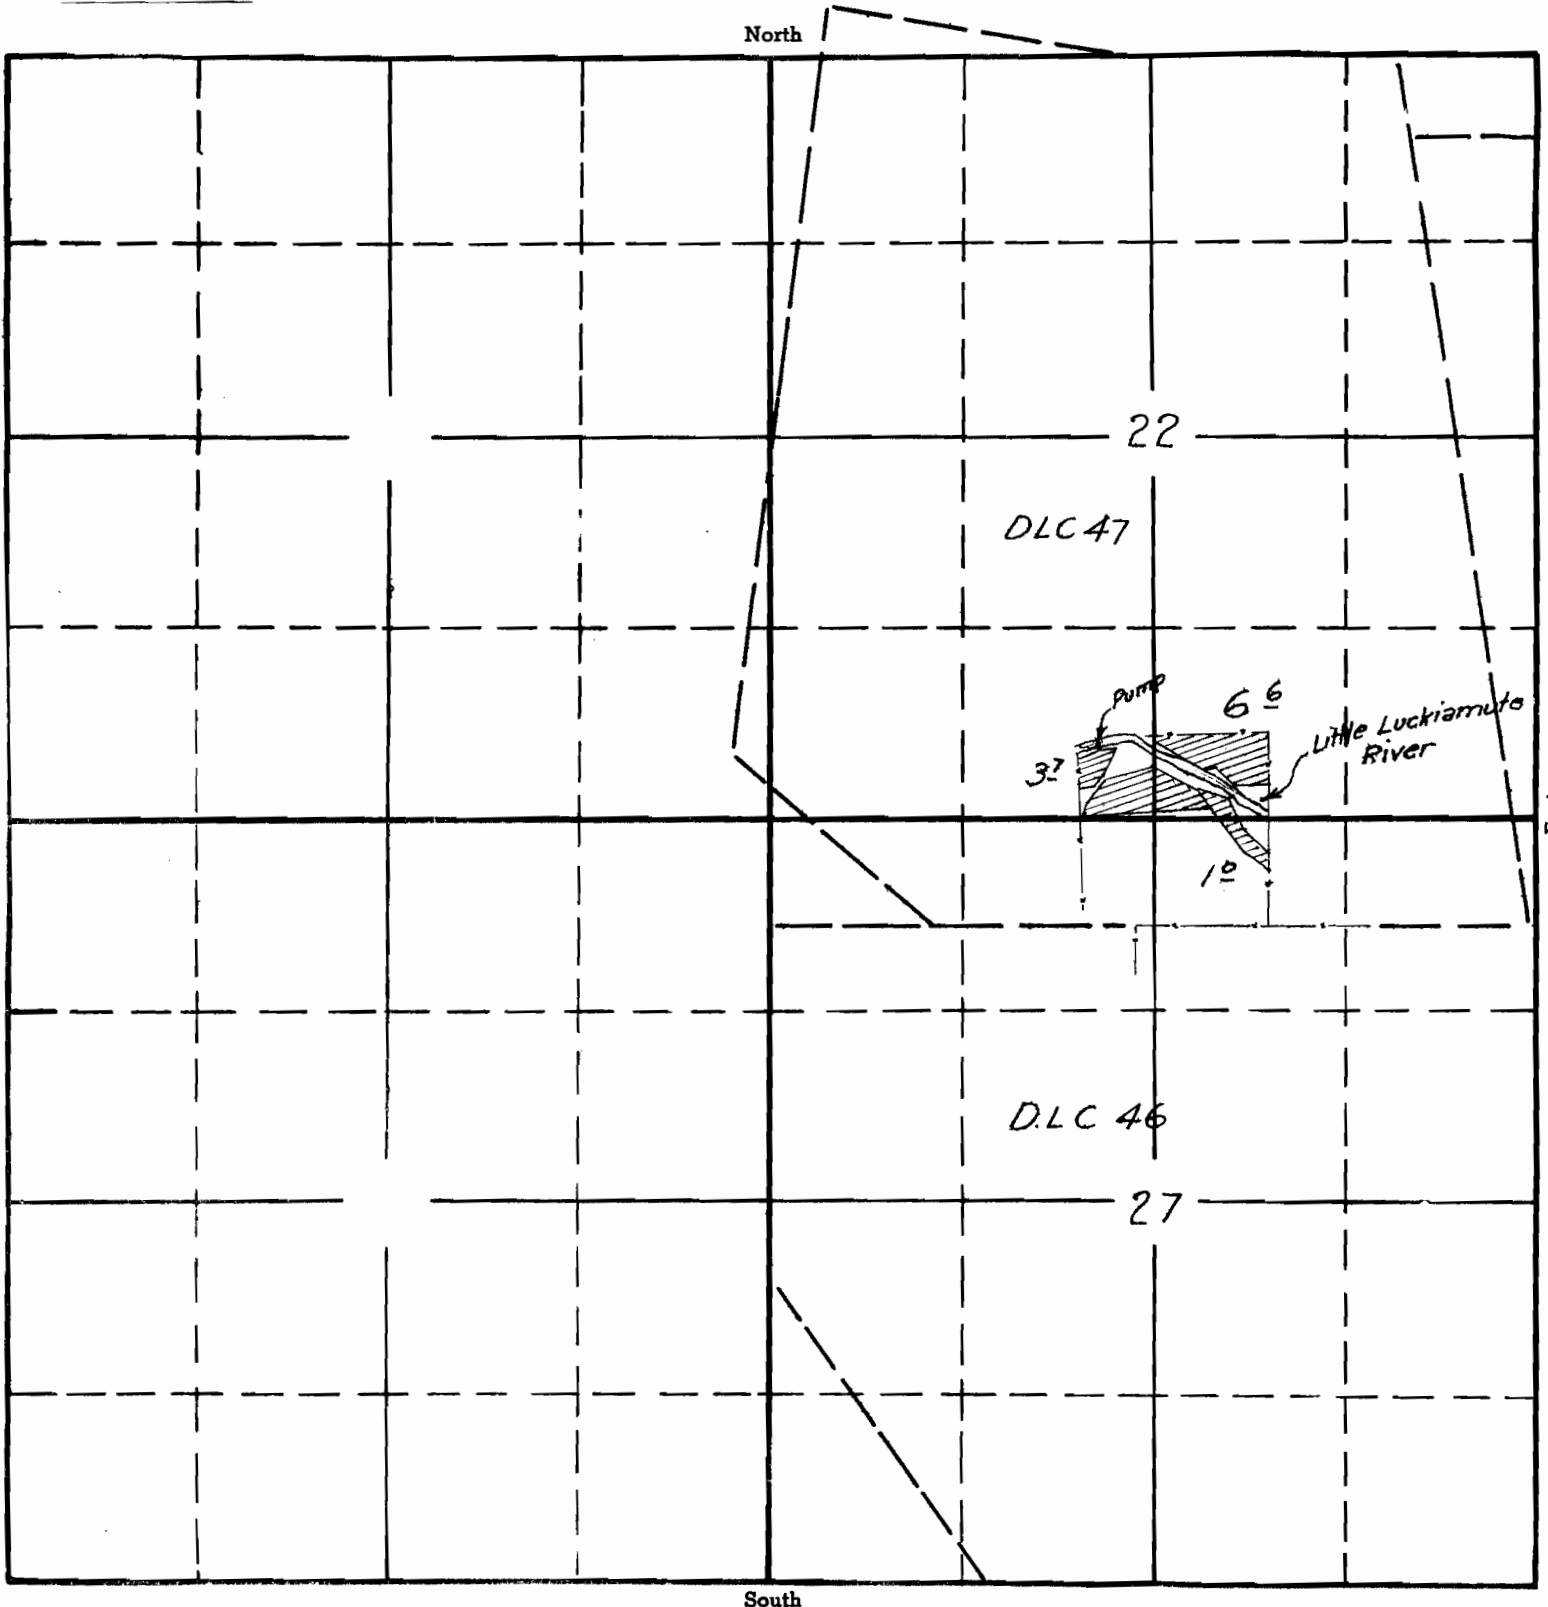

APPLICATION No. 15063

PERMIT No. 10969