


RECEIVED  
 AUG 29 1933  
 STATE ENGINEER  
 SALEM, OREGON

I, Henry L. Melton, of Baker, Oregon  
 do hereby certify that this map was made from notes taken during  
 an actual survey made by me on August 1st. to 4th., 1933  
 and that it correctly represents the works described in the  
 accompanying application, together with the location of streams  
 and other ditches in the immediate vicinity.

Henry L. Melton  
 Registered Professional Engineer.

Oregon No. 1337  
 March 25, 1927.

Scale 1 inch = 500 feet.

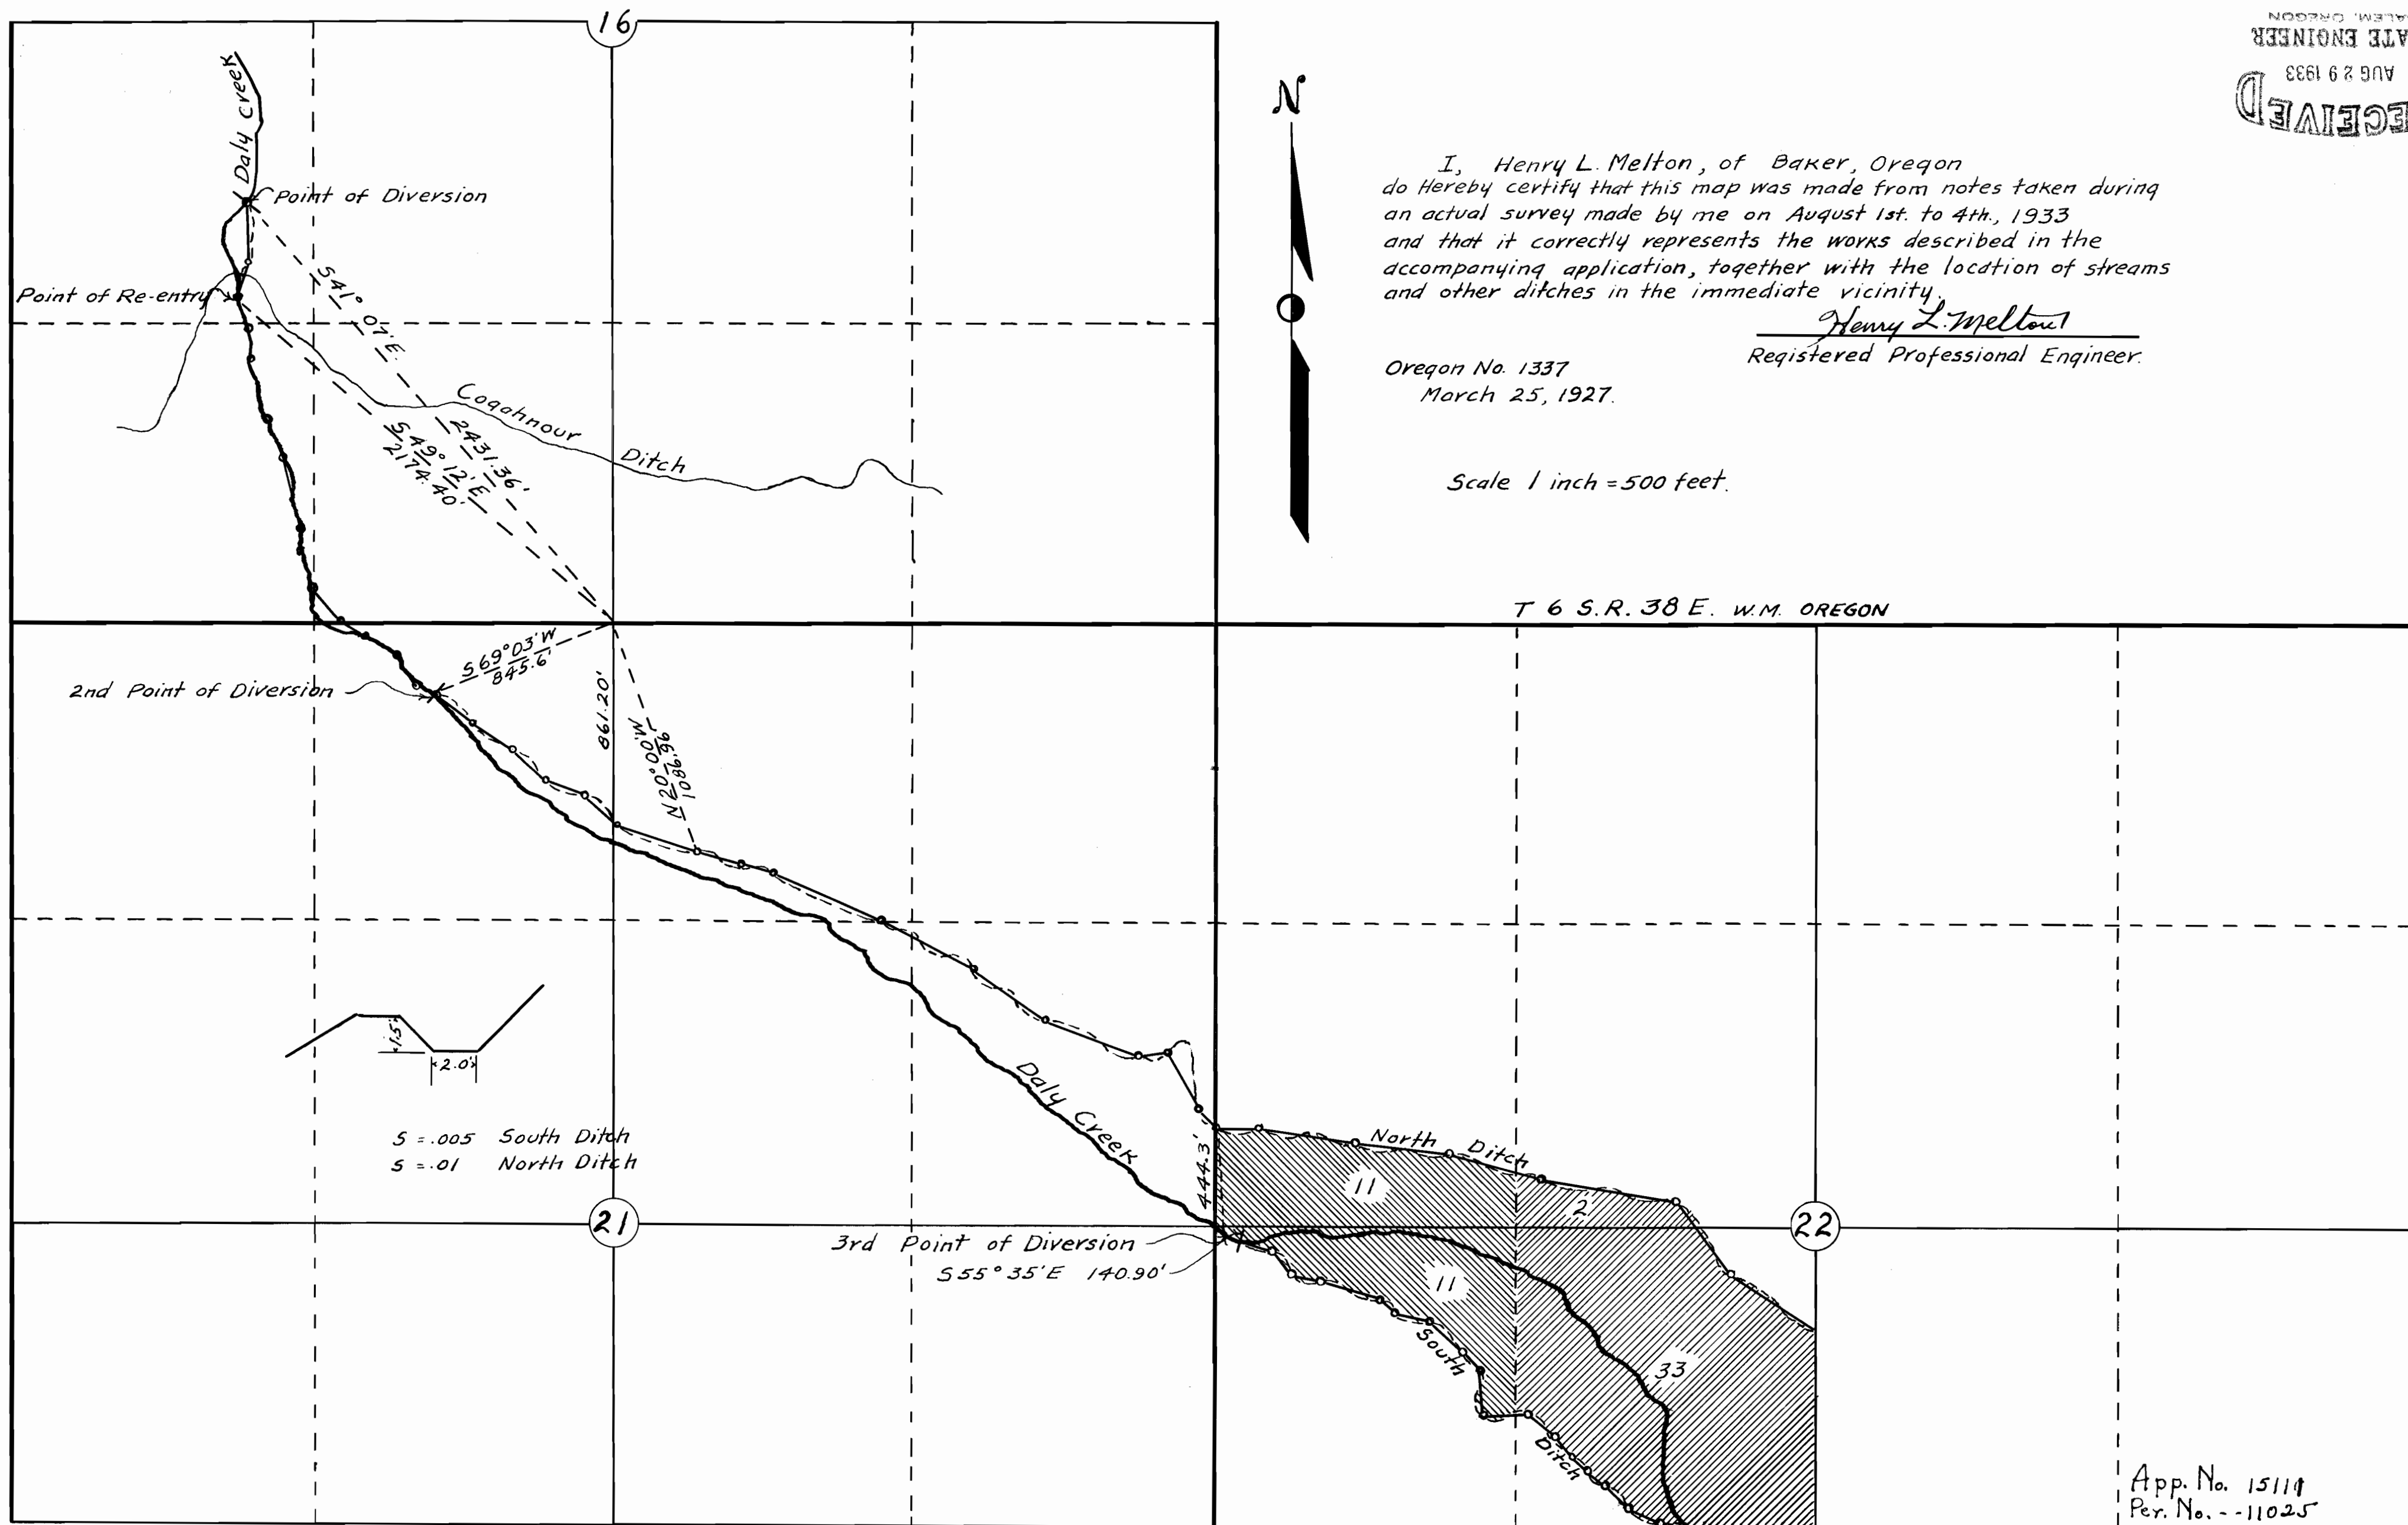

App. No. 15114  
 Per. No. - 11025