


TOWNSHIP 21S, RANGE 4W, W. M.

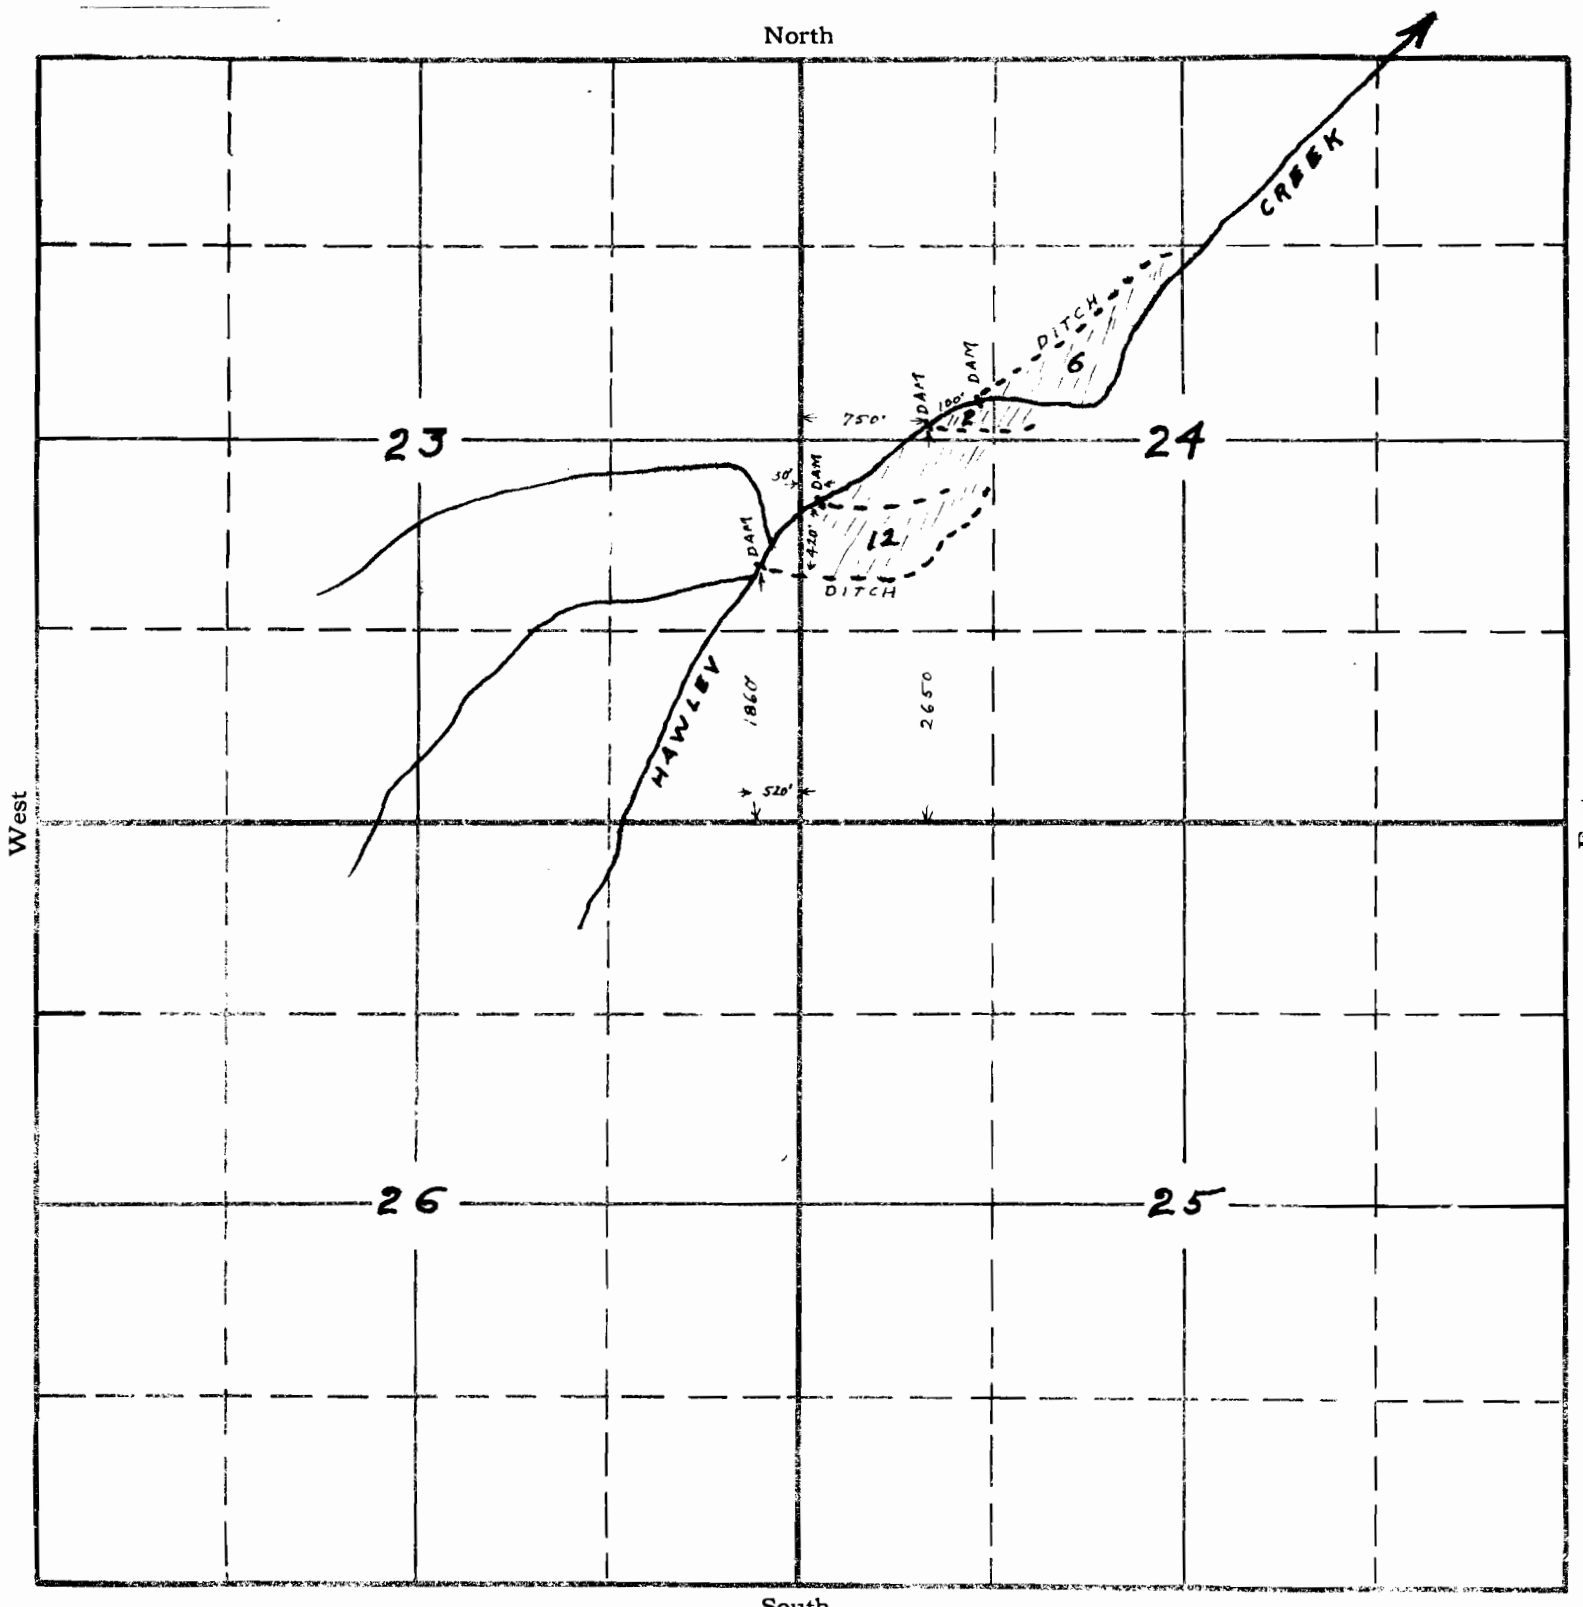

Copied from applicant's sketch - 9/26/33.


APPLICATION No. 15112

PERMIT No. 11027

SECTION

TOWNSHIP 21 S, RANGE 4 W., W. M.

North

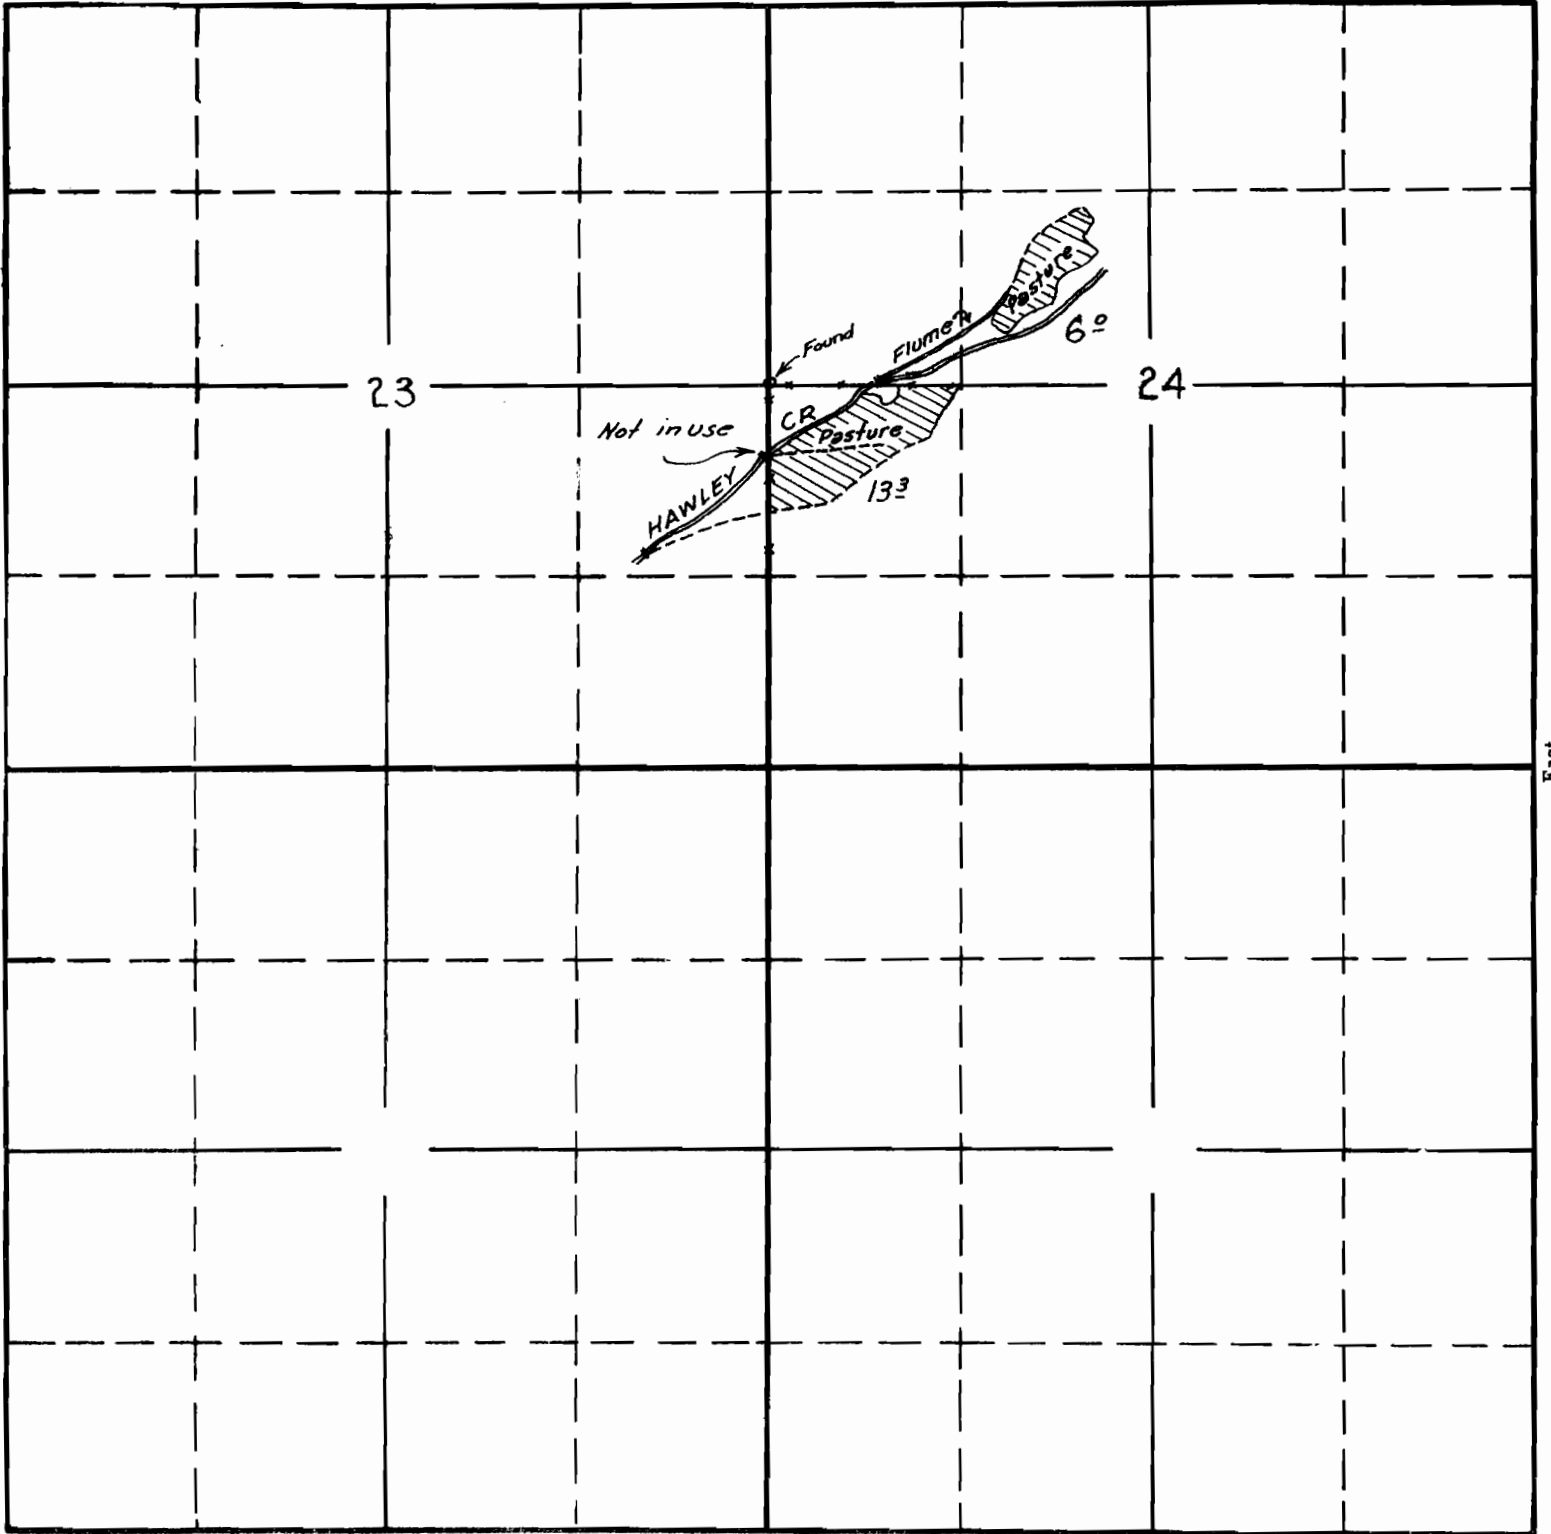

APPLICATION No. 15112

PERMIT No. 11027