


TOWNSHIP 13-5, RANGE 10-W, W. M.

North

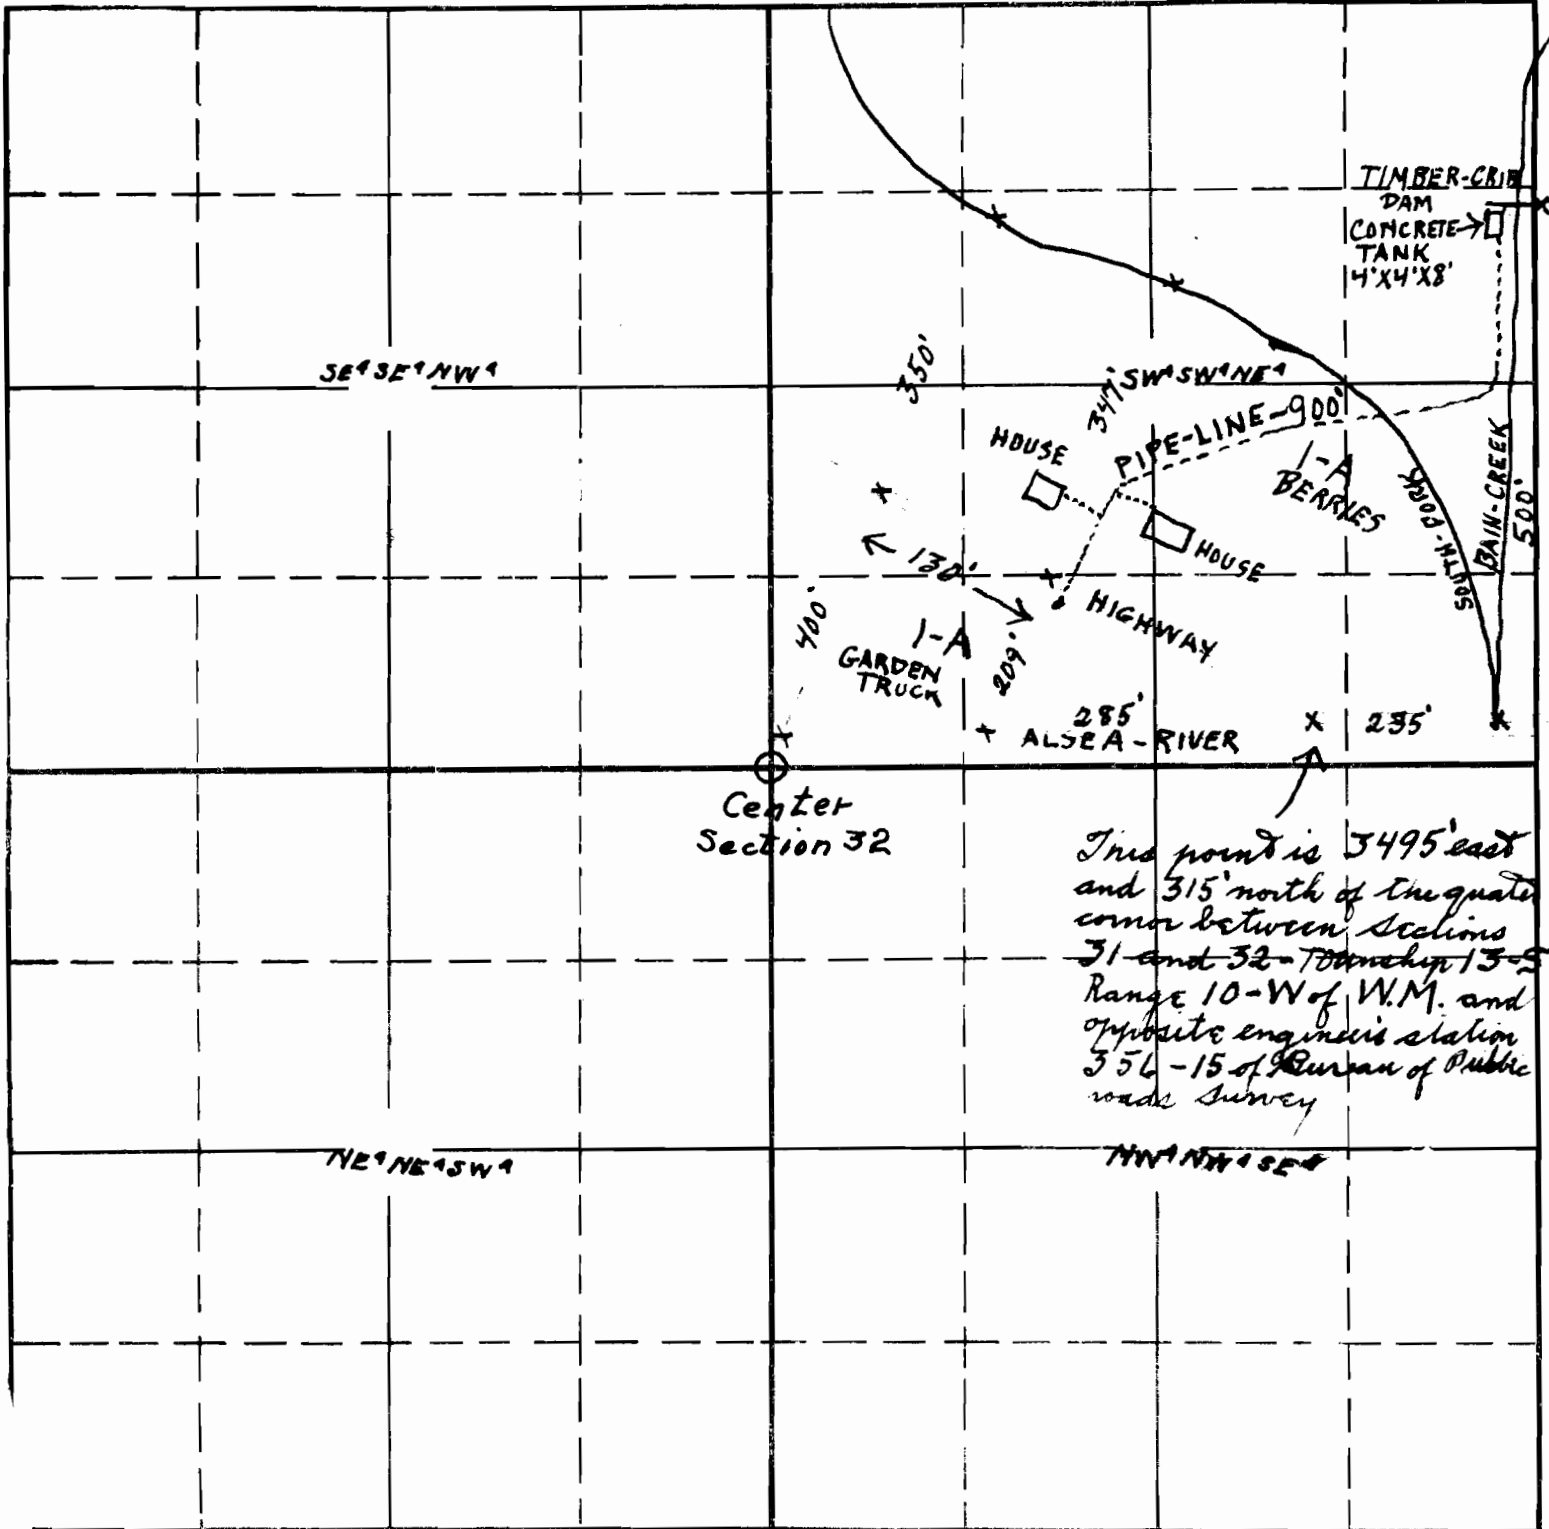

Center
Section 32

This point is 3495' east
and 315' north of the quarter
corner between sections
31 and 32 - Township 13-5
Range 10-W of W.M. and
opposite engineer's station
356-15 of Bureau of Public

South