


16

TOWNSHIP 34S, RANGE 1W, W. M.

North

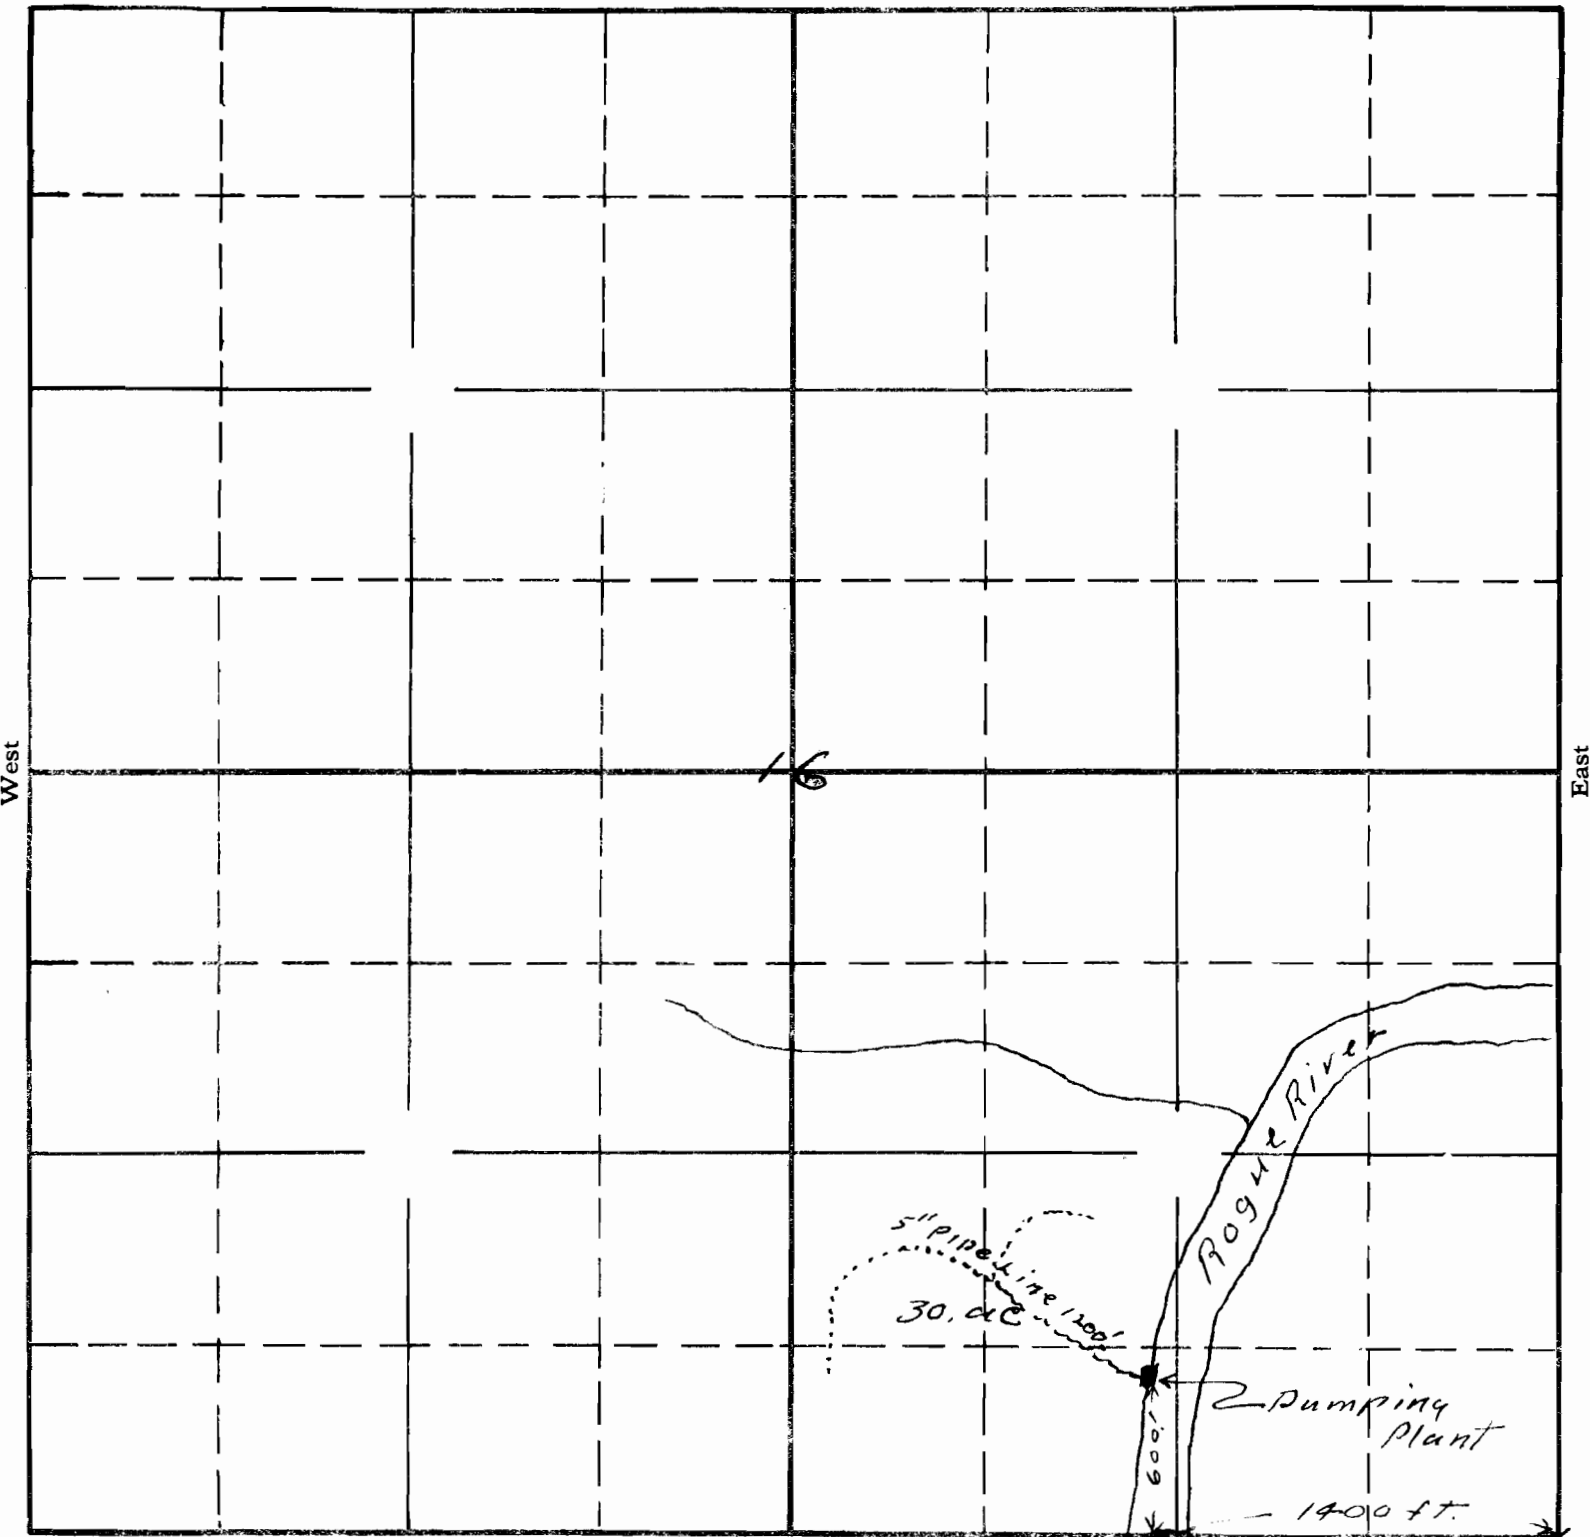

South

Map to accompany application of Mrs Glenn Fabric, taken from assessors plat. for irrigation of orchard

APPLICATION No. 15204

PERMIT No. 11125

SEC 01-SEC 16  
T 34S R 1W W.M.