


SECTION

4

TOWNSHIP 37S, RANGE 4W, W. M.

North

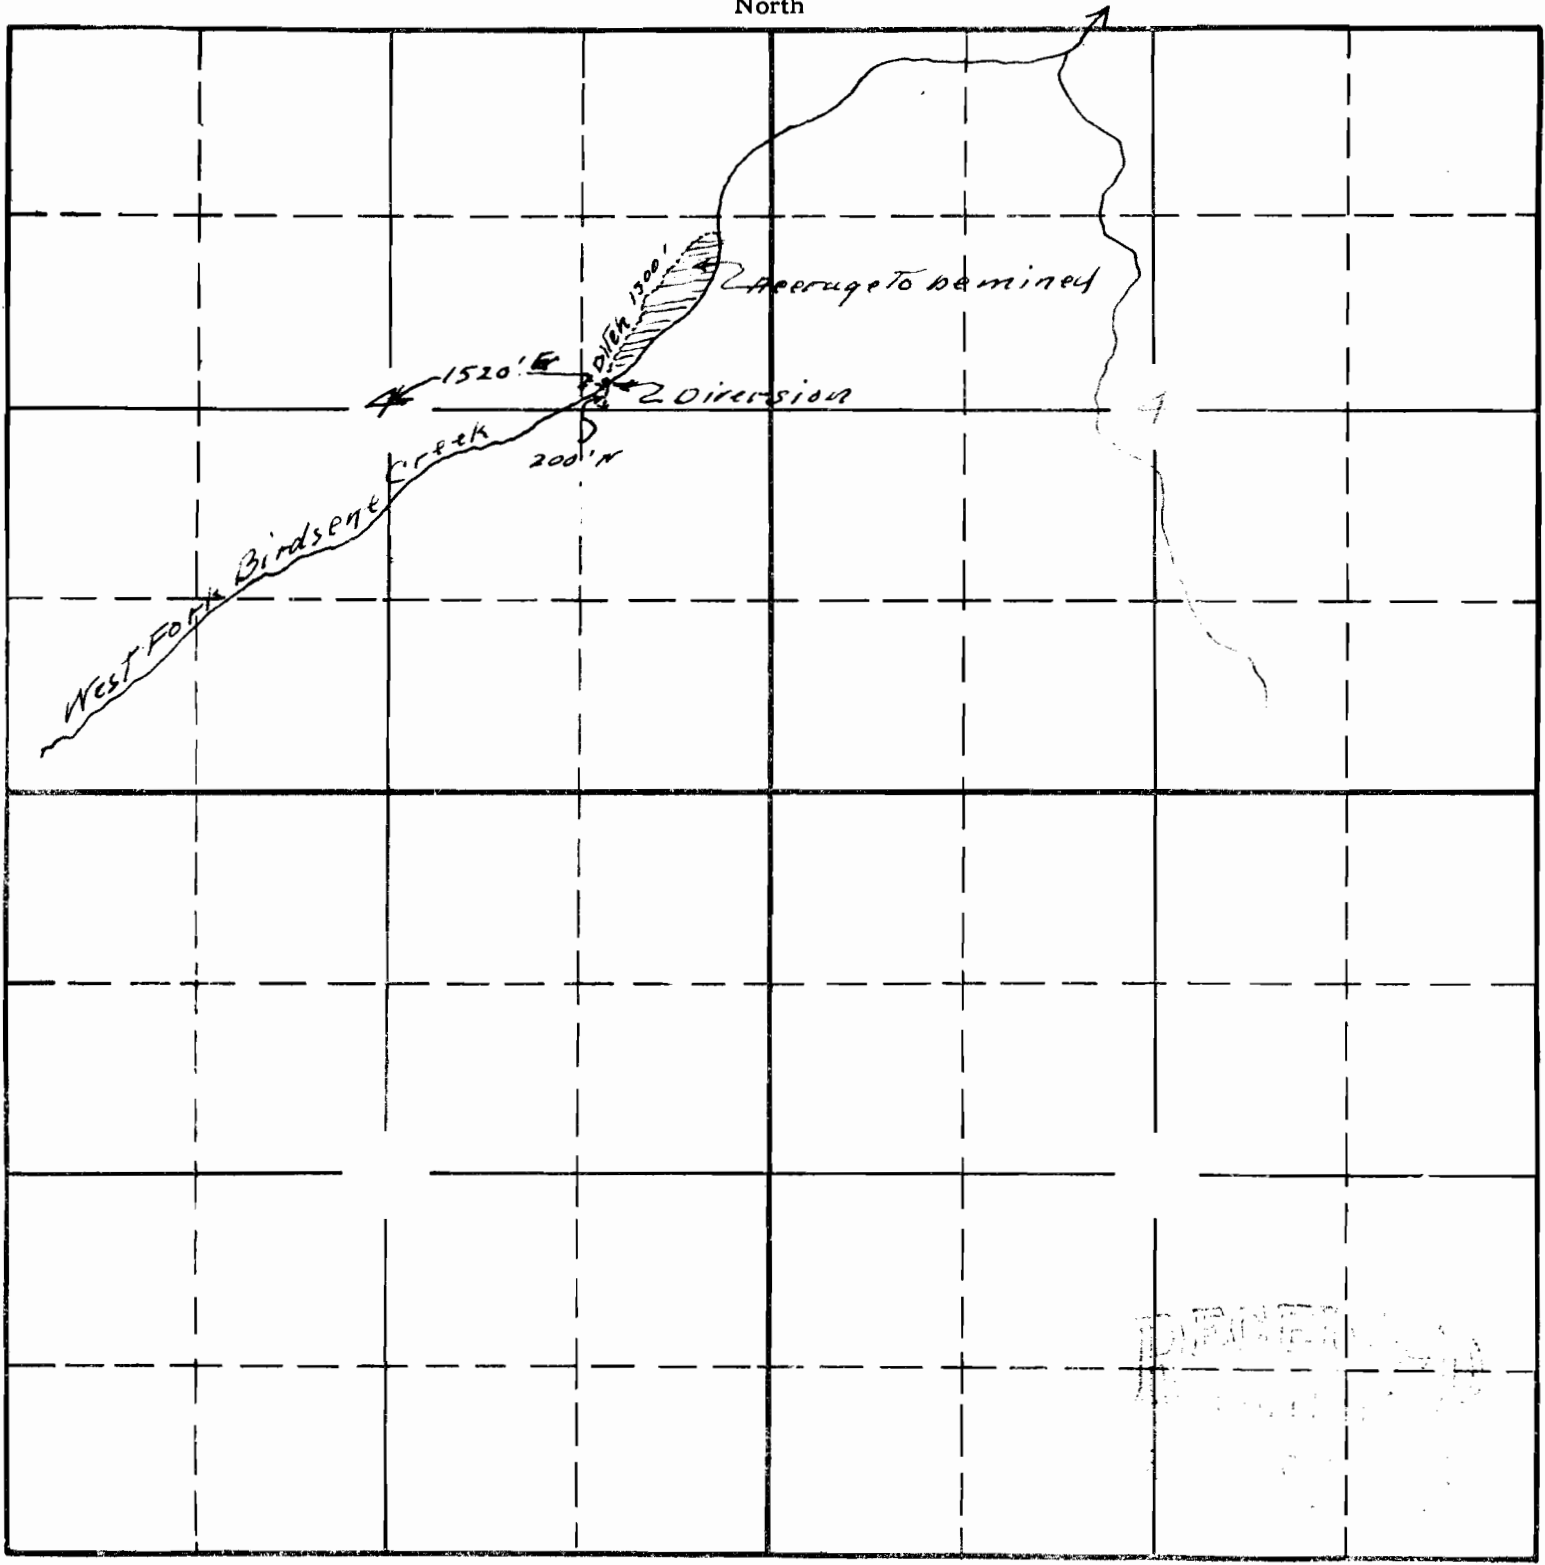

South

Map accompanying application of
Henry A Huffman for mining
and domestic use

APPLICATION No. 15221

PERMIT No. 11138