


TP. 17 S. R. 9 W. W.M.

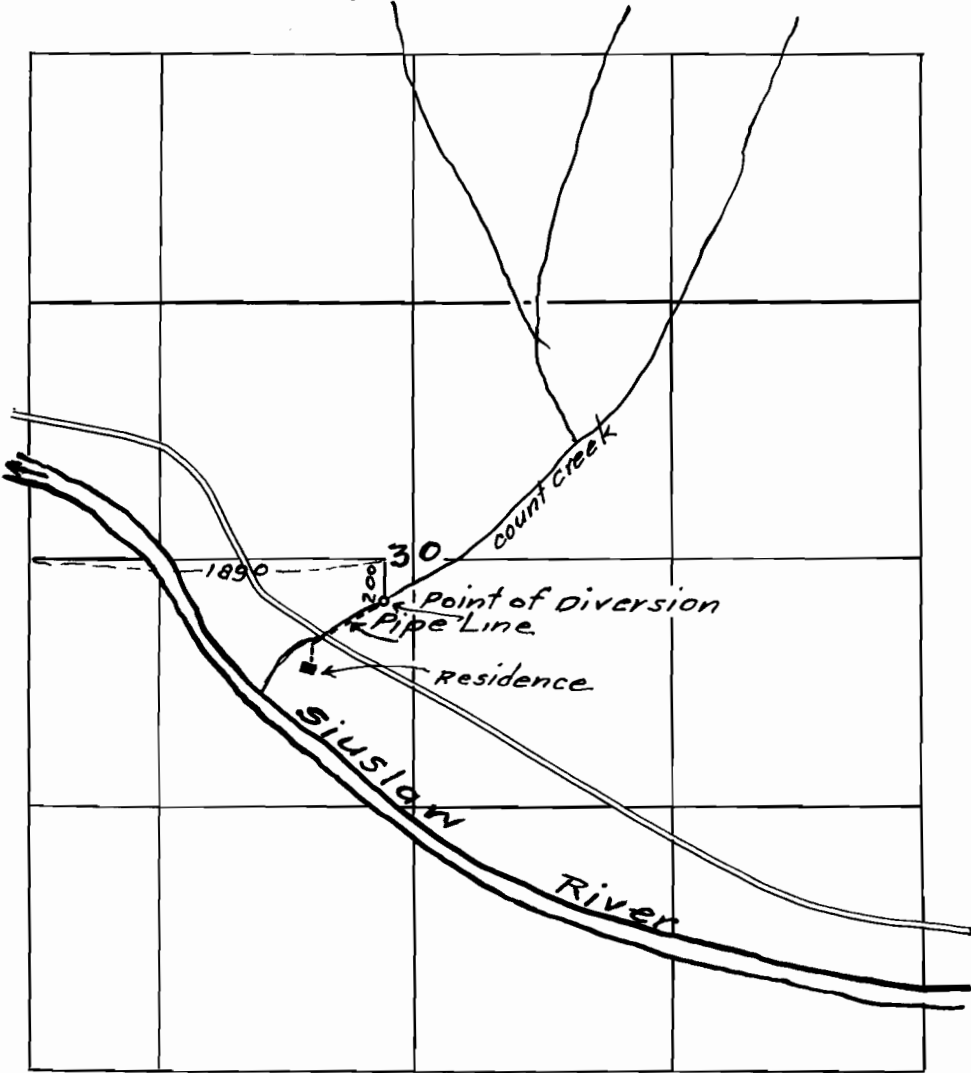

App. No. 15223

Per. No. 11140