


SECTION

\_\_\_\_\_  
\_\_\_\_\_  
\_\_\_\_\_  
\_\_\_\_\_

TOWNSHIP 45, RANGE 4E, W. M.

North

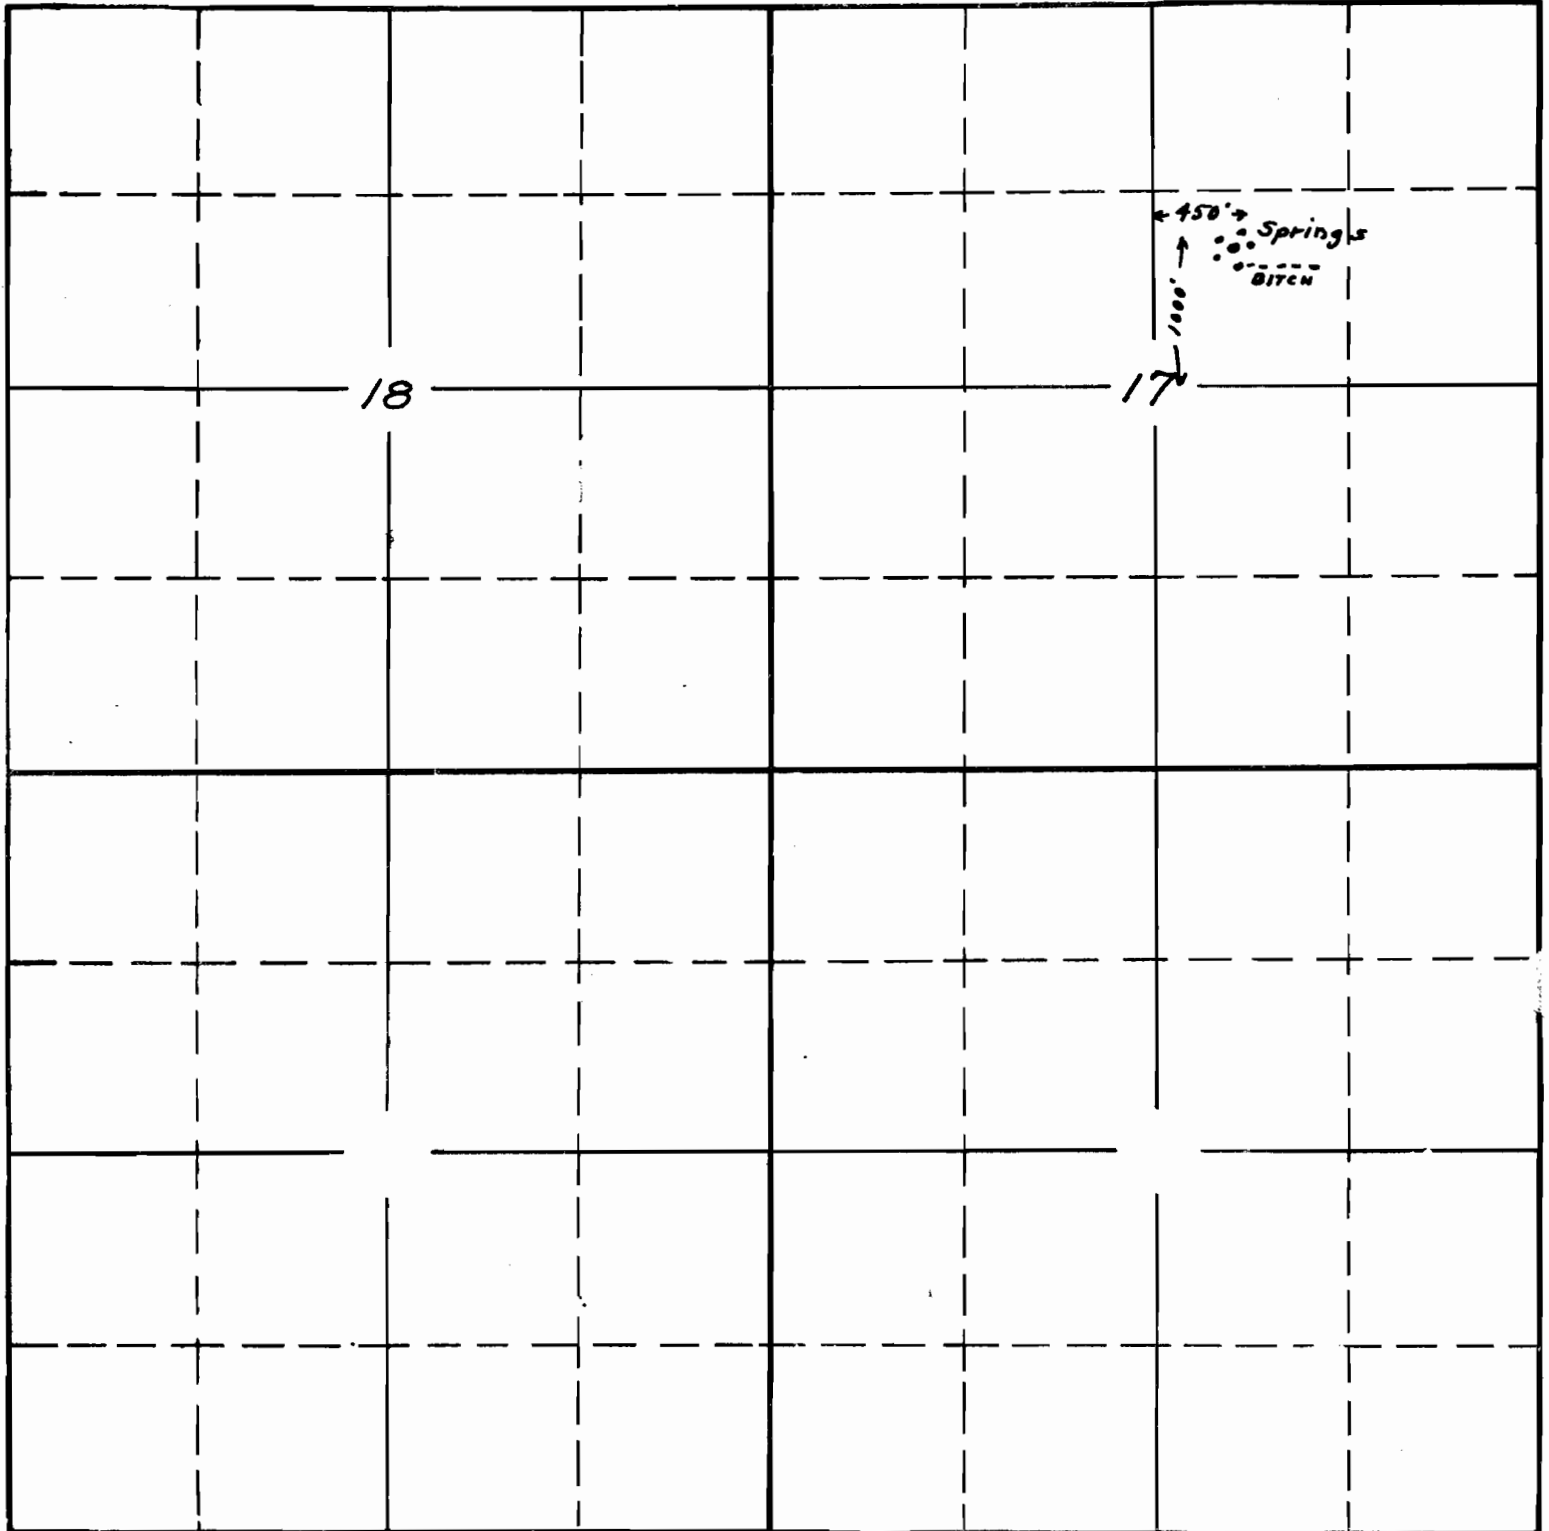

West

East

South

APPLICATION No. 15076

PERMIT No. 11159