


13

TOWNSHIP 38S, RANGE 4W, W. M.

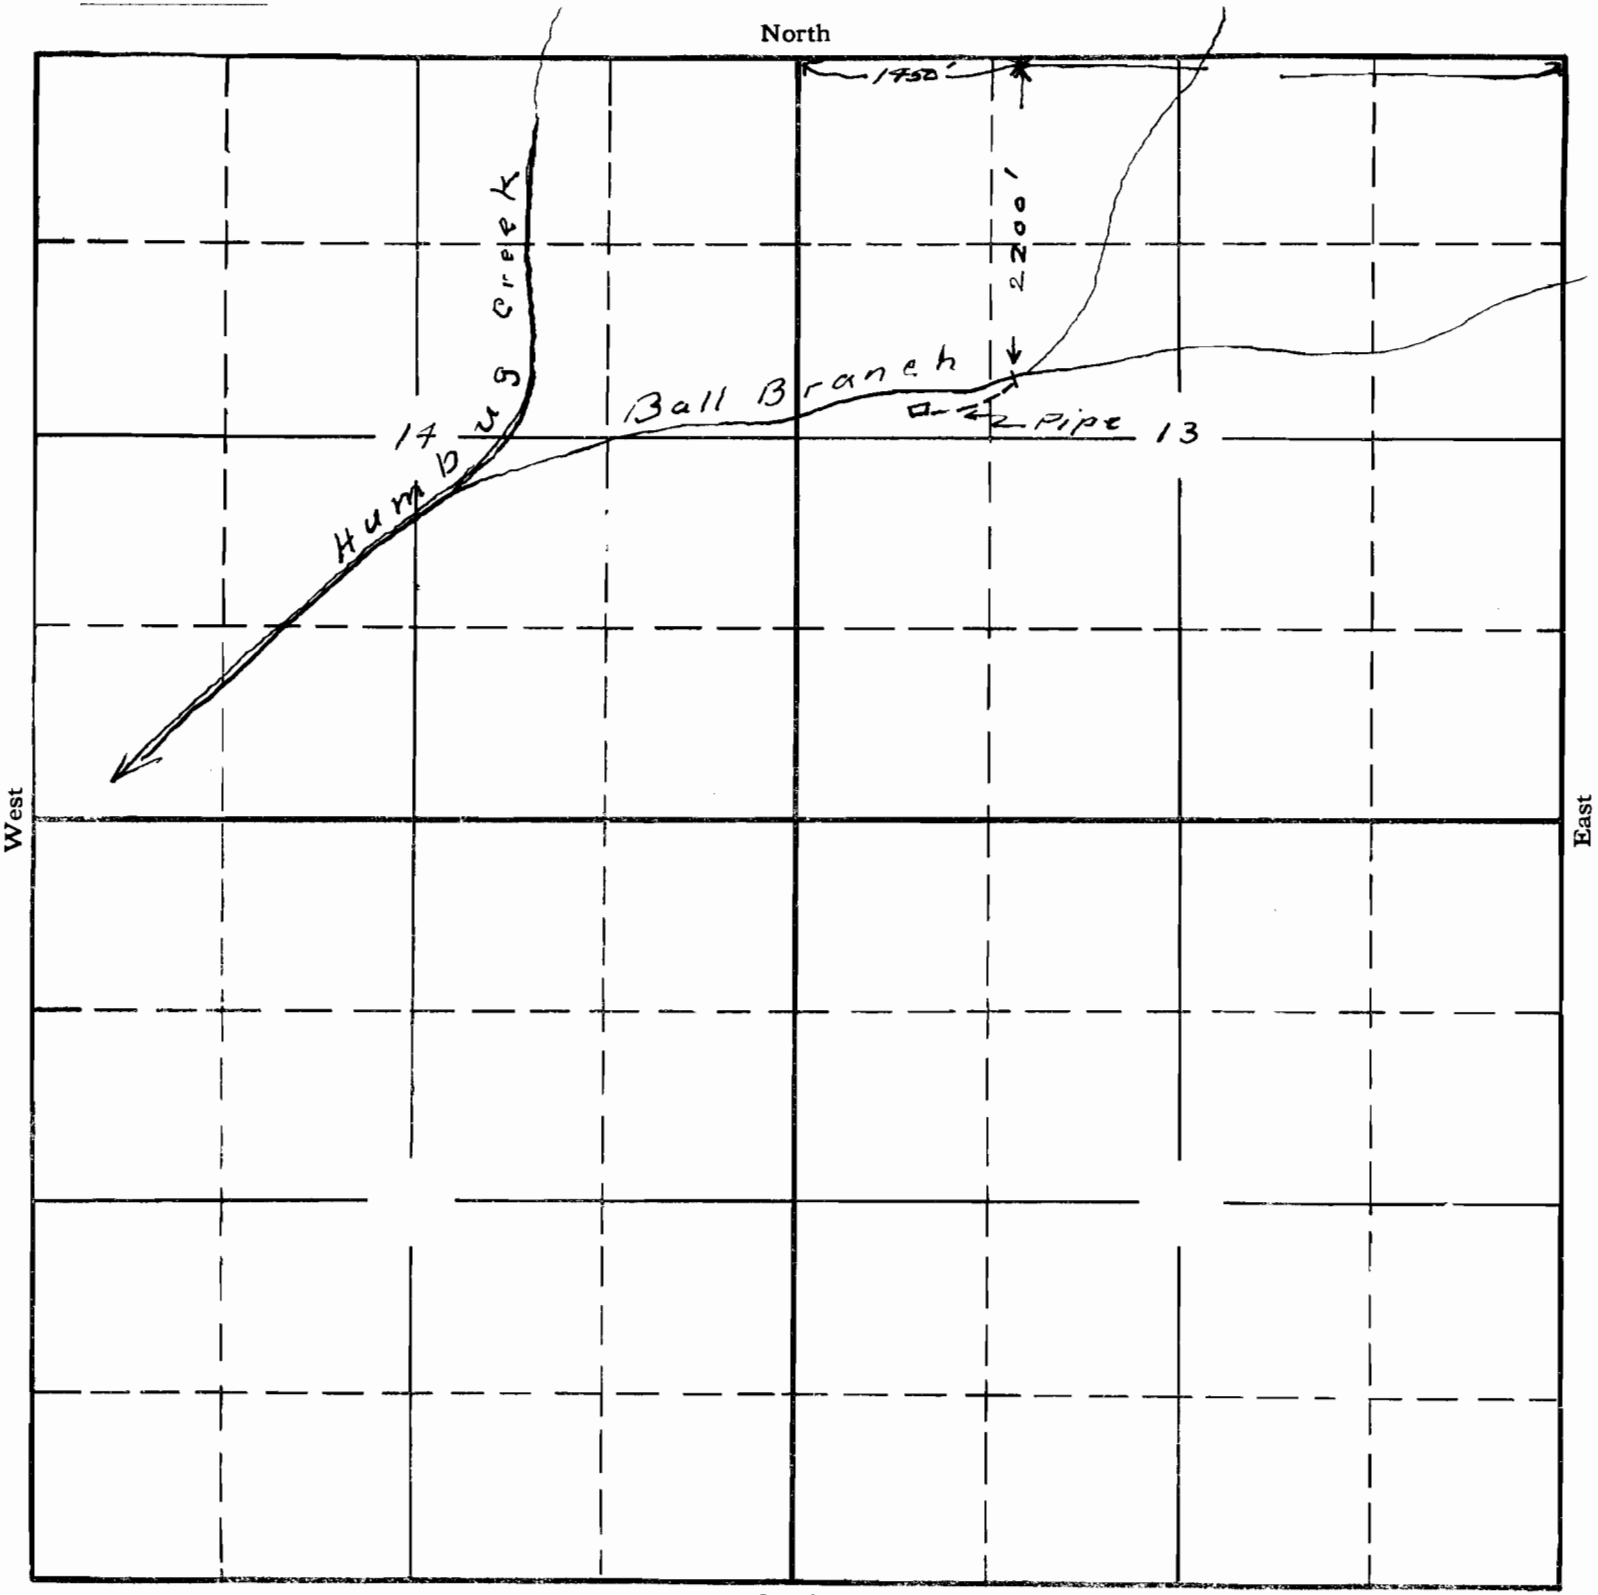

Map accompanying application of  
 W.S. Graham and W.H. Summers  
 for mining and domestic use

APPLICATION No. 15240  
 PERMIT No. 11168