


North

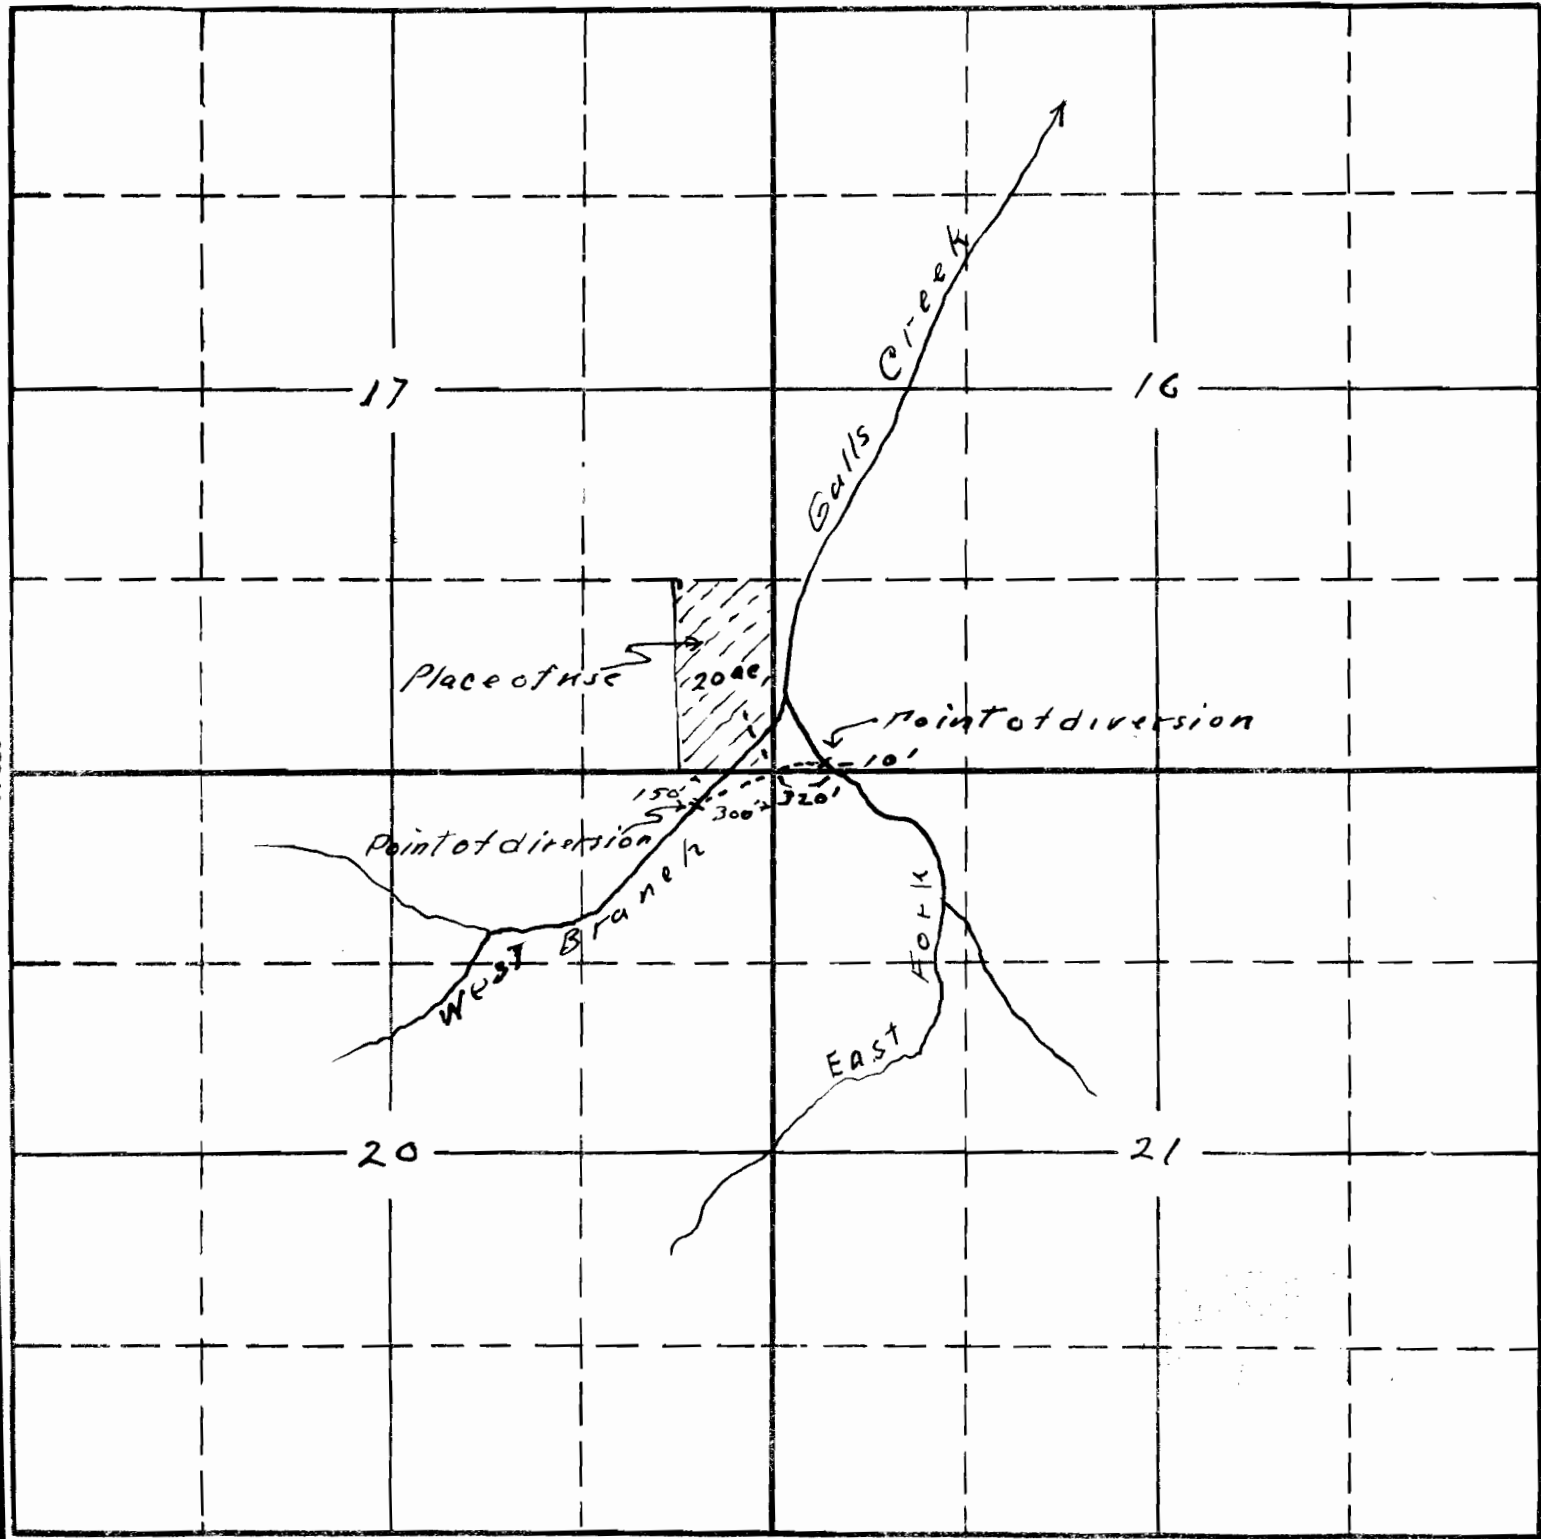

South

Map accompanying application of
 Franks Laurencee, compiled from
 maps and information from F Laurencee,
 For mining purposes.

APPLICATION No. 15242
 PERMIT No. 11169