
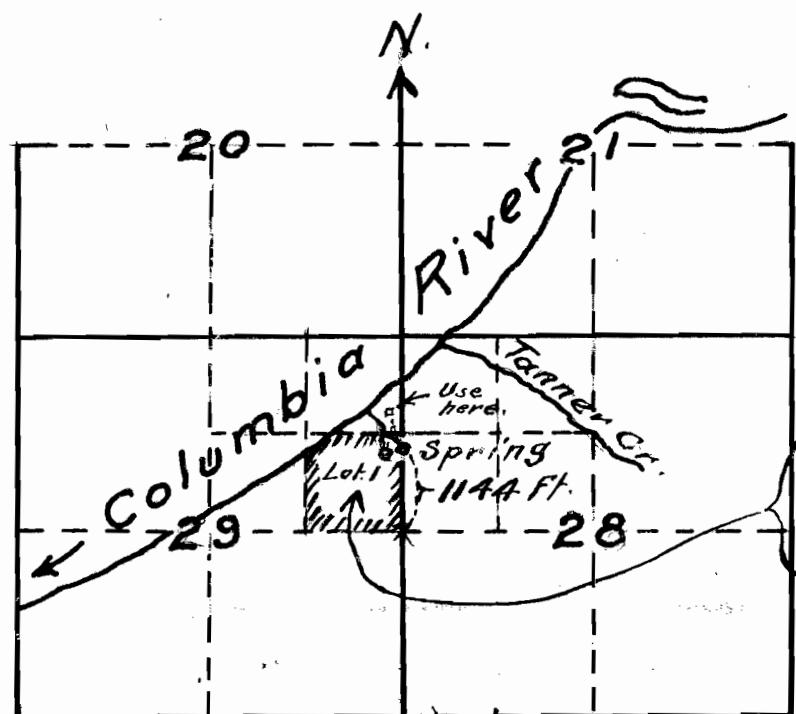


20 21

29 28

I, John H. Lewis, of 433 Ry. Exch.,
Portland, Oreg., do hereby certify that
this map was made from measurements
made by me on January 10-1934, and
that it correctly represents the works
described in the accompanying appli-
cation together with streams in the
immediate vicinity.

John H. Lewis.
Reg. Professional Engr.
Oreg. No. 4
Nov. 8, 1919.

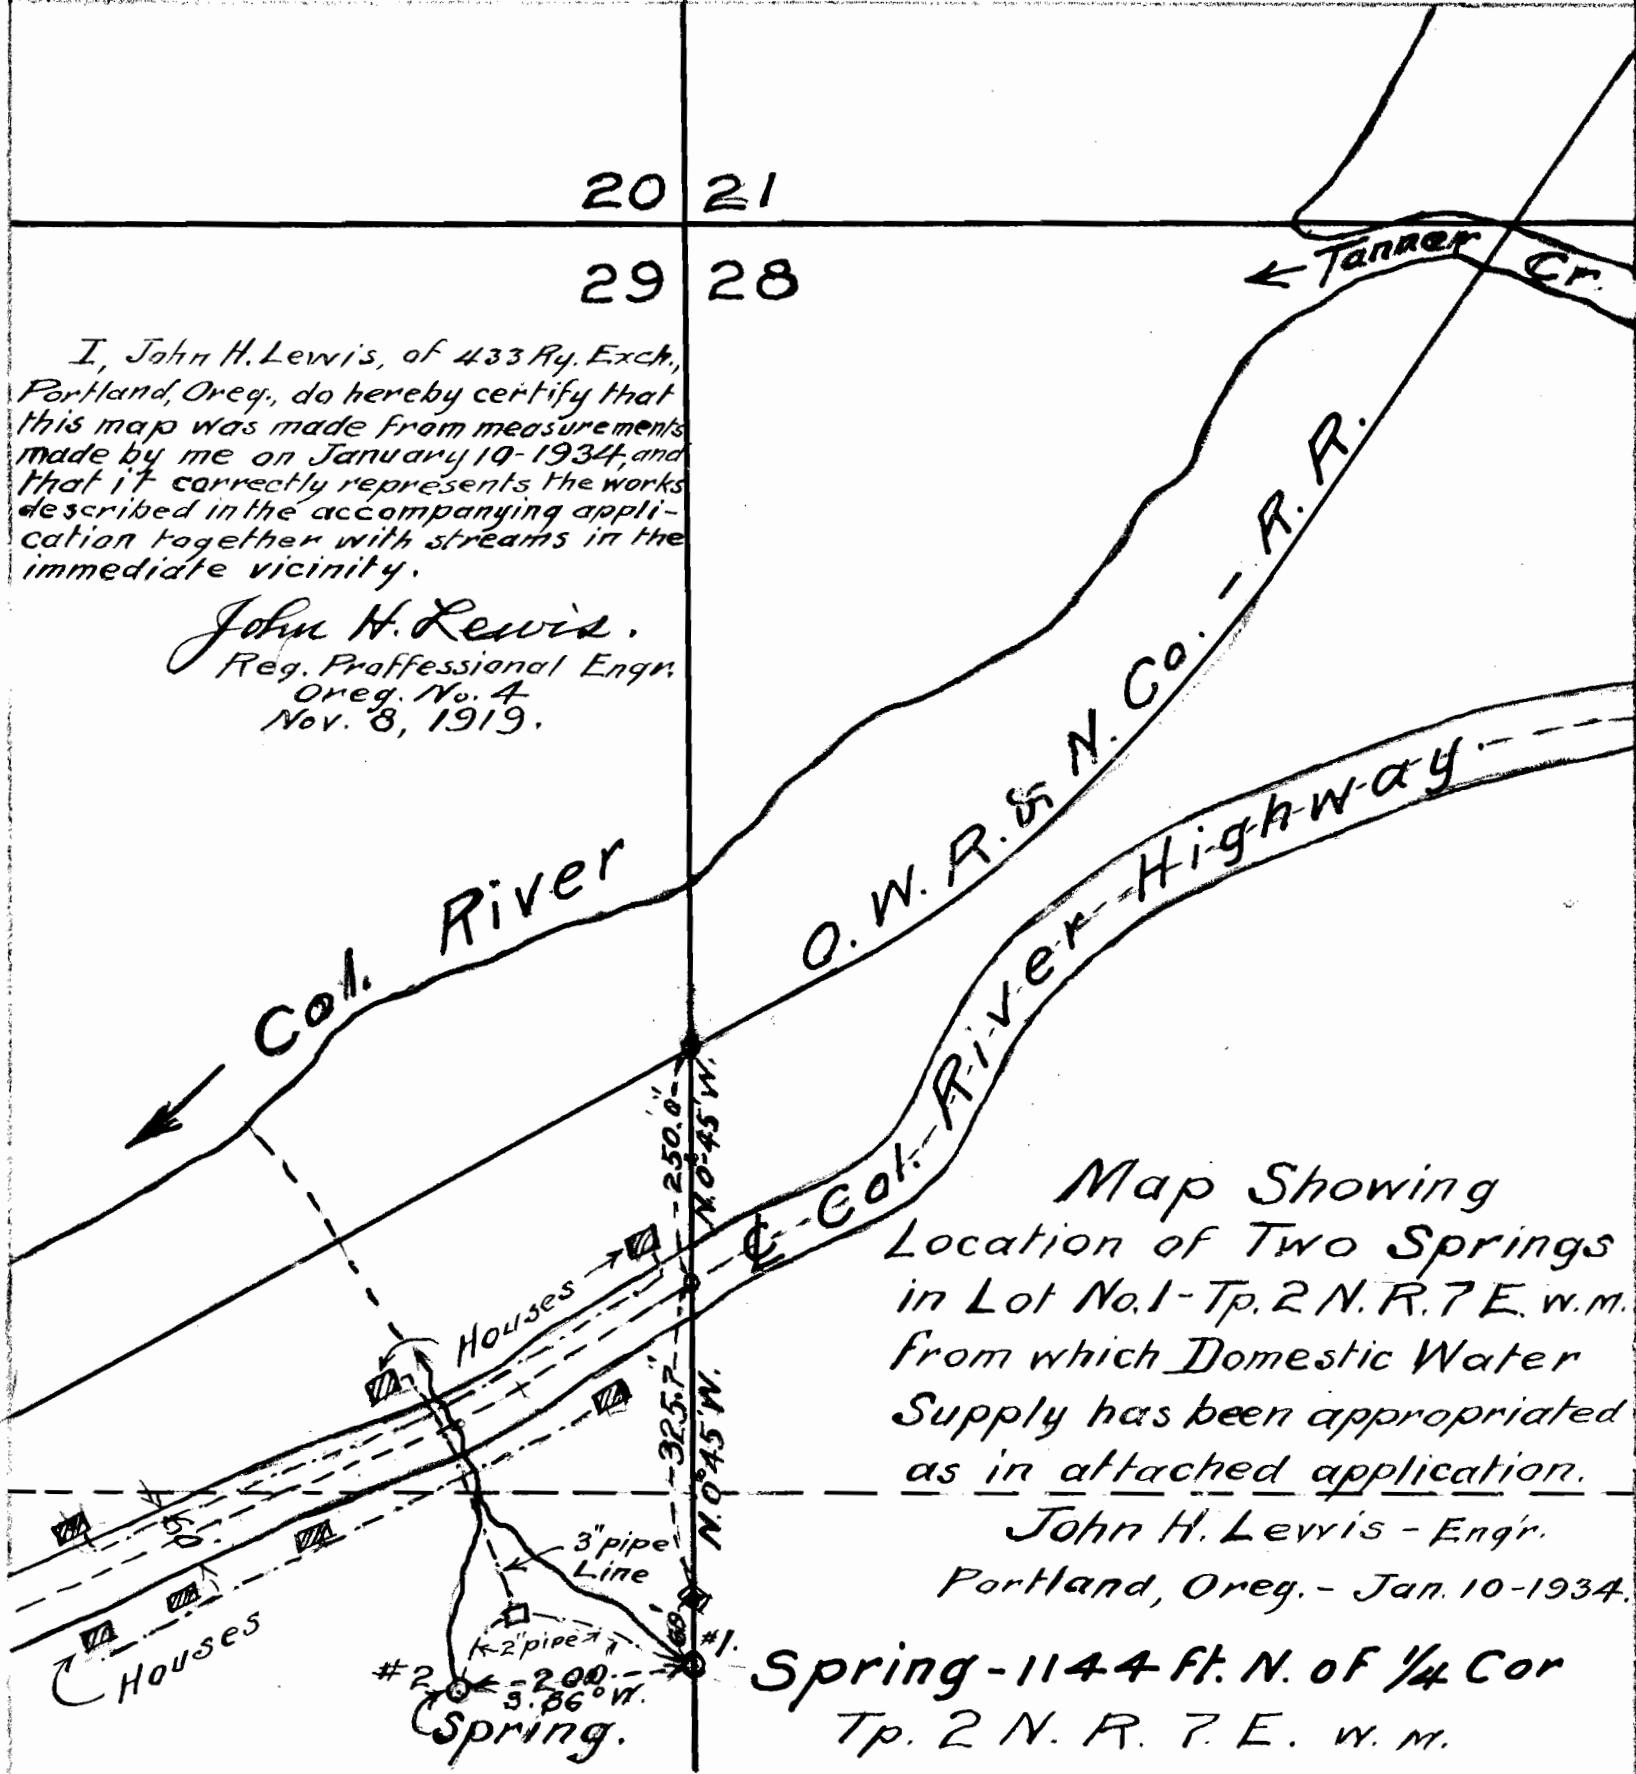

App. No. 15258
Per. No. 11179