


SECTION

TOWNSHIP 45, RANGE 1 E, W. M.

North

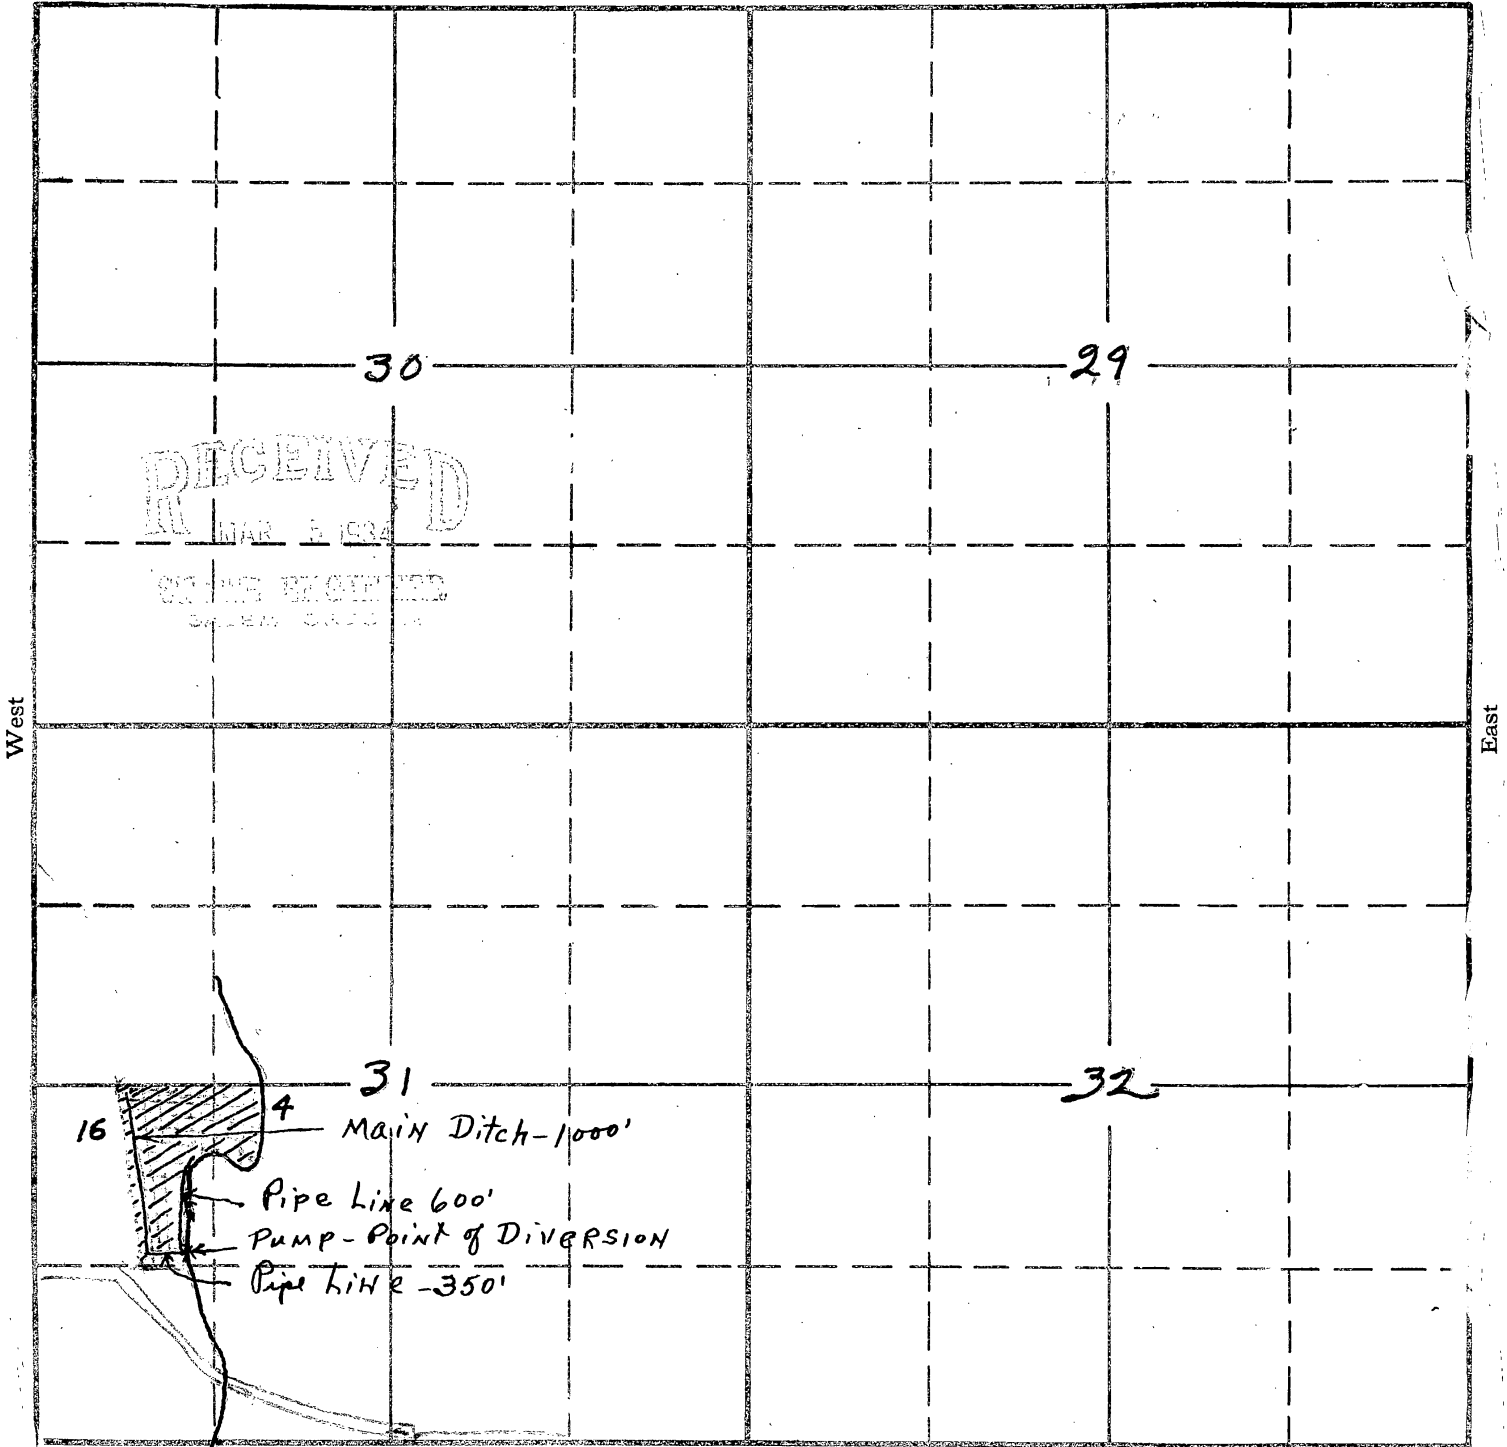

South

APPLICATION No. 15294

PERMIT No. 11196