


SECTION

TOWNSHIP 7S., RANGE 45E, W. M.

North

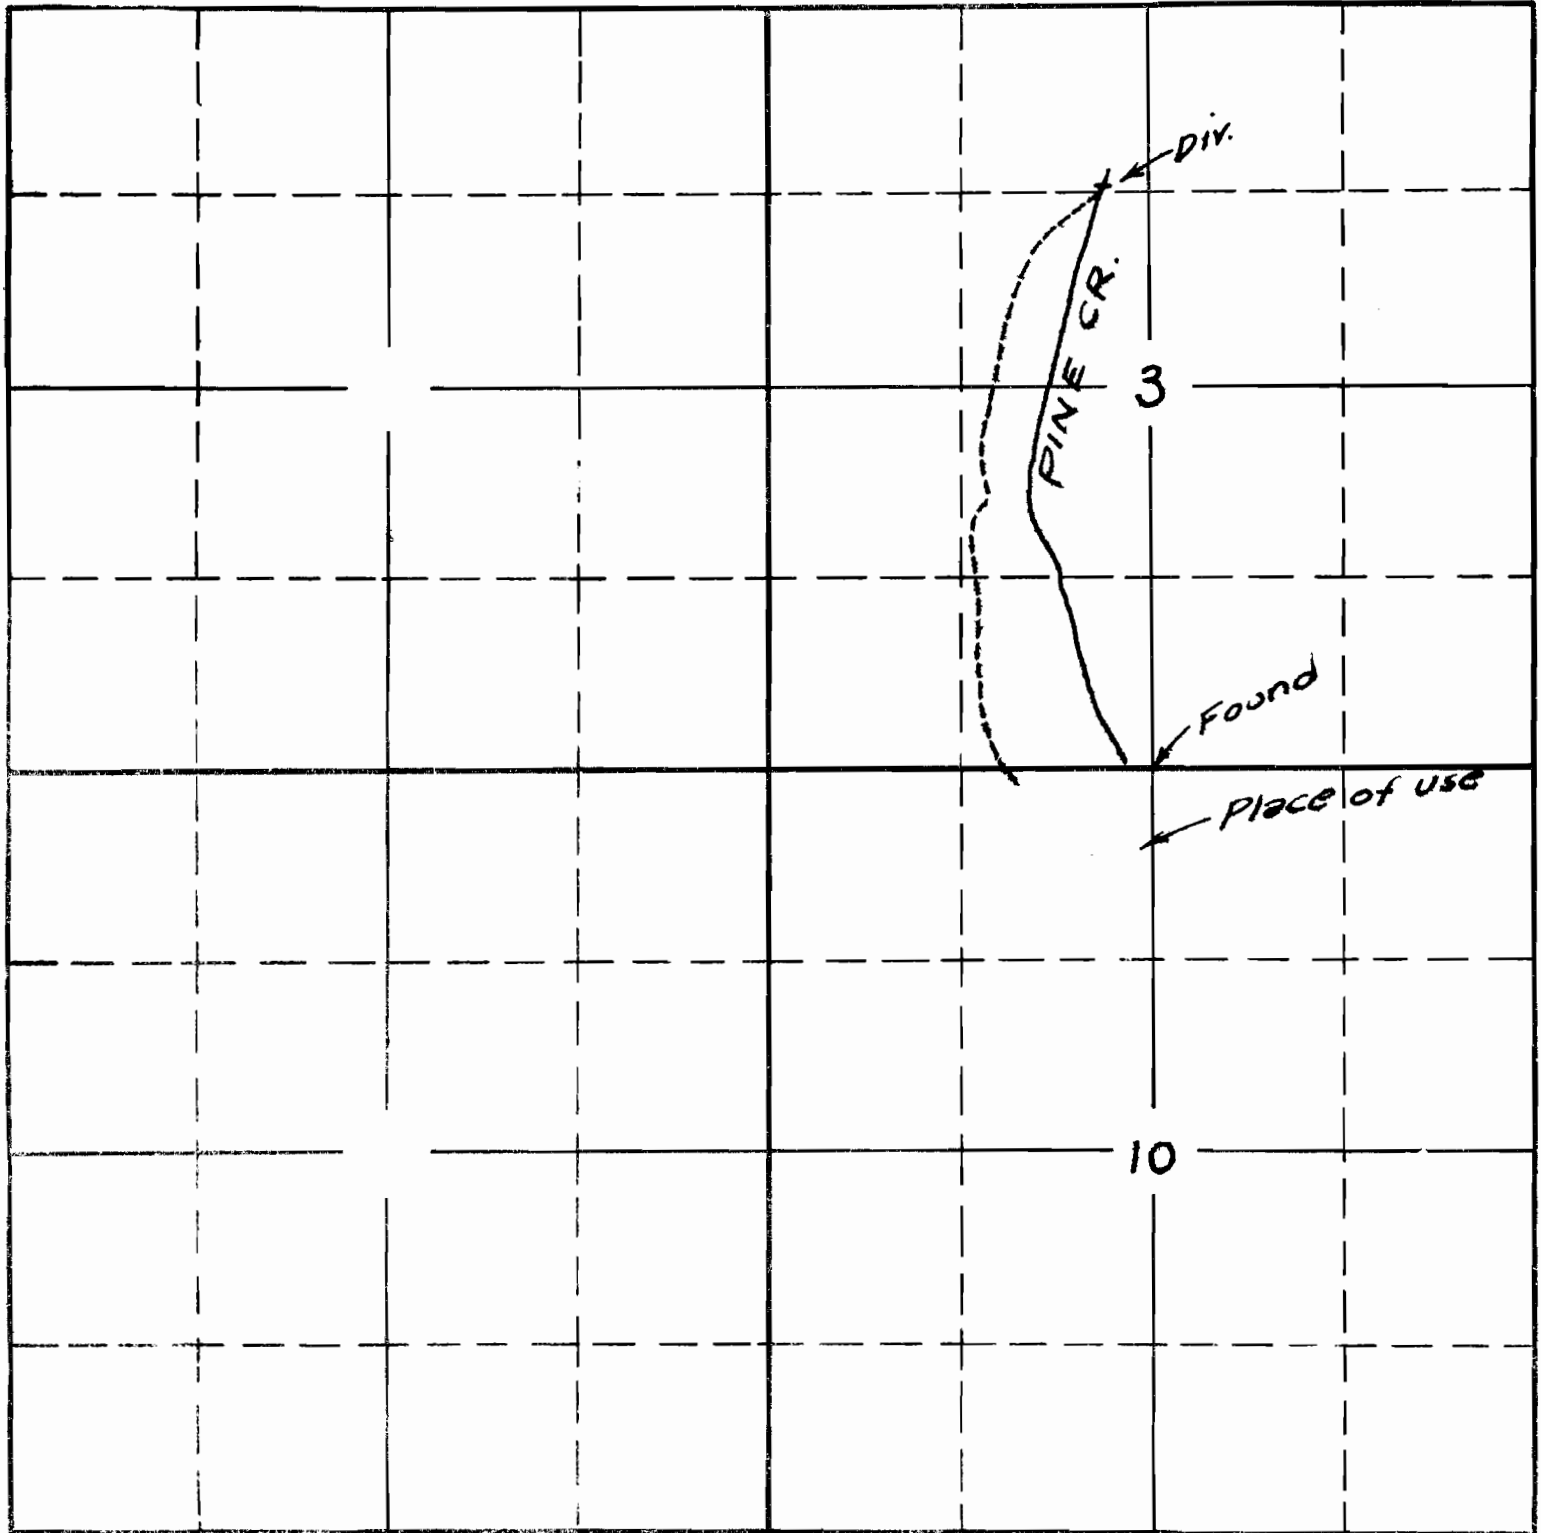

South


APPLICATION No. 15262
PERMIT No. 11206

SECTION
3
10
15

TOWNSHIP 7 S, RANGE 45 E, W. M.

North

Basco Co Oreg.

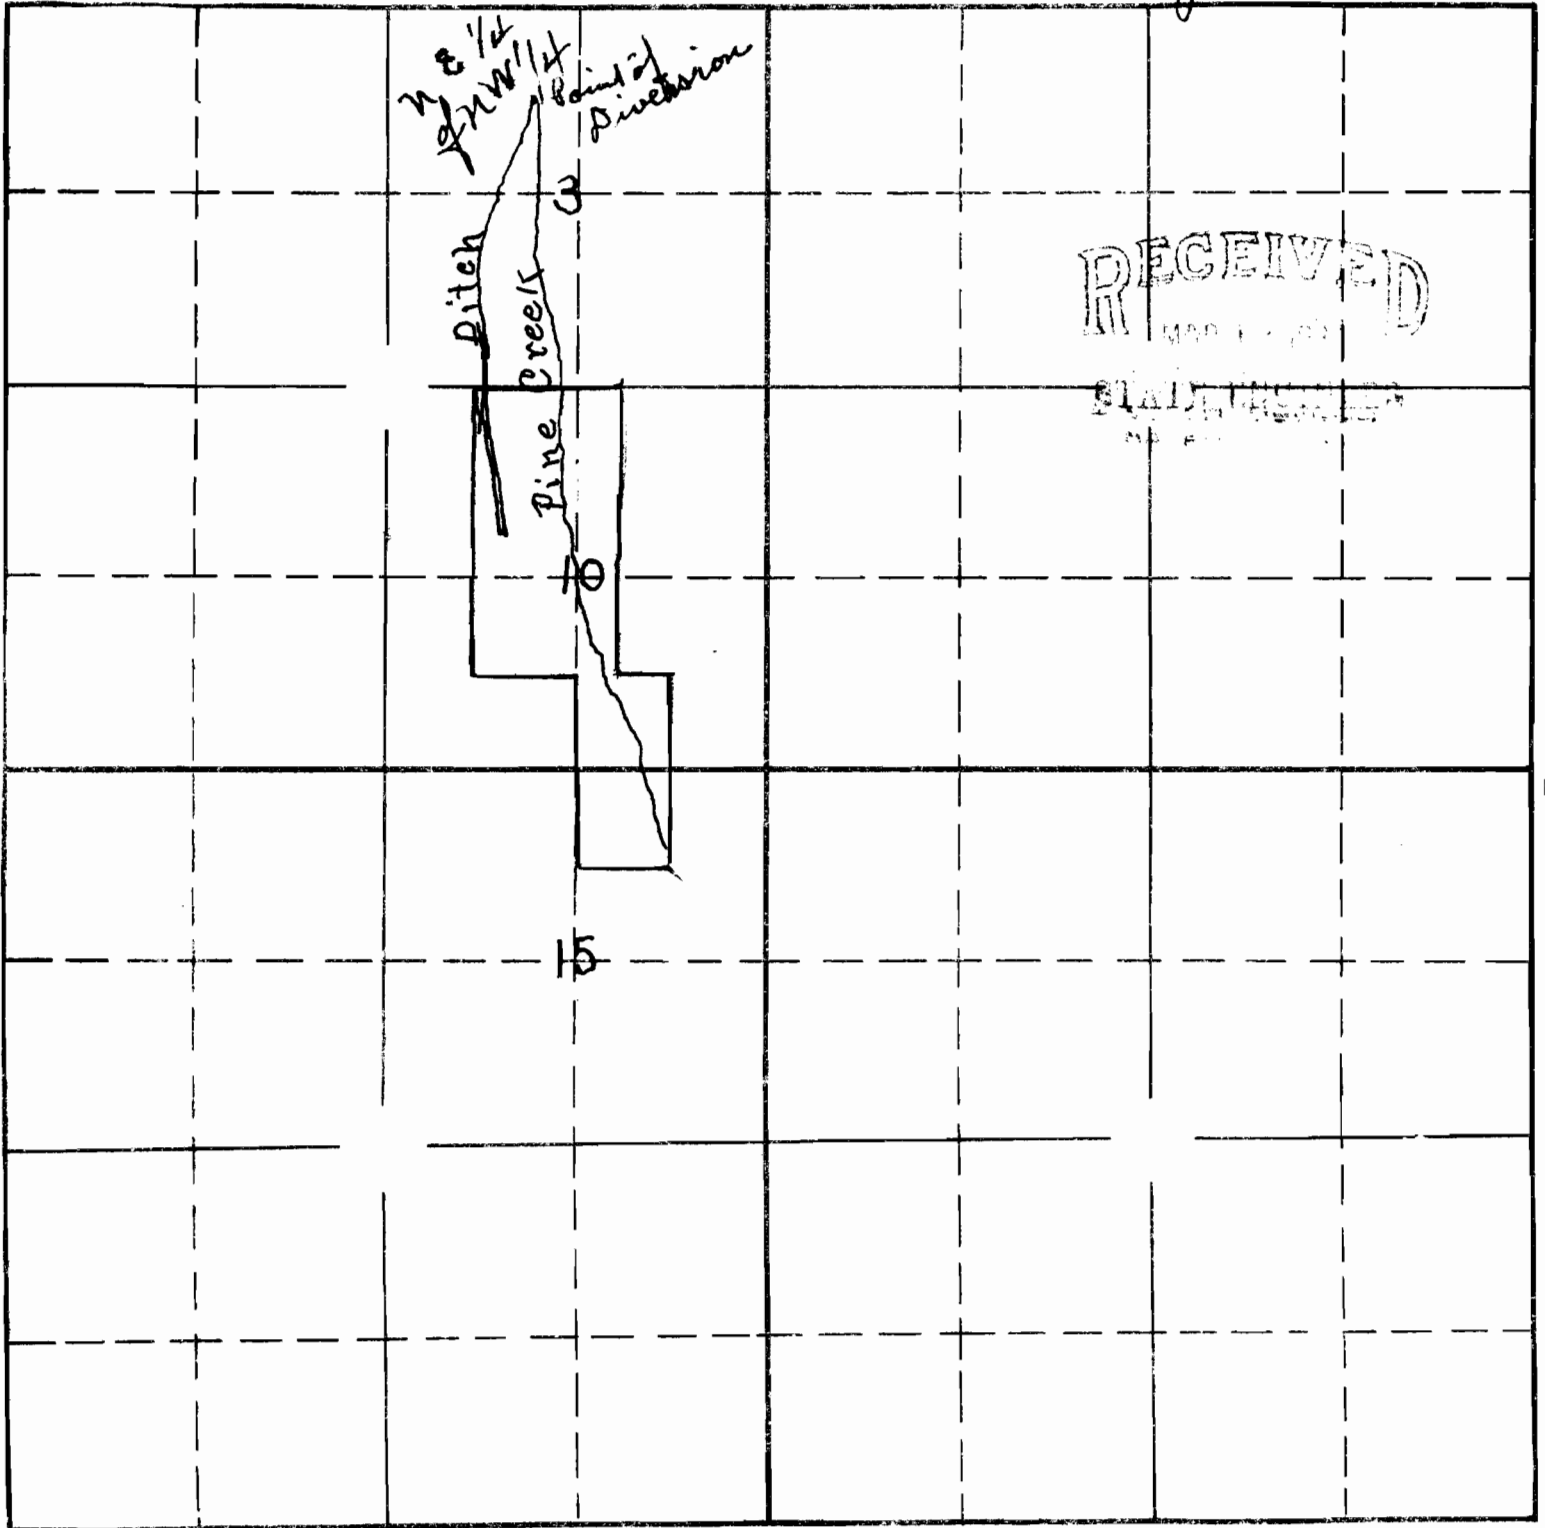

South

APPLICATION No. 15262
PERMIT No. 11206