


North

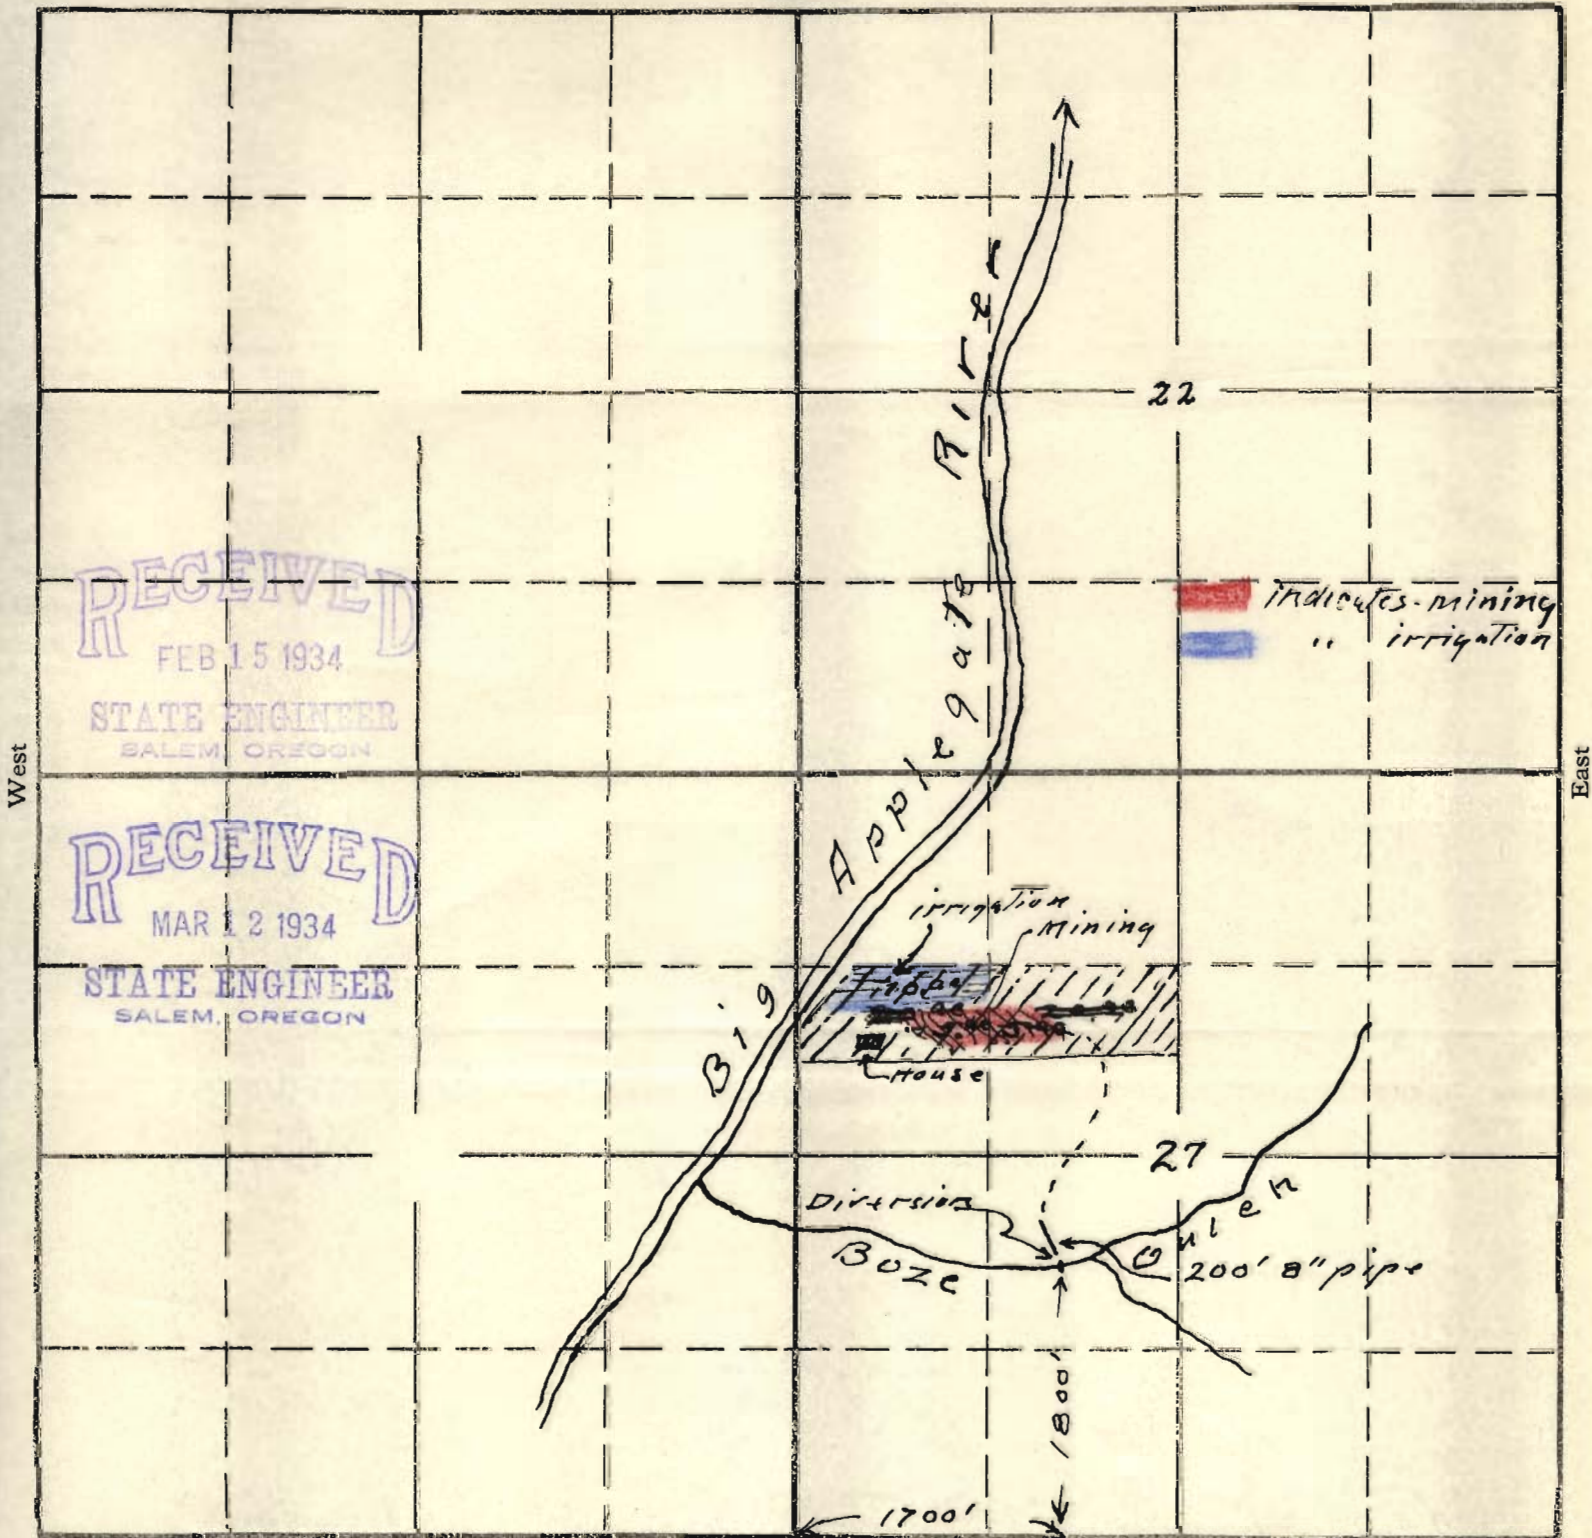

Map accompanying application of  
 W.B. Harlow for appropriation  
 of the waters of Boze Guleh  
 Trib of Big Applegate River for  
 mining, domestic and irrigation

APPLICATION No. 15268  
 PERMIT No. 11207