

MAP
 Certain Subdivisinal Lines
 NW 1/4 Sec. 4, Twp. 41 S., R. 13 W., W.M.
 Showing Stream and Water System Locations
 Surveyed for STANLEY WAGNER
 Sept. 1935. Chas. T. M. Echols, Surveyor.

Scale 1" = 200'

NOTE: The Subdivisinal Lines and Corners shown hereon are Temporary as they were established by true course and distance from the N.W. Cor. Sec. 4 and not by subdivision of the entire section.


Chas. T. M. Echols, Deputy Co. Surveyor
 Curry Co., Oregon.

SECTION

4

TOWNSHIP 41S, RANGE 13W, W. M.

North

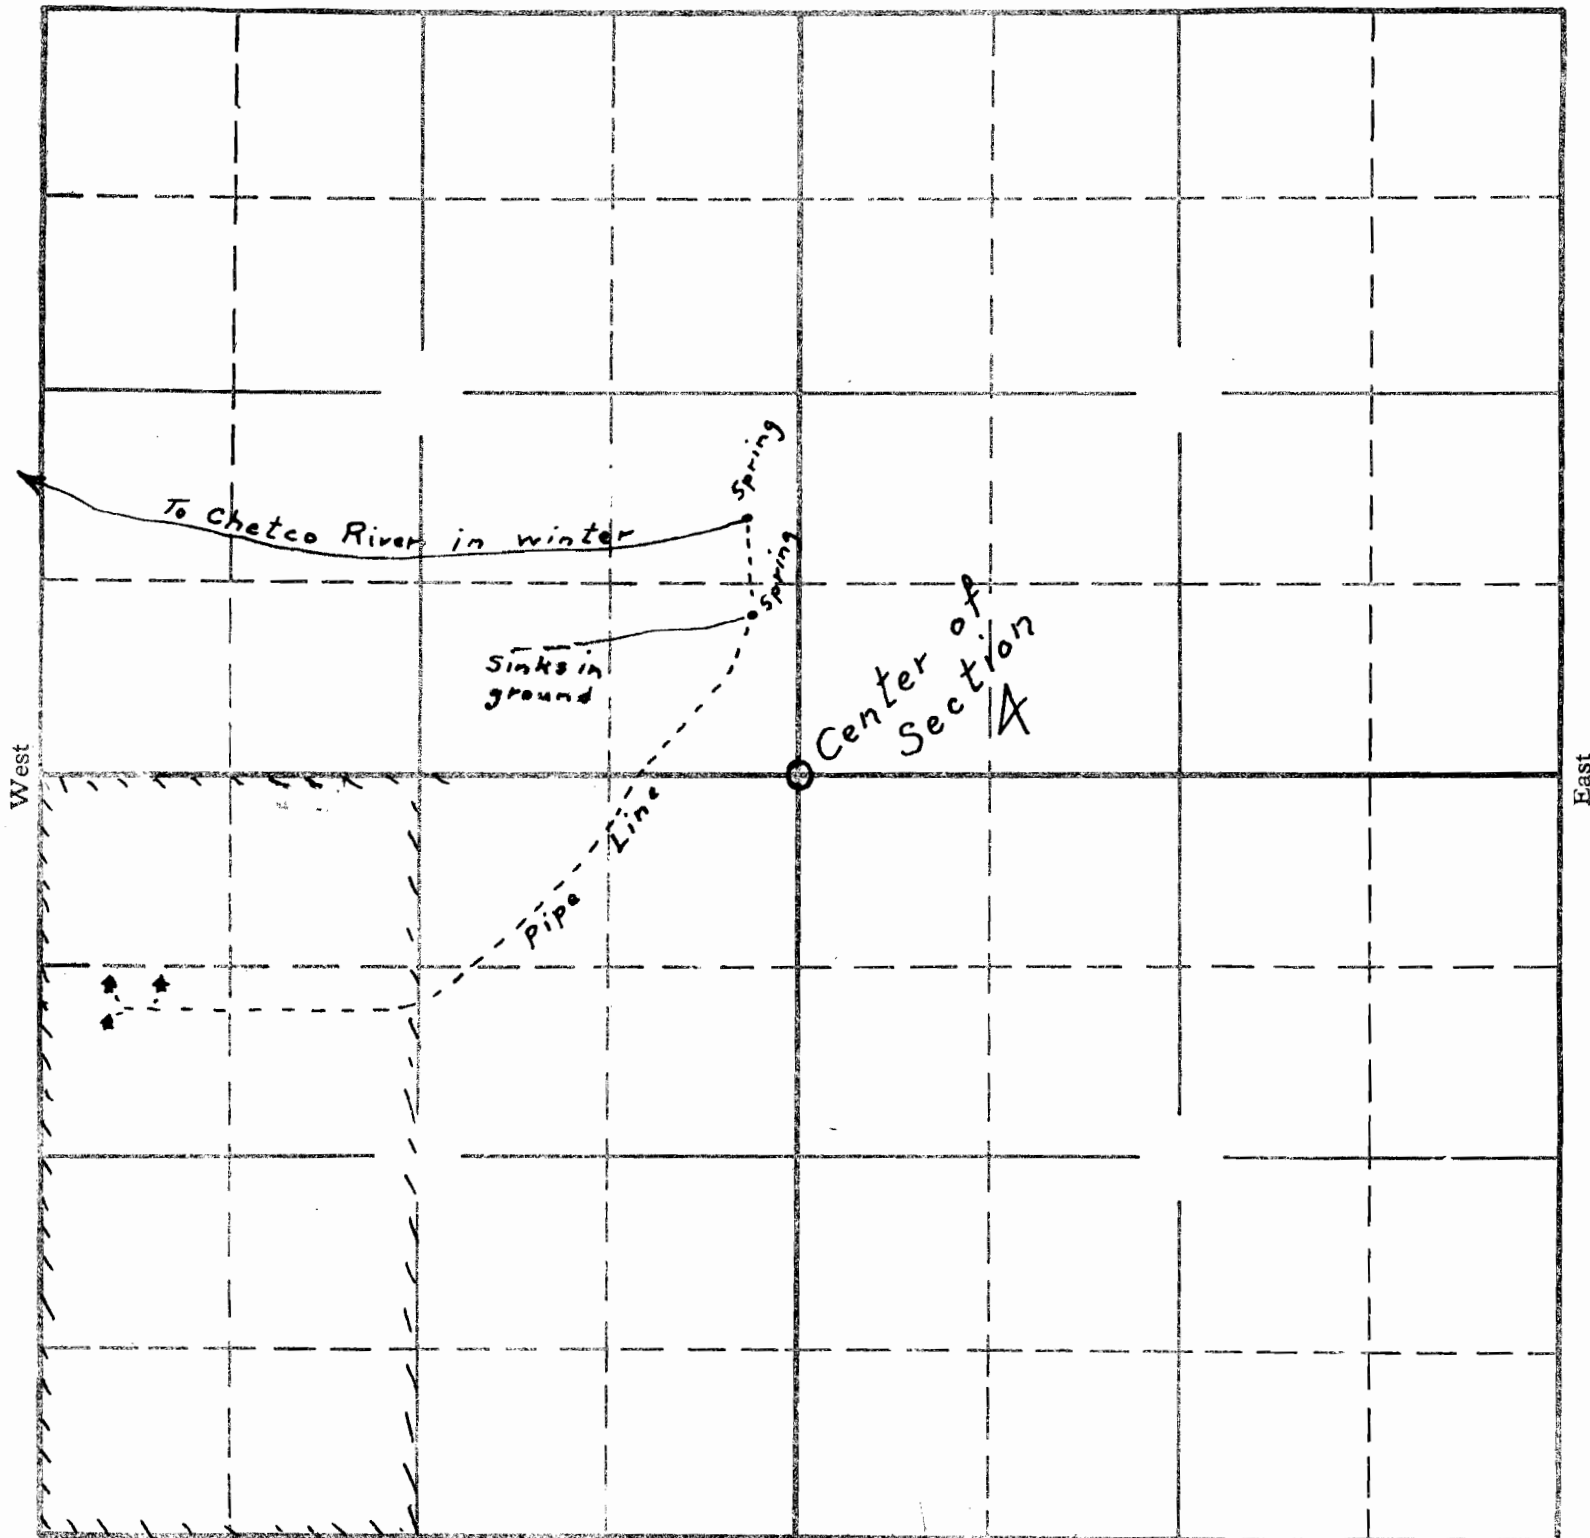

West

East

South

Copied from
applicant's sketch
4/3/34-

APPLICATION No. 15279


PERMIT No. 11211

SECTION

4

TOWNSHIP 41 S, RANGE 13 W, W. M.

North

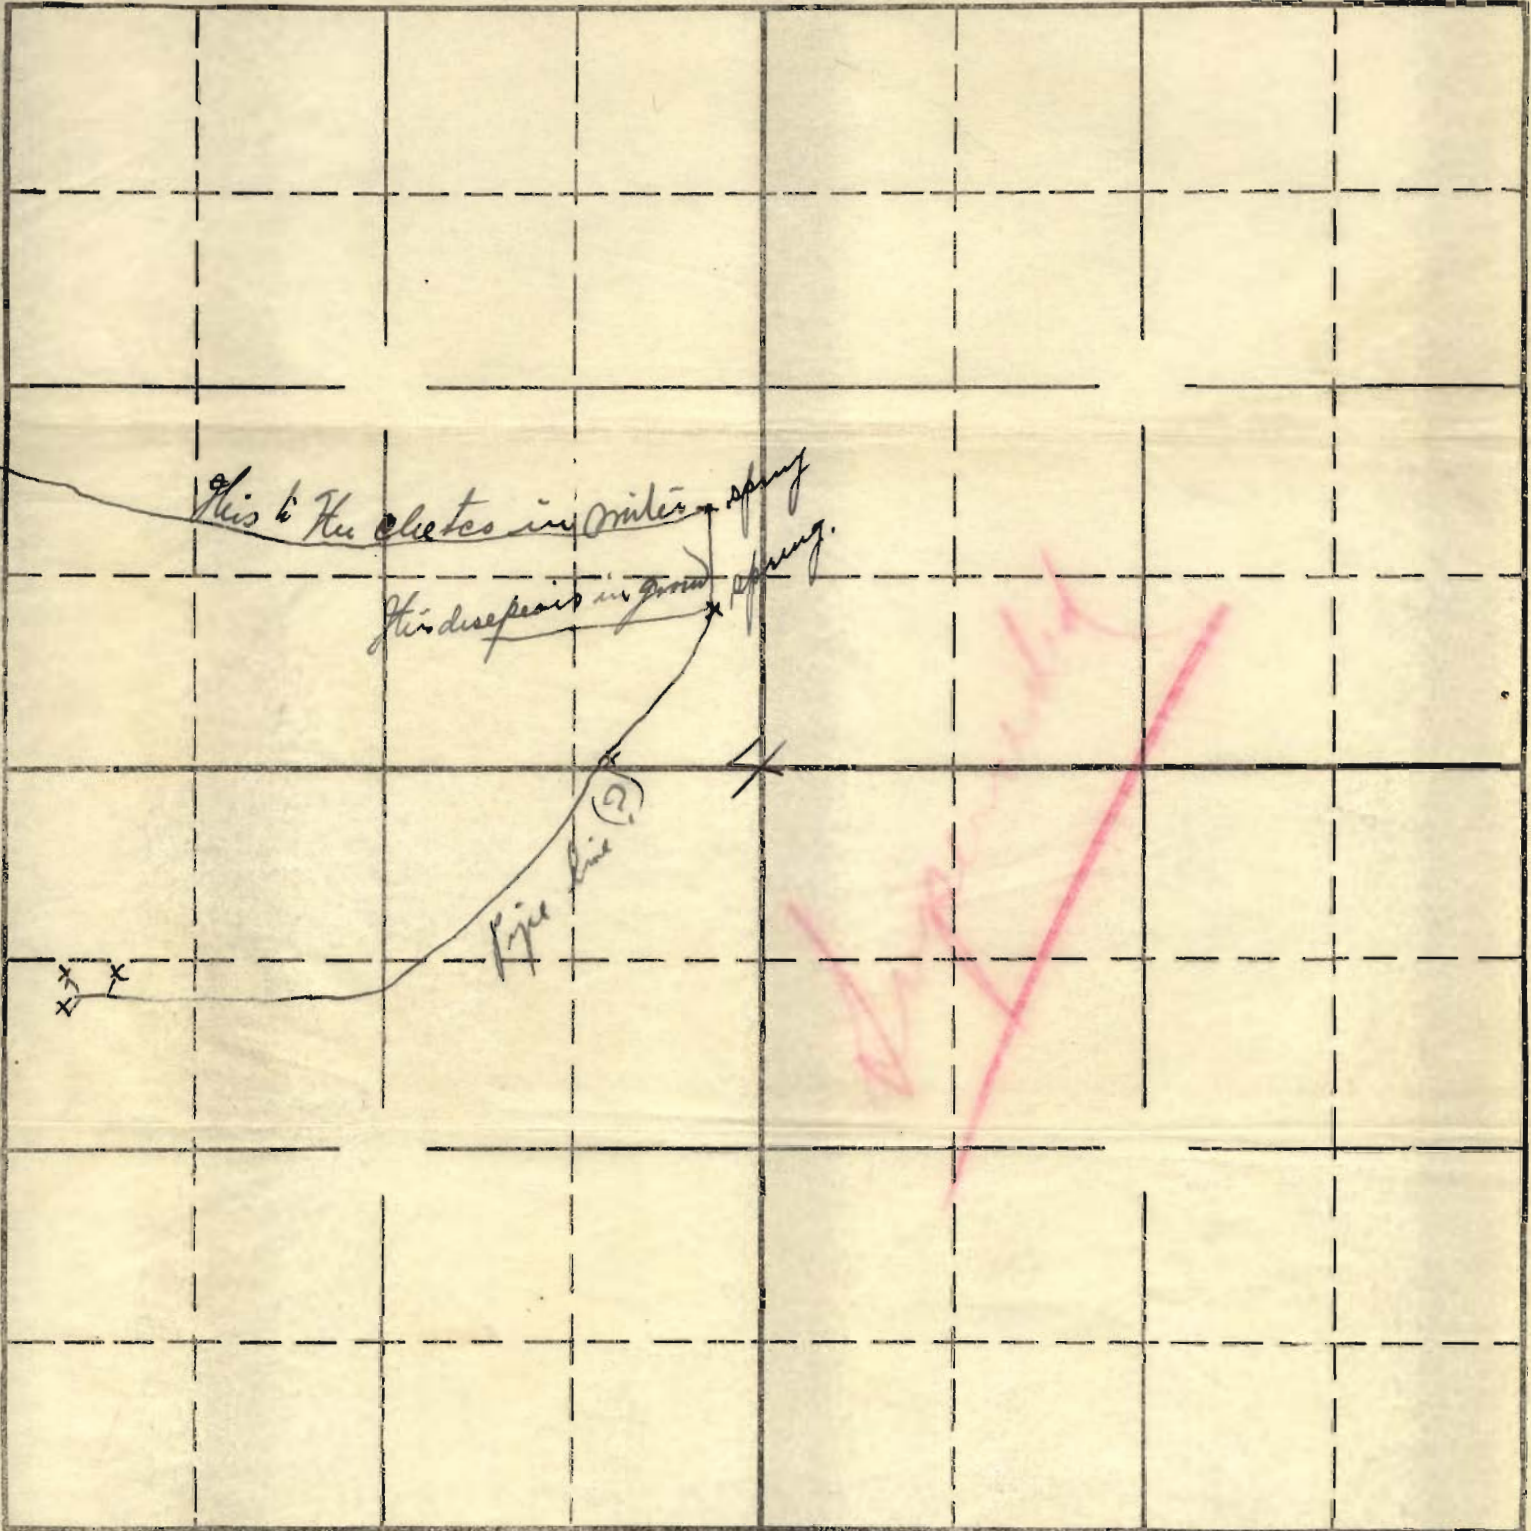

West

East

South

RECEIVED RECEIVED
 APR 2 1934 FEB 23 1934

STATE ENGINEER
 SALEM, OREGON

STATE ENGINEER
 SALEM, OREGON

APPLICATION No.
 PERMIT No.