


SECTION  
36

TOWNSHIP 335, RANGE 1 W, W. M.

North

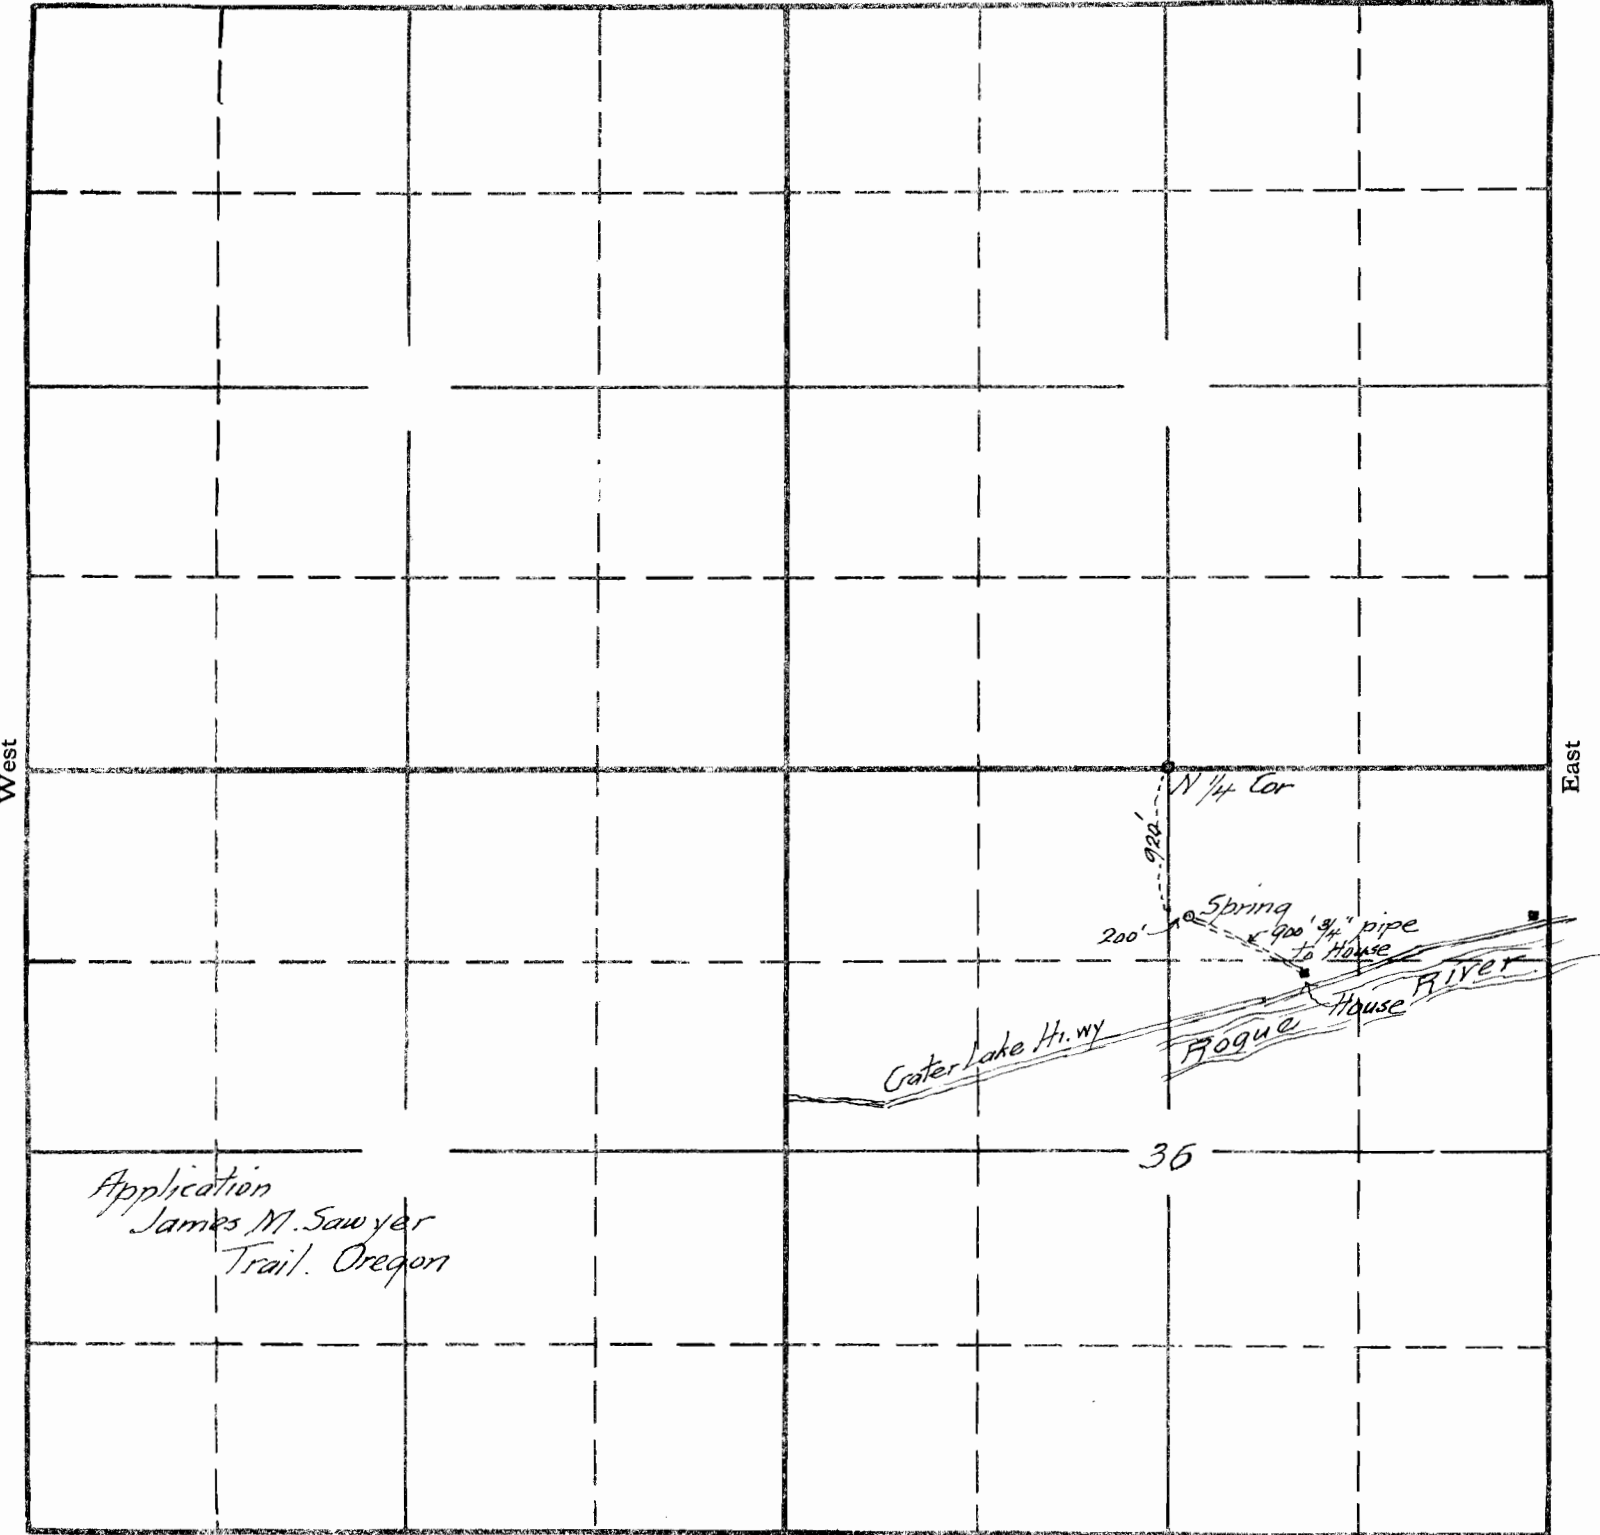

Application  
James M. Sawyer  
Trail, Oregon

36

South

Map made from notes furnished  
by James M Sawyer.

APPLICATION No. 15301  
PERMIT No. 11219