


SECTION

\_\_\_\_\_  
\_\_\_\_\_  
\_\_\_\_\_  
\_\_\_\_\_

TOWNSHIP 135, RANGE 2E, W. M.

North

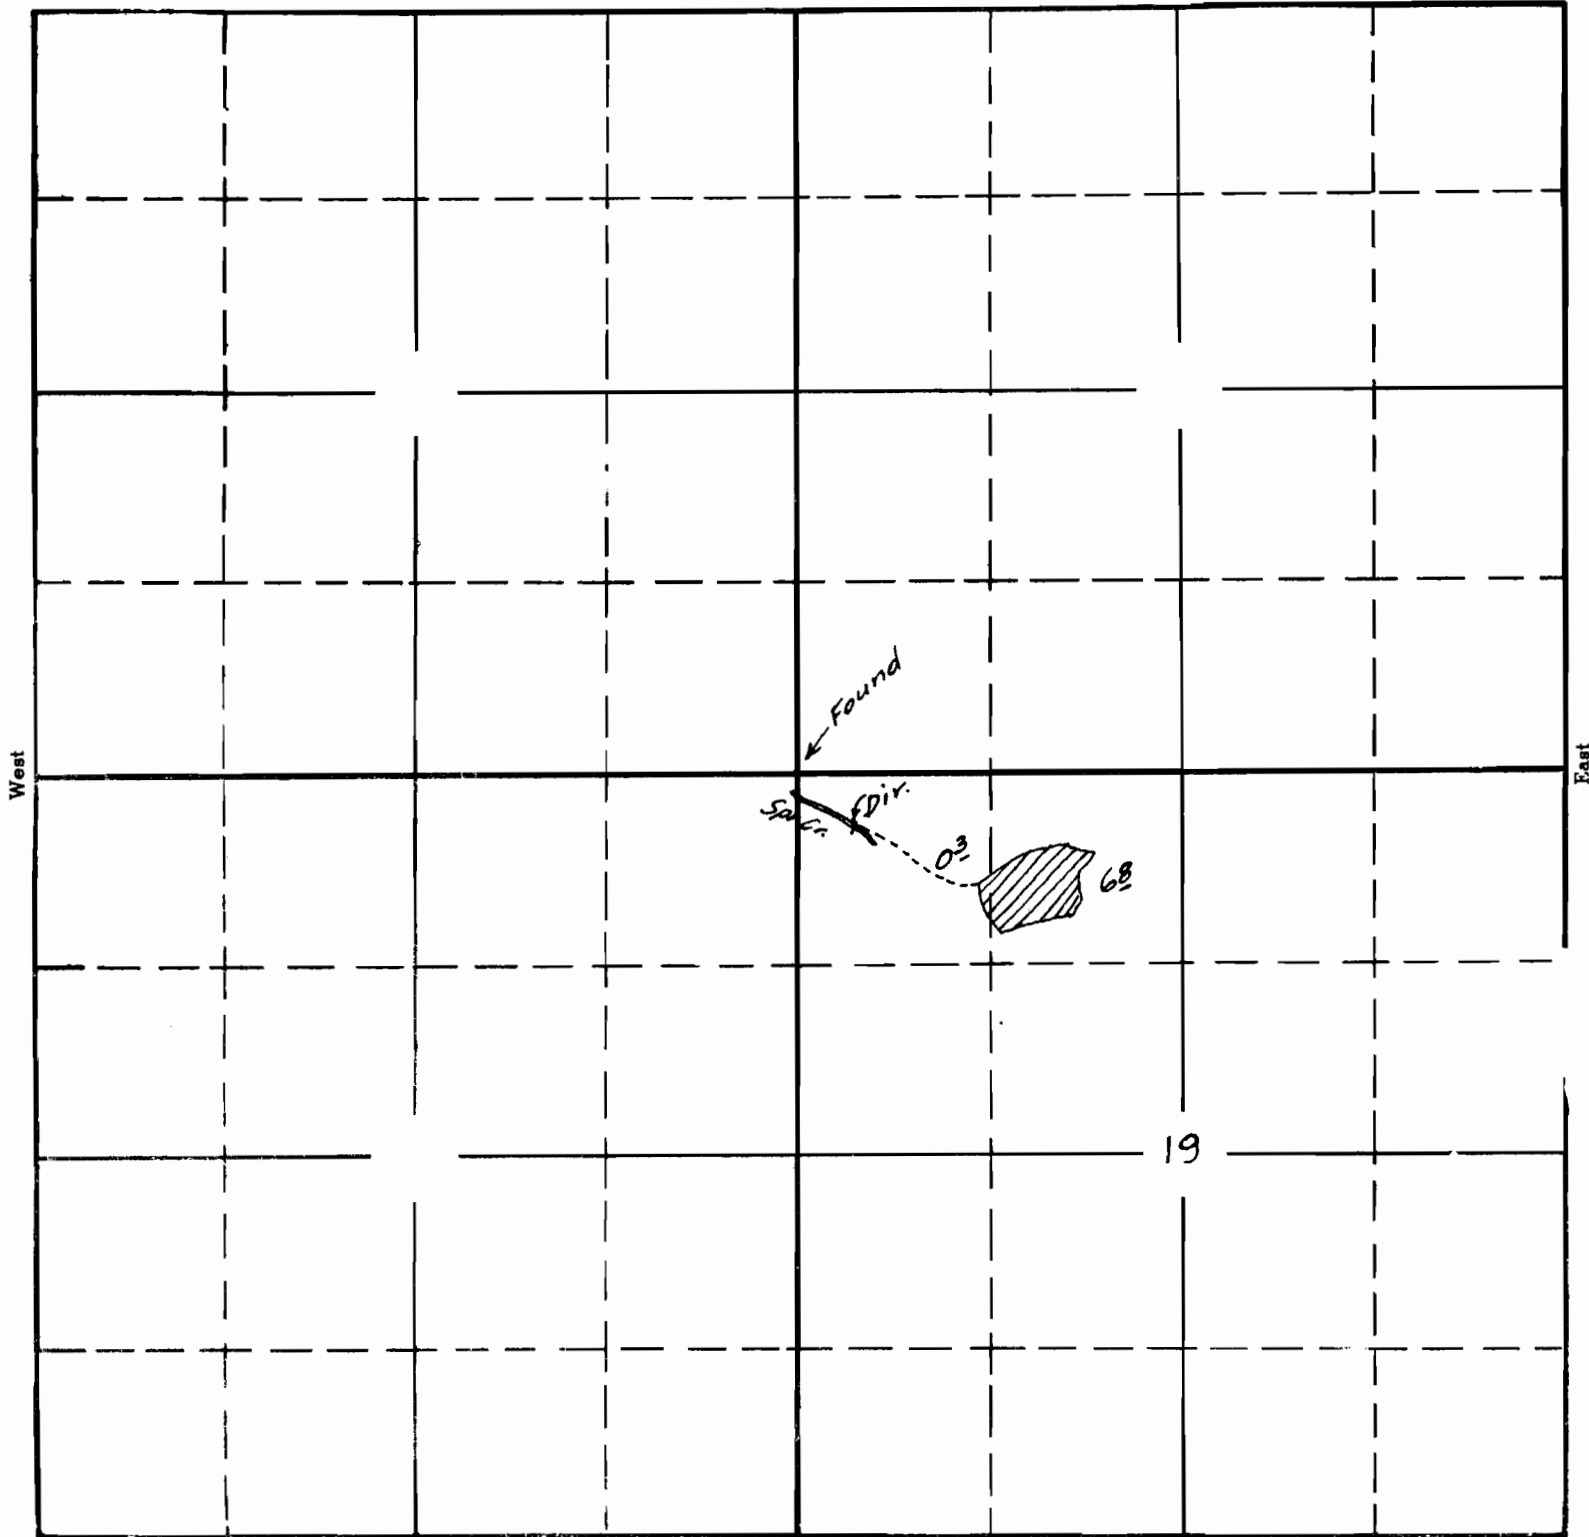

South

APPLICATION No. 15340  
PERMIT No. 11241

