


SECTION

TOWNSHIP 2N, RANGE 7E, W. M.

North

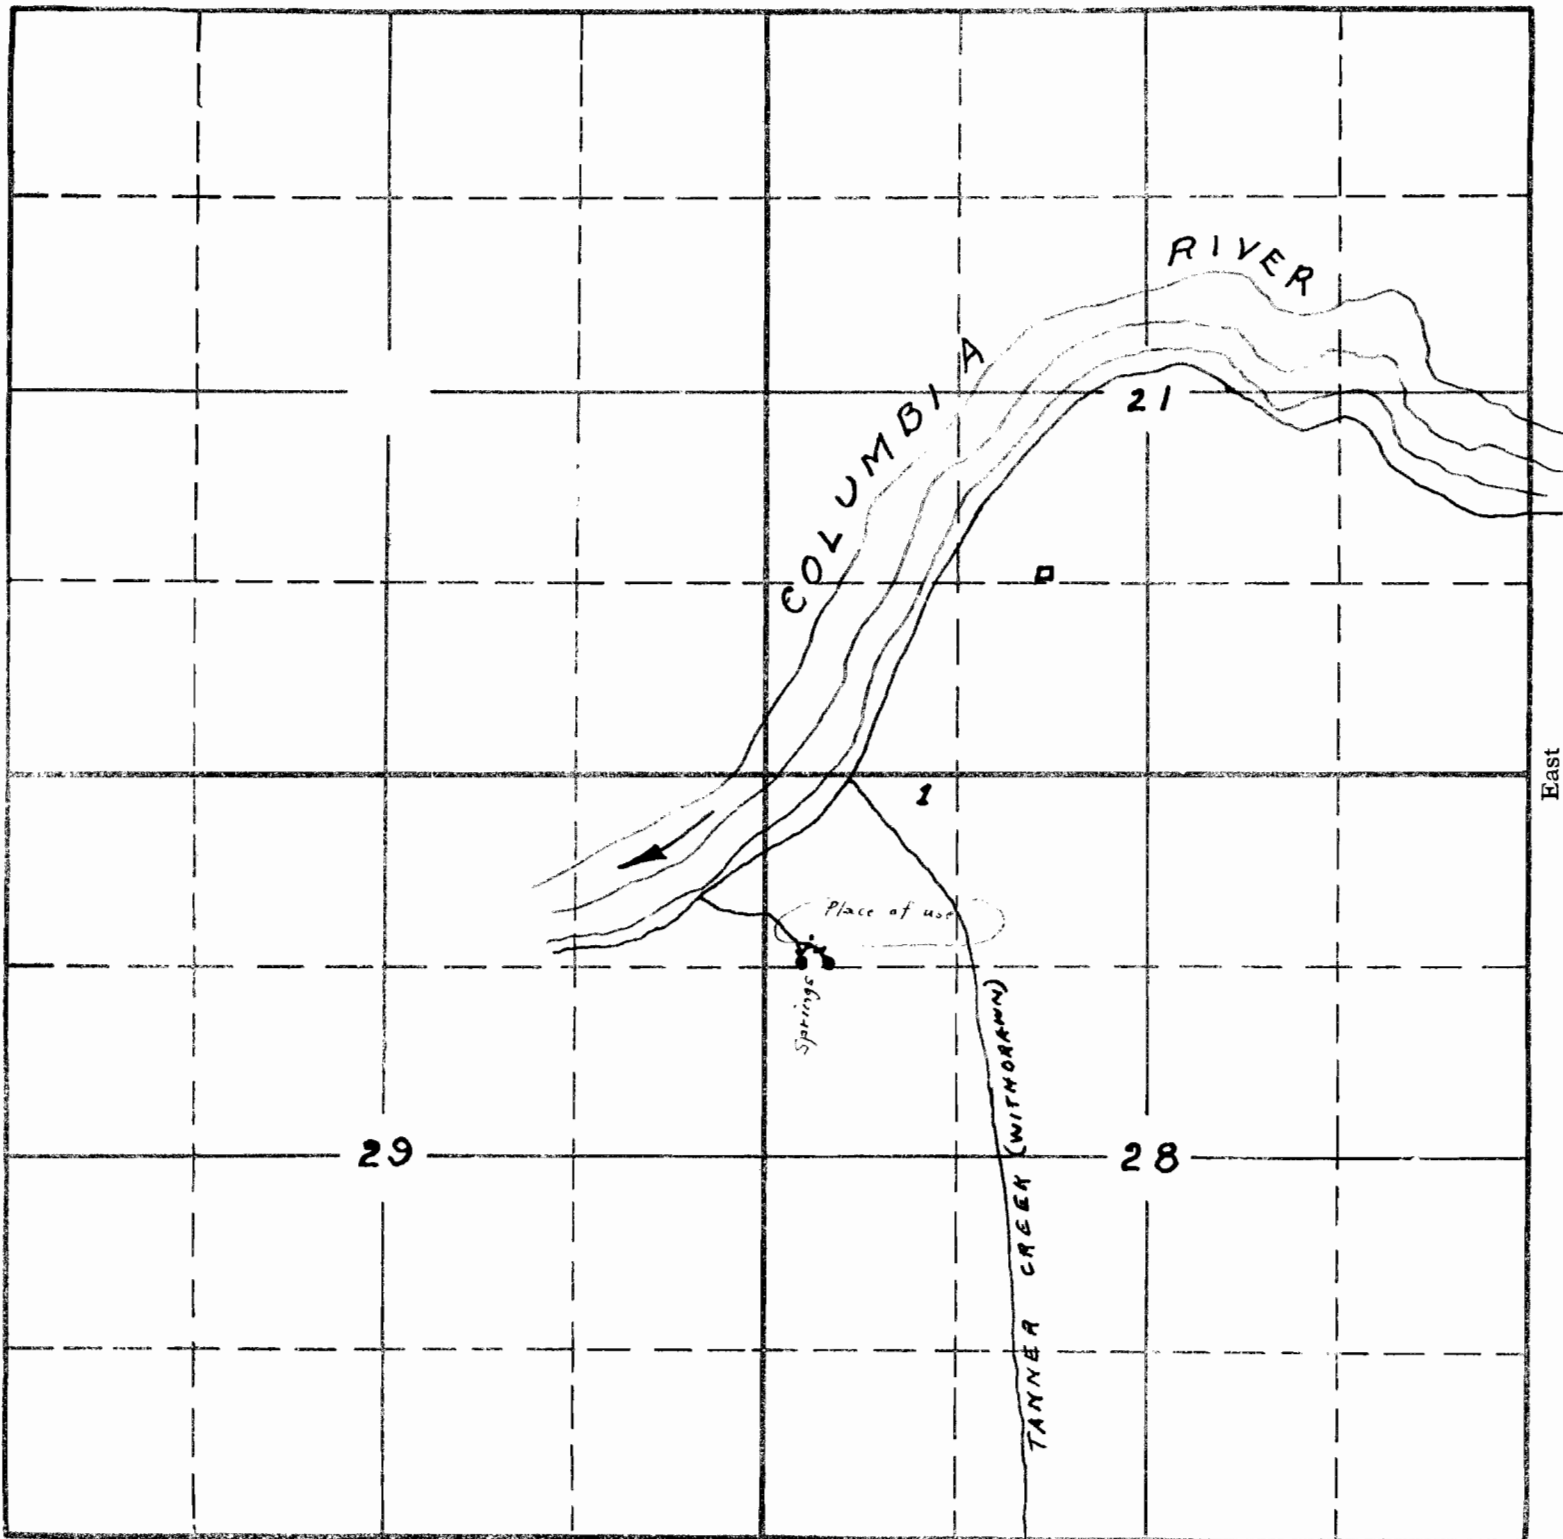

South


Copied from applicant's sketch - 5/12/34.

APPLICATION No. 153~~22~~²⁹
PERMIT No. 11252

SECTION

TOWNSHIP 27, RANGE 7E, W. M.

North

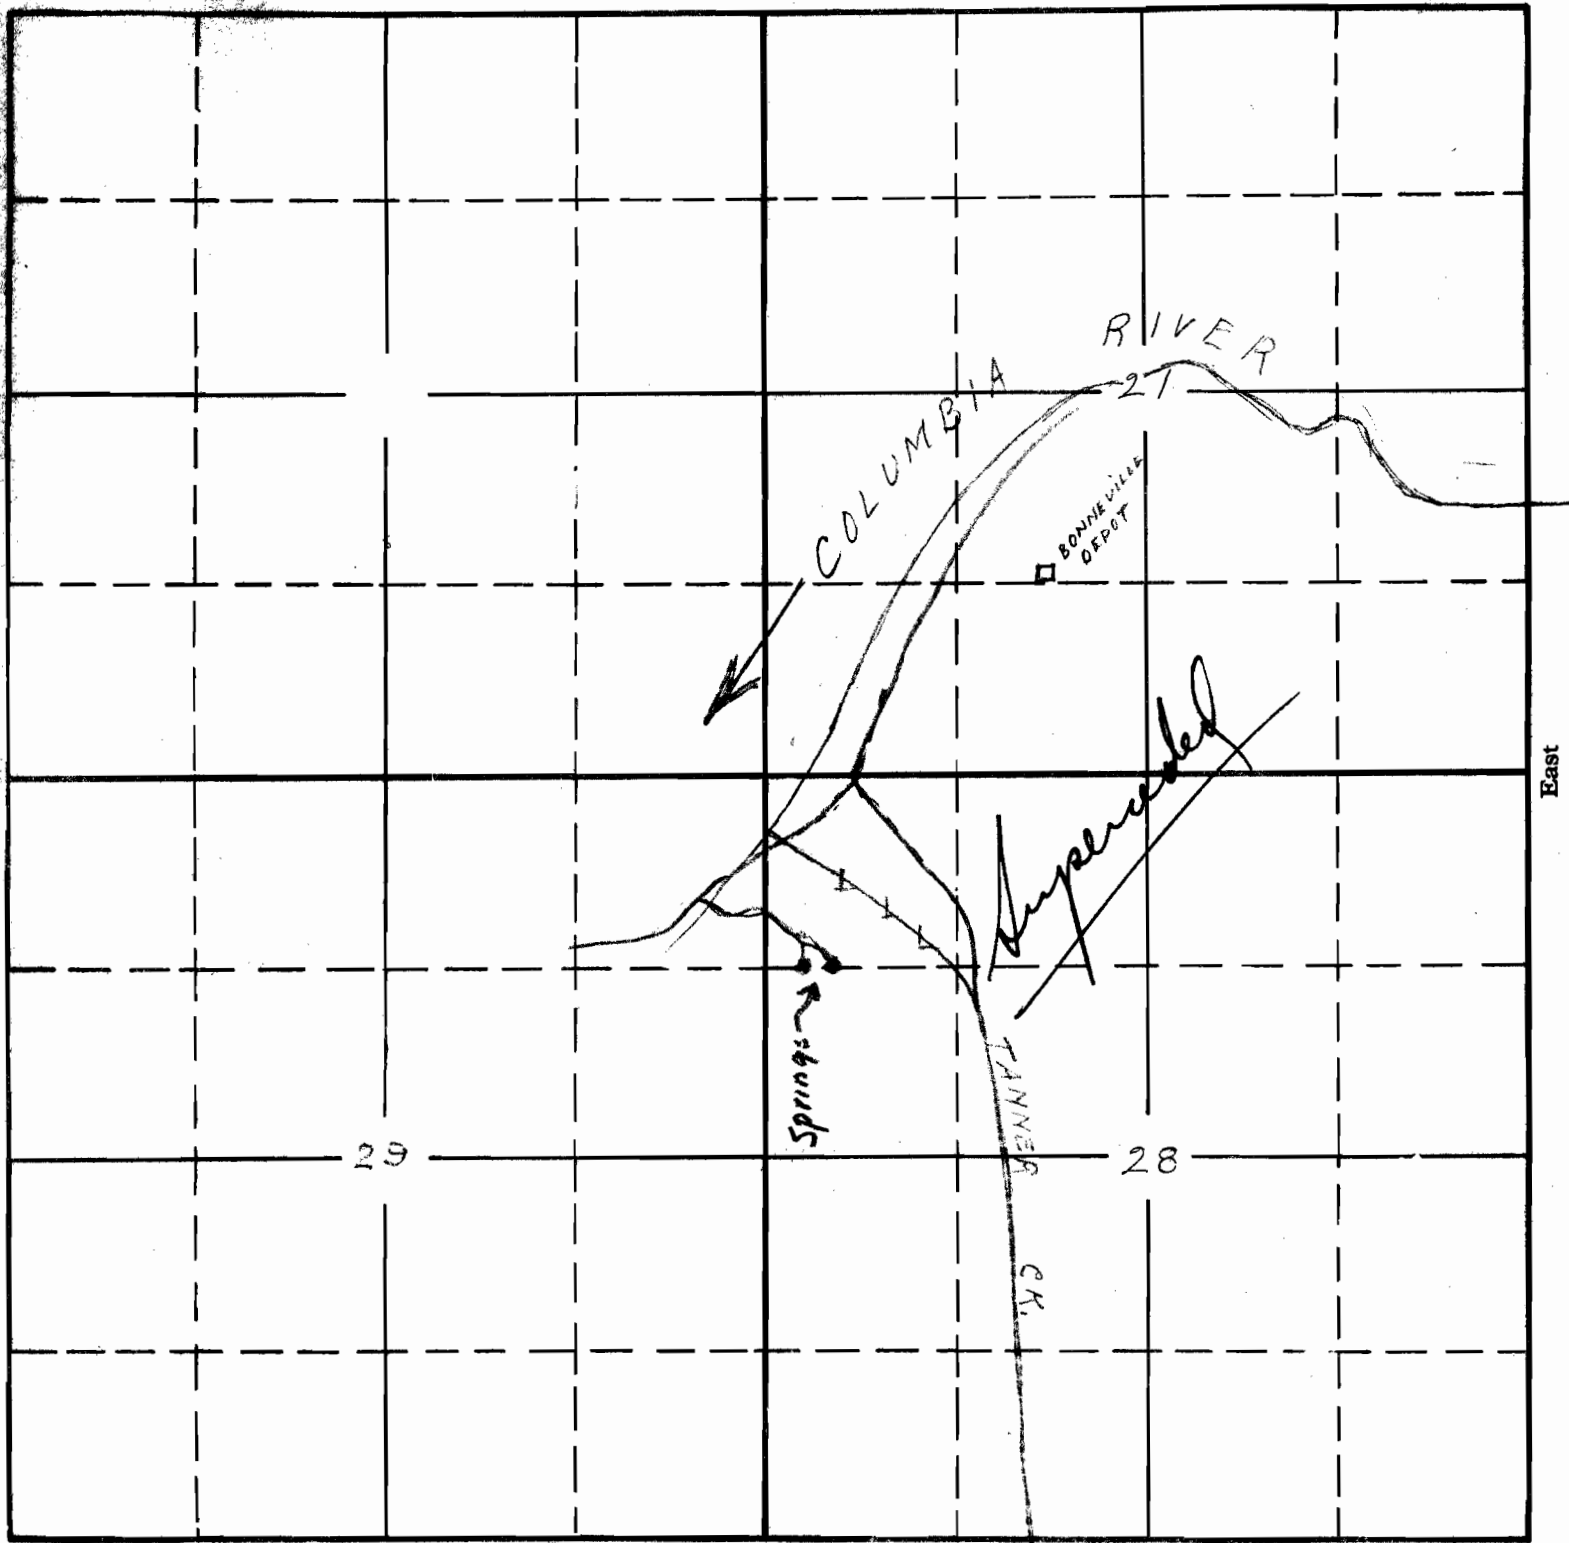

South

RECEIVED
MAY 11 1934


APPLICATION No.
PERMIT No.

STATE ENGINEER
SALEM, OREGON

SECTION
28

TOWNSHIP 2 N, RANGE 7 E, W. M.

North

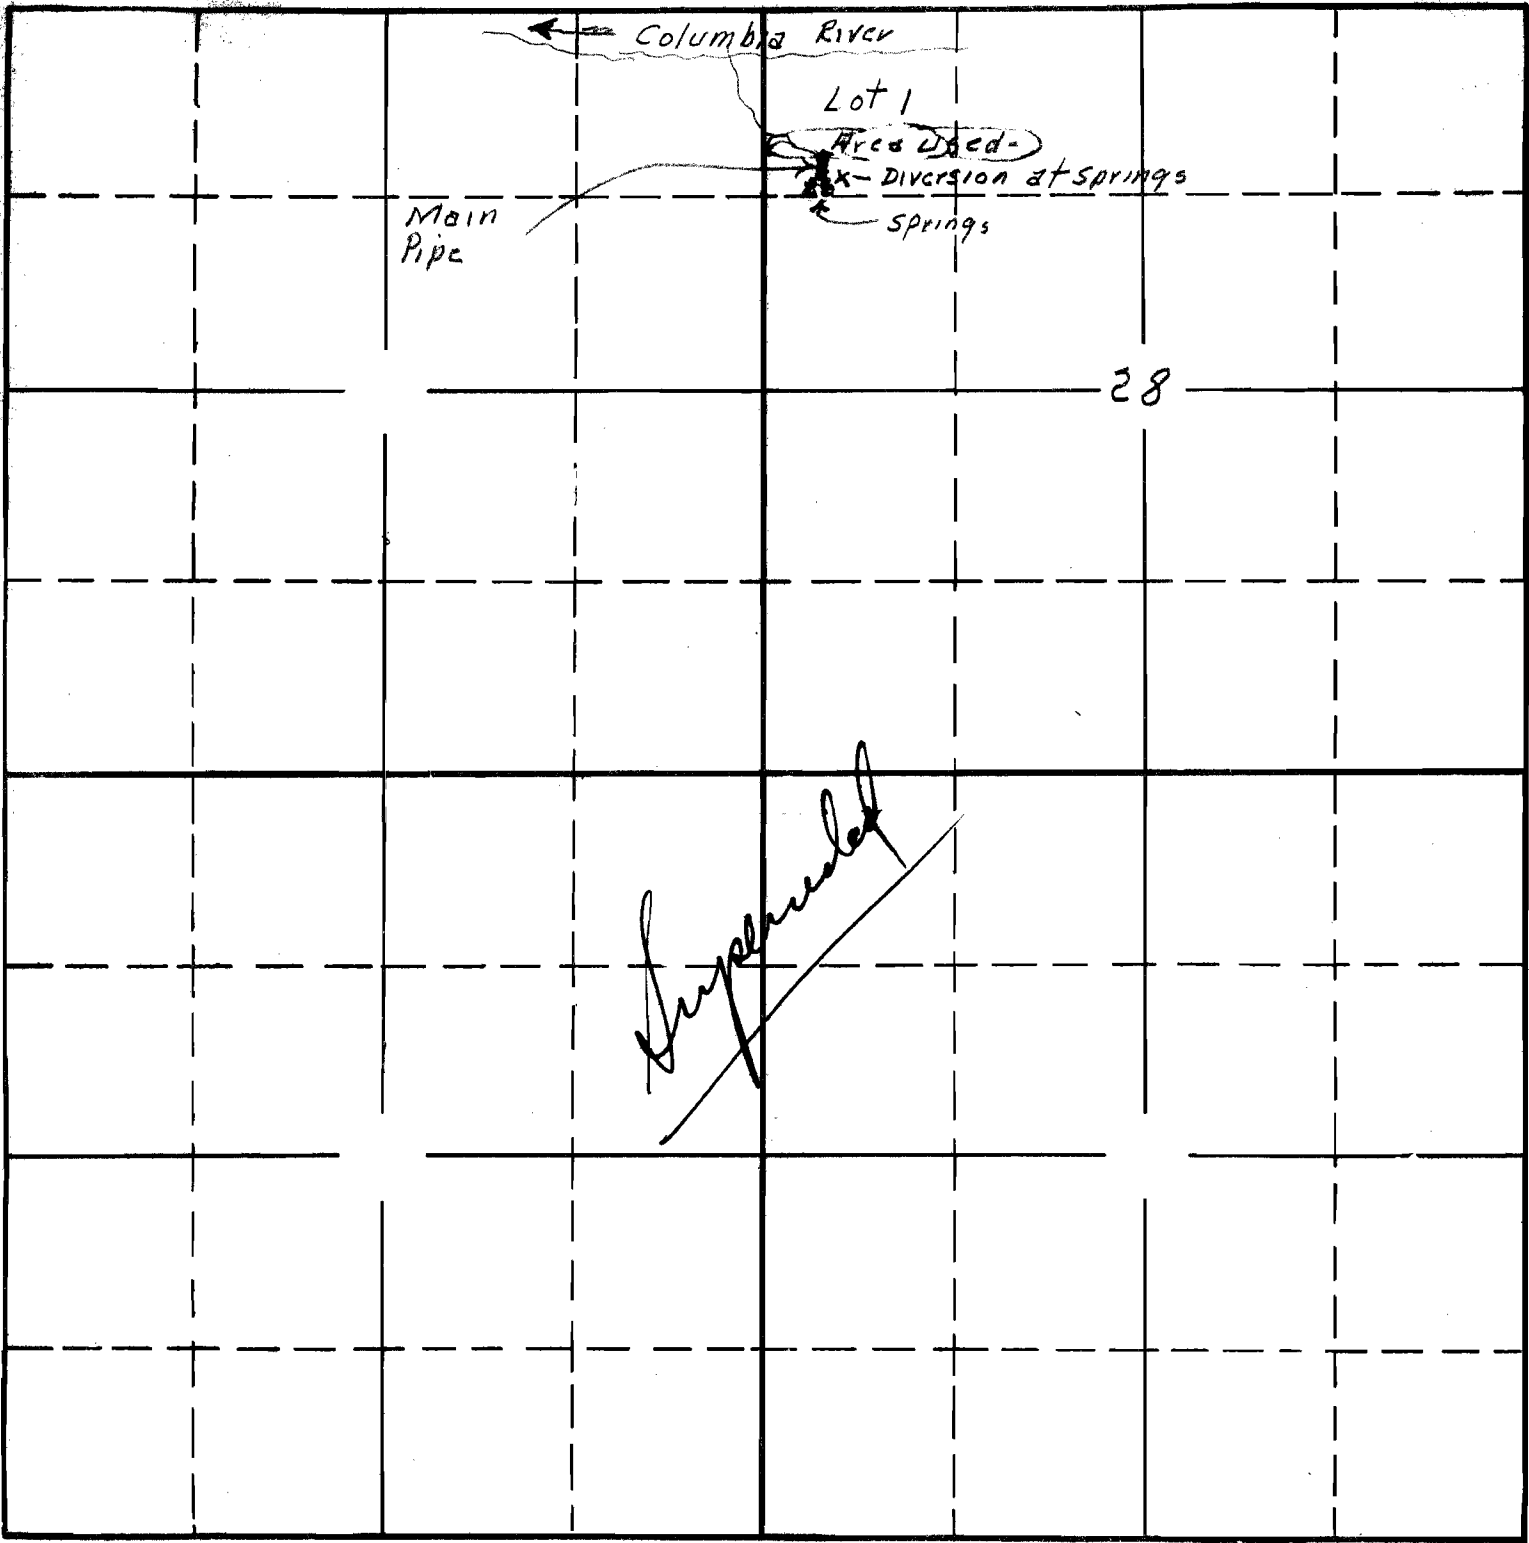

South

RECEIVED
MAY 11 1934

STATE ENGINEER
SALEM, OREGON

RECEIVED
APR 27 1934

STATE ENGINEER
SALEM, OREGON

APPLICATION No.
PERMIT No.