


SECTION

TOWNSHIP 36S, RANGE 6W, W. M.

Howard W. Peeler

North

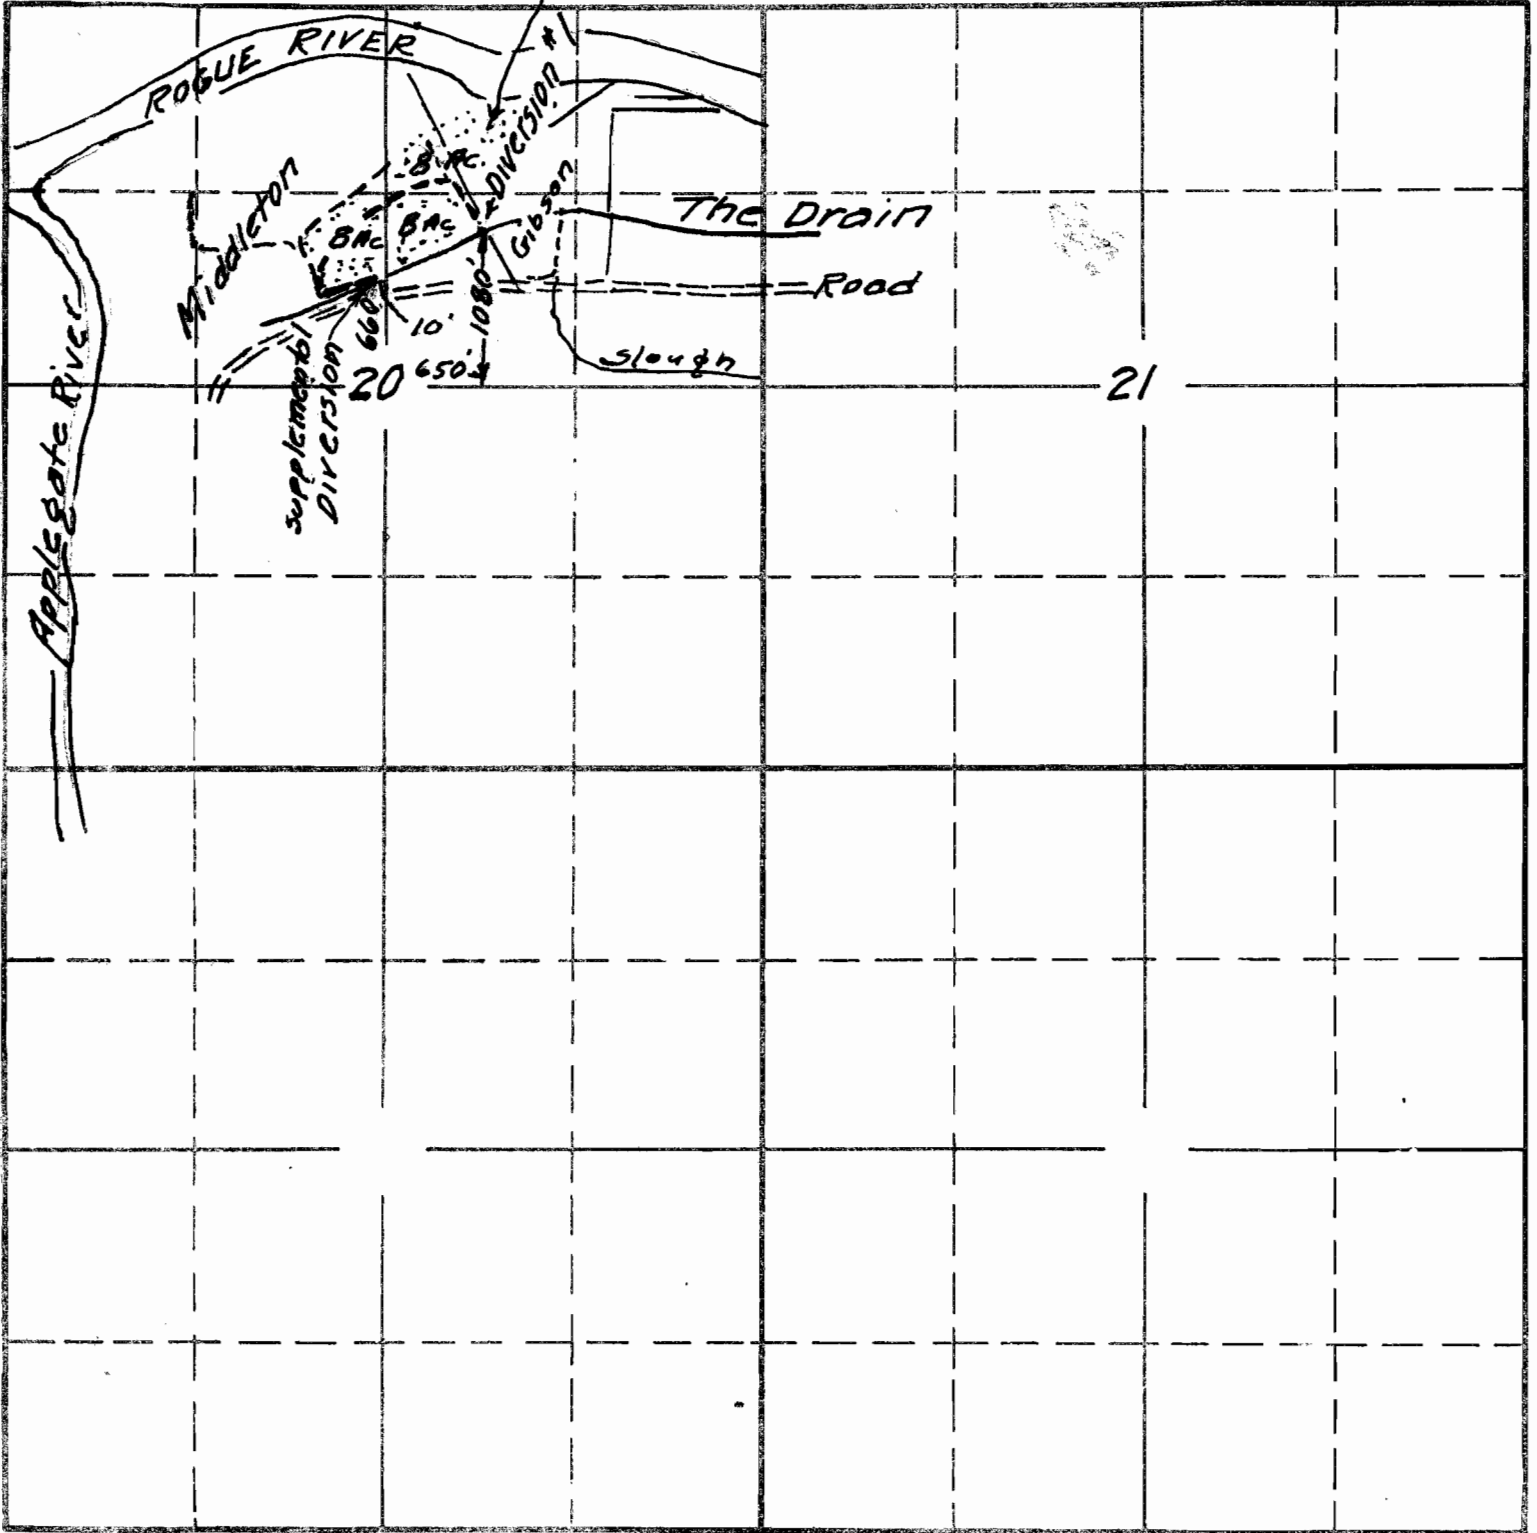

South

APPLICATION No. 15359

PERMIT No. 11261