


SECTION

Permit: S 11262
Volume: 7
Strm: COLD SPRS
Trib: MILLER CR
Priority: 5/15/34

2
4

TOWNSHIP 37S, RANGE 5

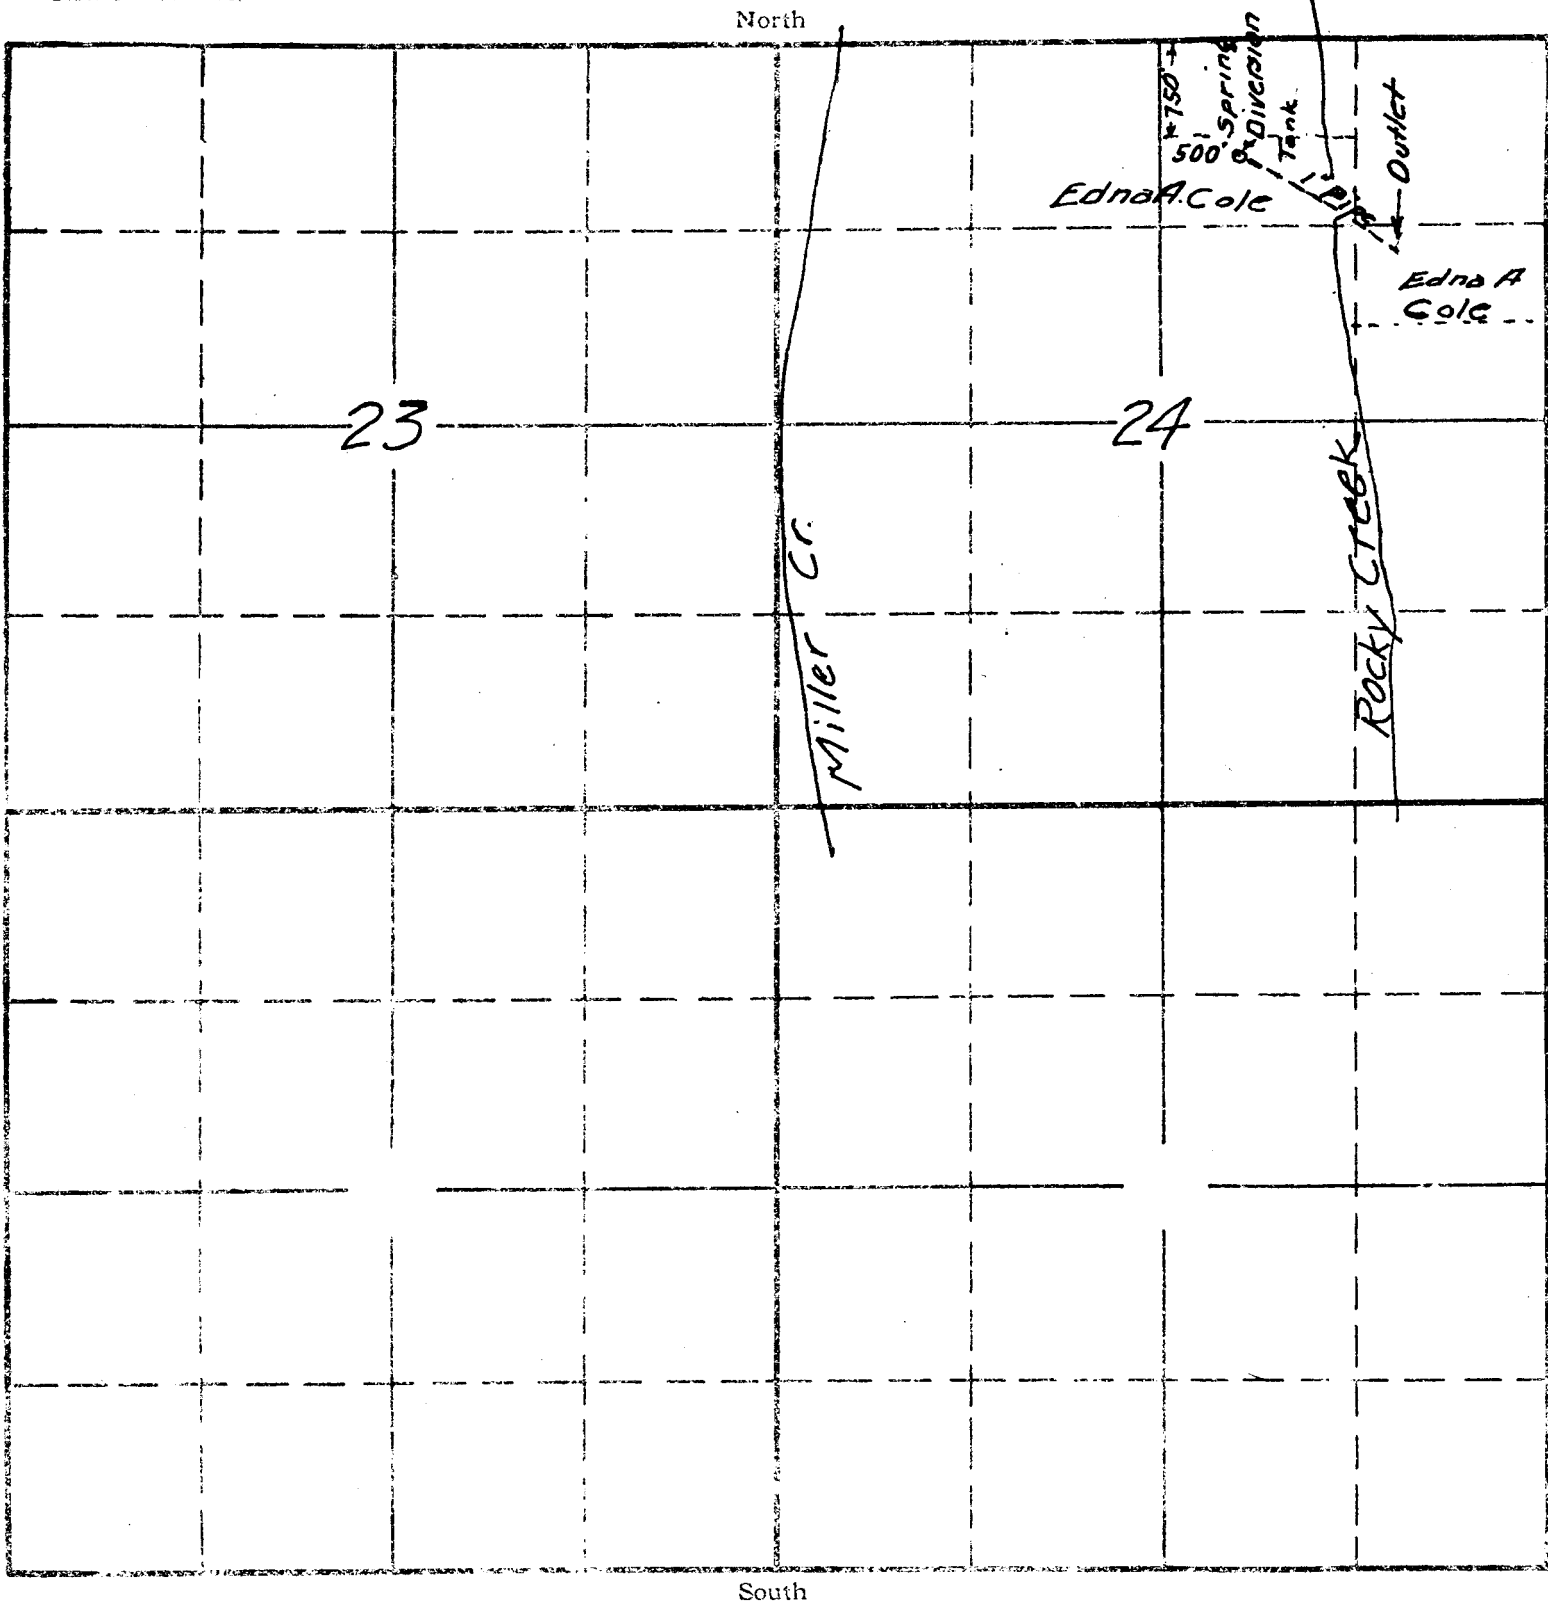

APPLICATION No. 15360
PERMIT No. 11262