


SECTION

23

TOWNSHIP 75 , RANGE 3W , W. M.

North

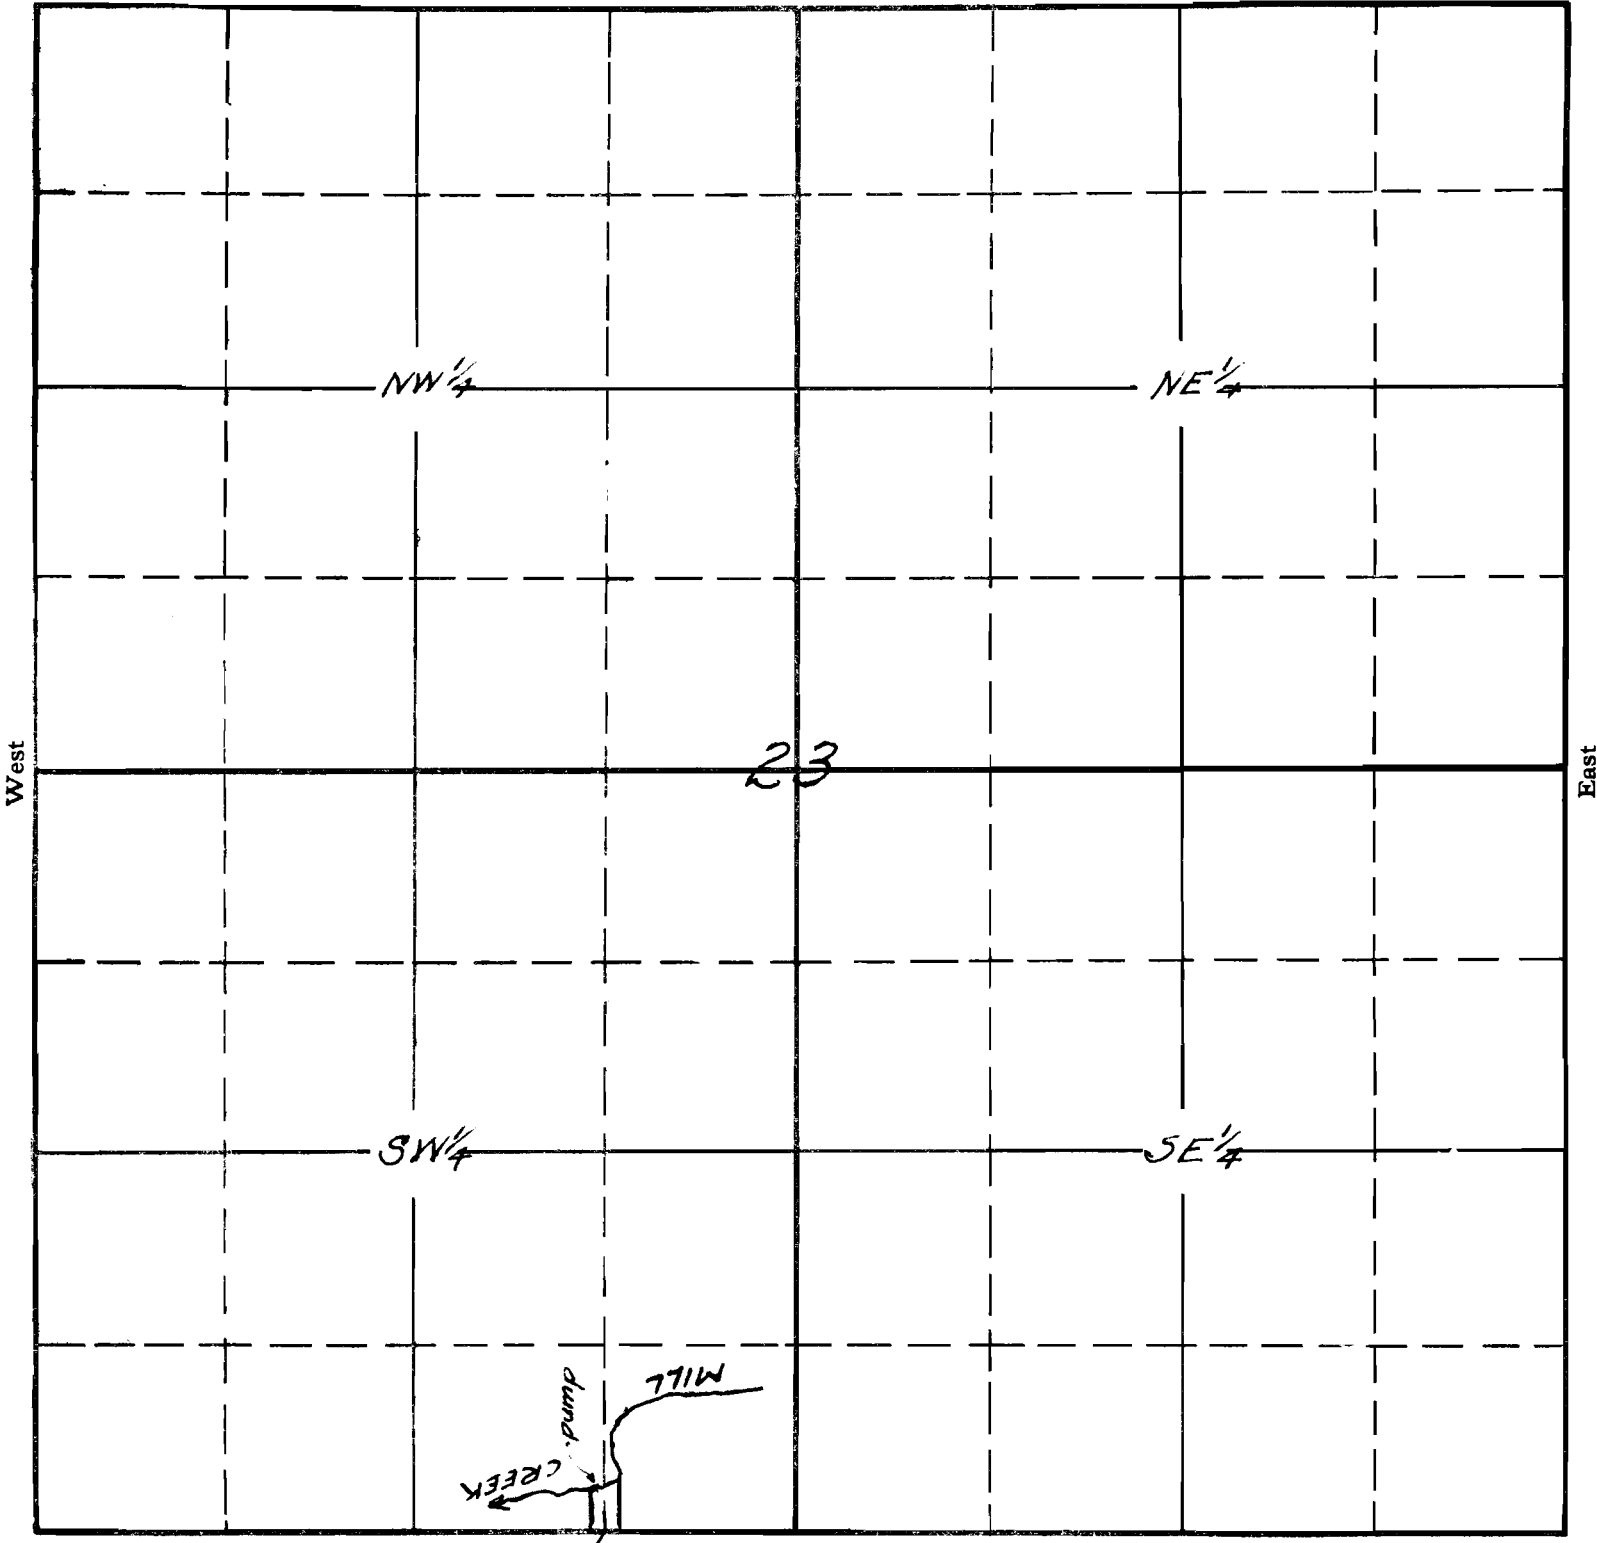

South

APPLICATION No. 15367

*Lot 4, Block 4, Reeds Add, City of Salem.
(150' x 50')

PERMIT No. 11266