

10N1


15 14



Scale 1" = 400'

NE 1/4 of NW 1/4 Sec. 14
T. 37 S. R. 1 W., W.M.

40A.

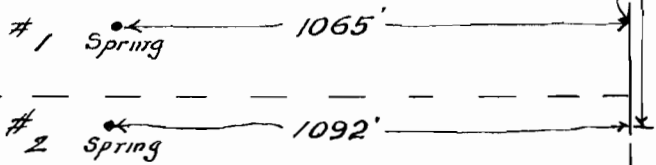

S.E. 1/4 of NW 1/4 Sec. 14
T. 37 S. R. 1 W., W.M.

40A.

City of Medford
Sketch showing location
of Springs in Prescott
Memorial Park

May - 1934

app. No. 15373
Per. No. 11270

D.T. McDonough
City Engineer
F.W. Scheffel
City Supt.