

19 20
30 29


RECEIVED
MAY 31 1934
STATE ENGINEER
SALEM, OREGON

SURVEYORS CERTIFICATE

I, W.E. Anderson County Surveyor of Tillamook County, do hereby certify that this map was made from notes taken during an actual survey made by me May 7, 1934, and that it correctly represents the works herein shown.

W.E. Anderson C. Surv.

N.W. COR. OF THE SE 1/4 OF THE
N.W. 1/4 OF SEC 29, T.3, S.R.9, W.M.

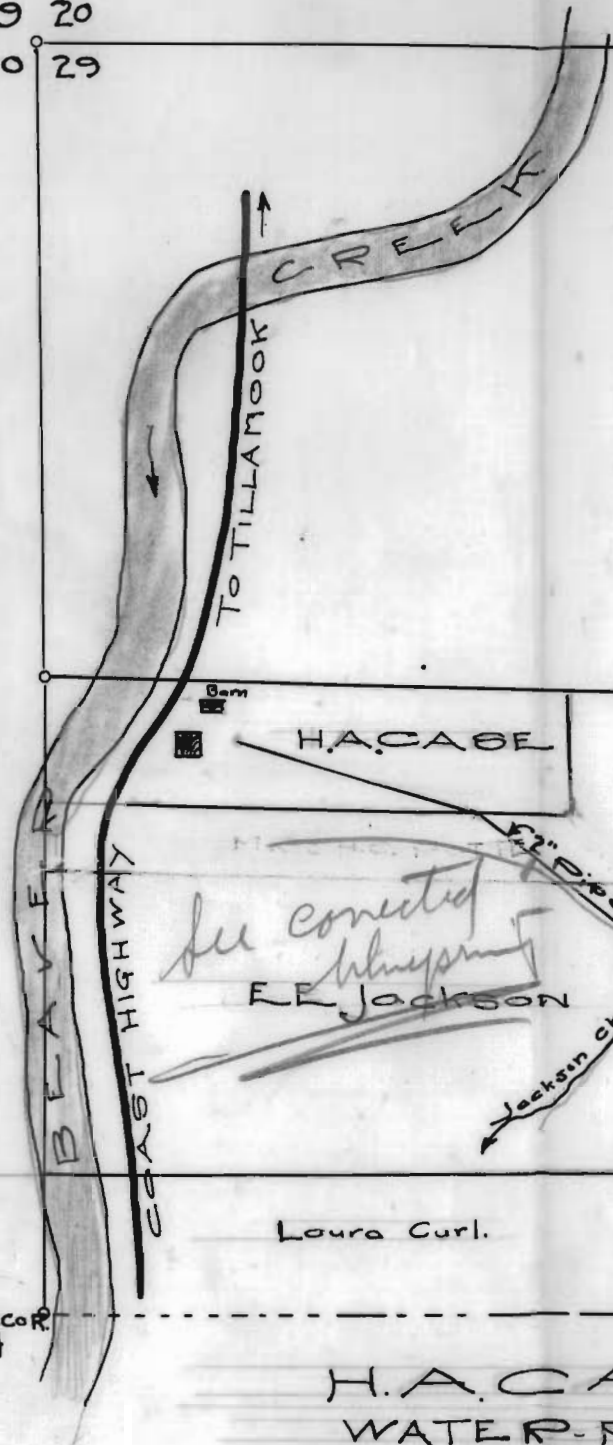

H.A. CASE

H. O. Brimhall

ER Jackson

Laura Curl.

POINT OF DEVIATION

H.A. CASE
WATER-RIGHT
SEC 29, T.3, S.R.9, W.M.
TILLAMOOK CO, ORE
Scale 1" = 400.



app. No. 15376
Per. No. 11272