


SECTION

32

TOWNSHIP 7S, RANGE 5W, W. M.

North

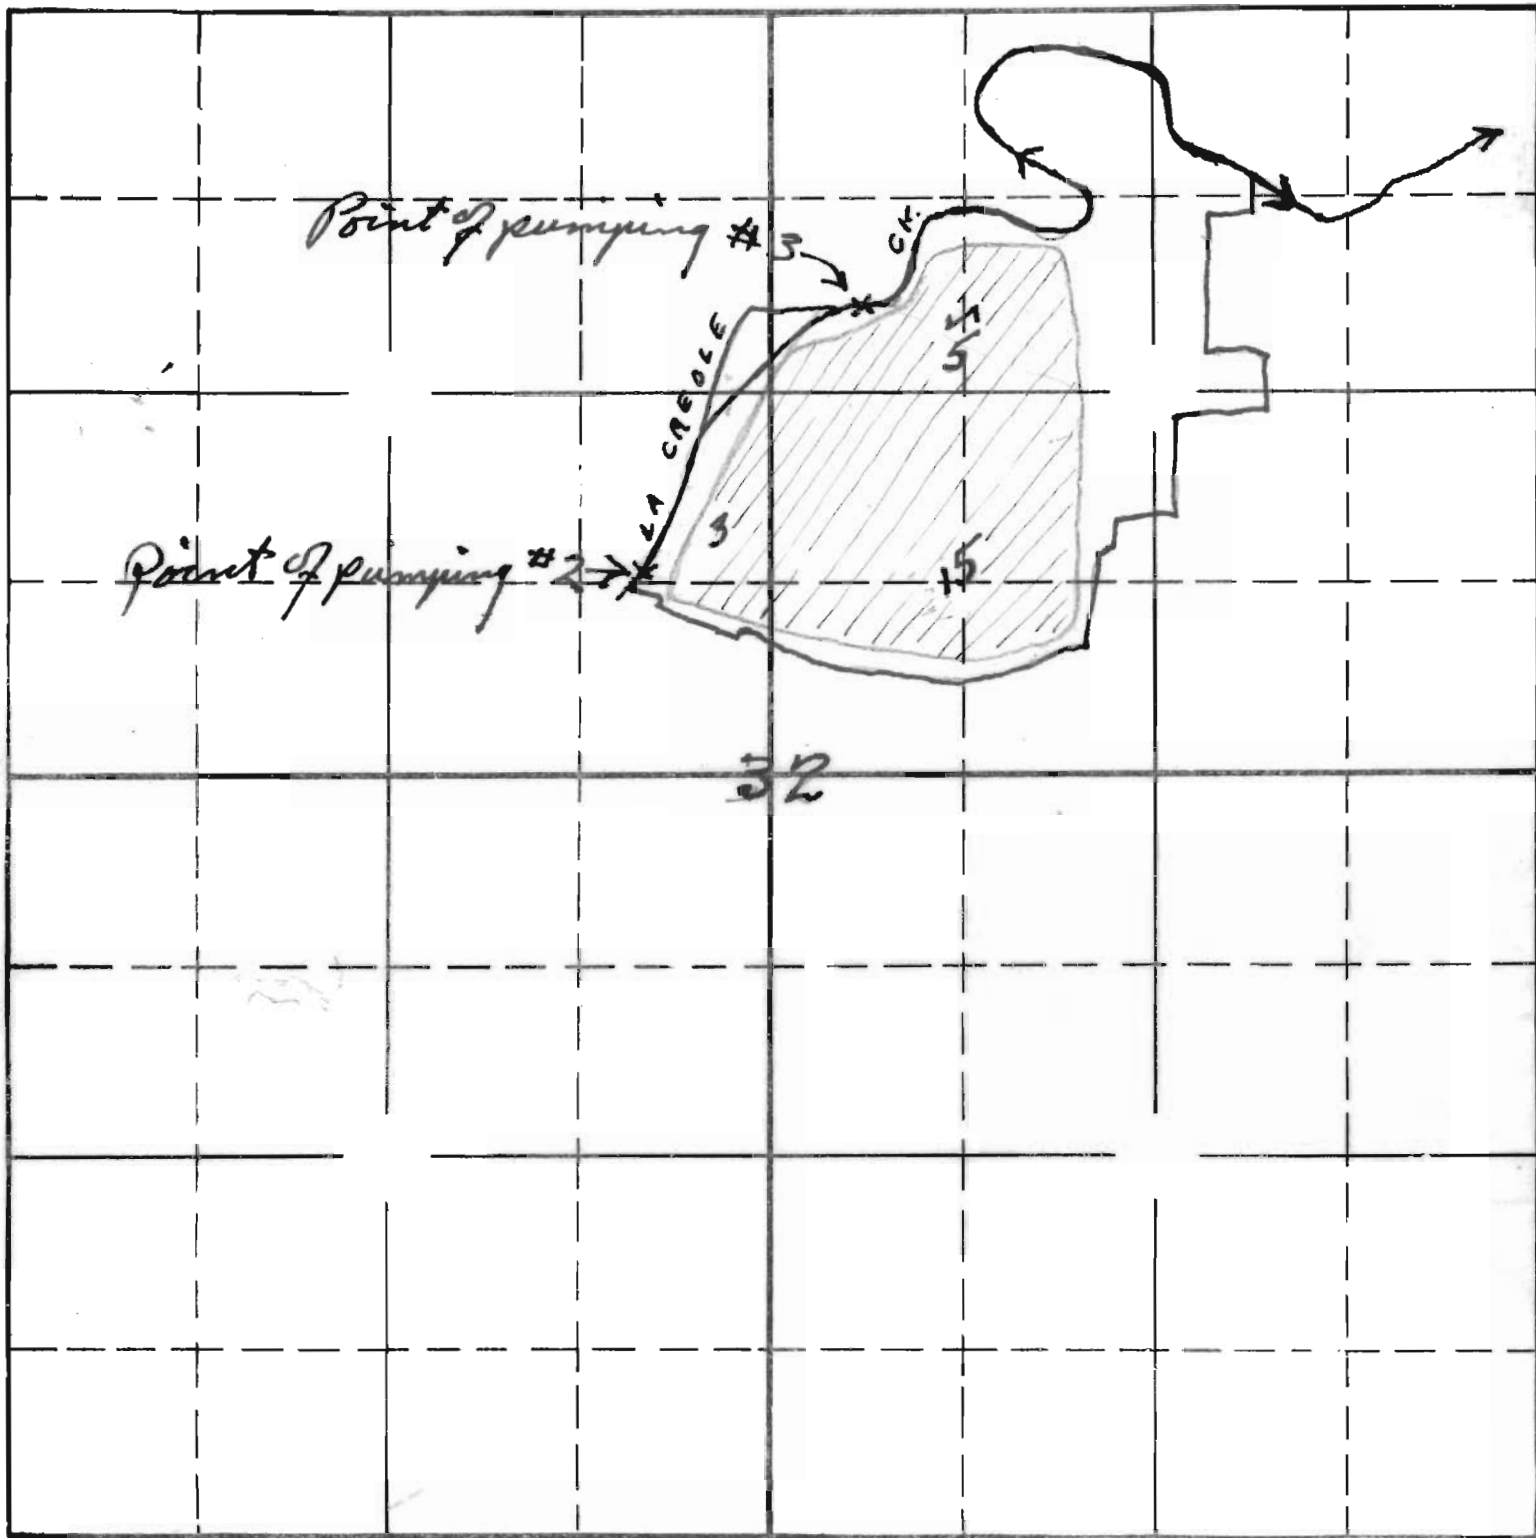

South

25 Two Maps
Sections 32 + 33

APPLICATION No. 15382


PERMIT No. 11276

SECTION

33

TOWNSHIP 75, RANGE 5W, W. M.

North

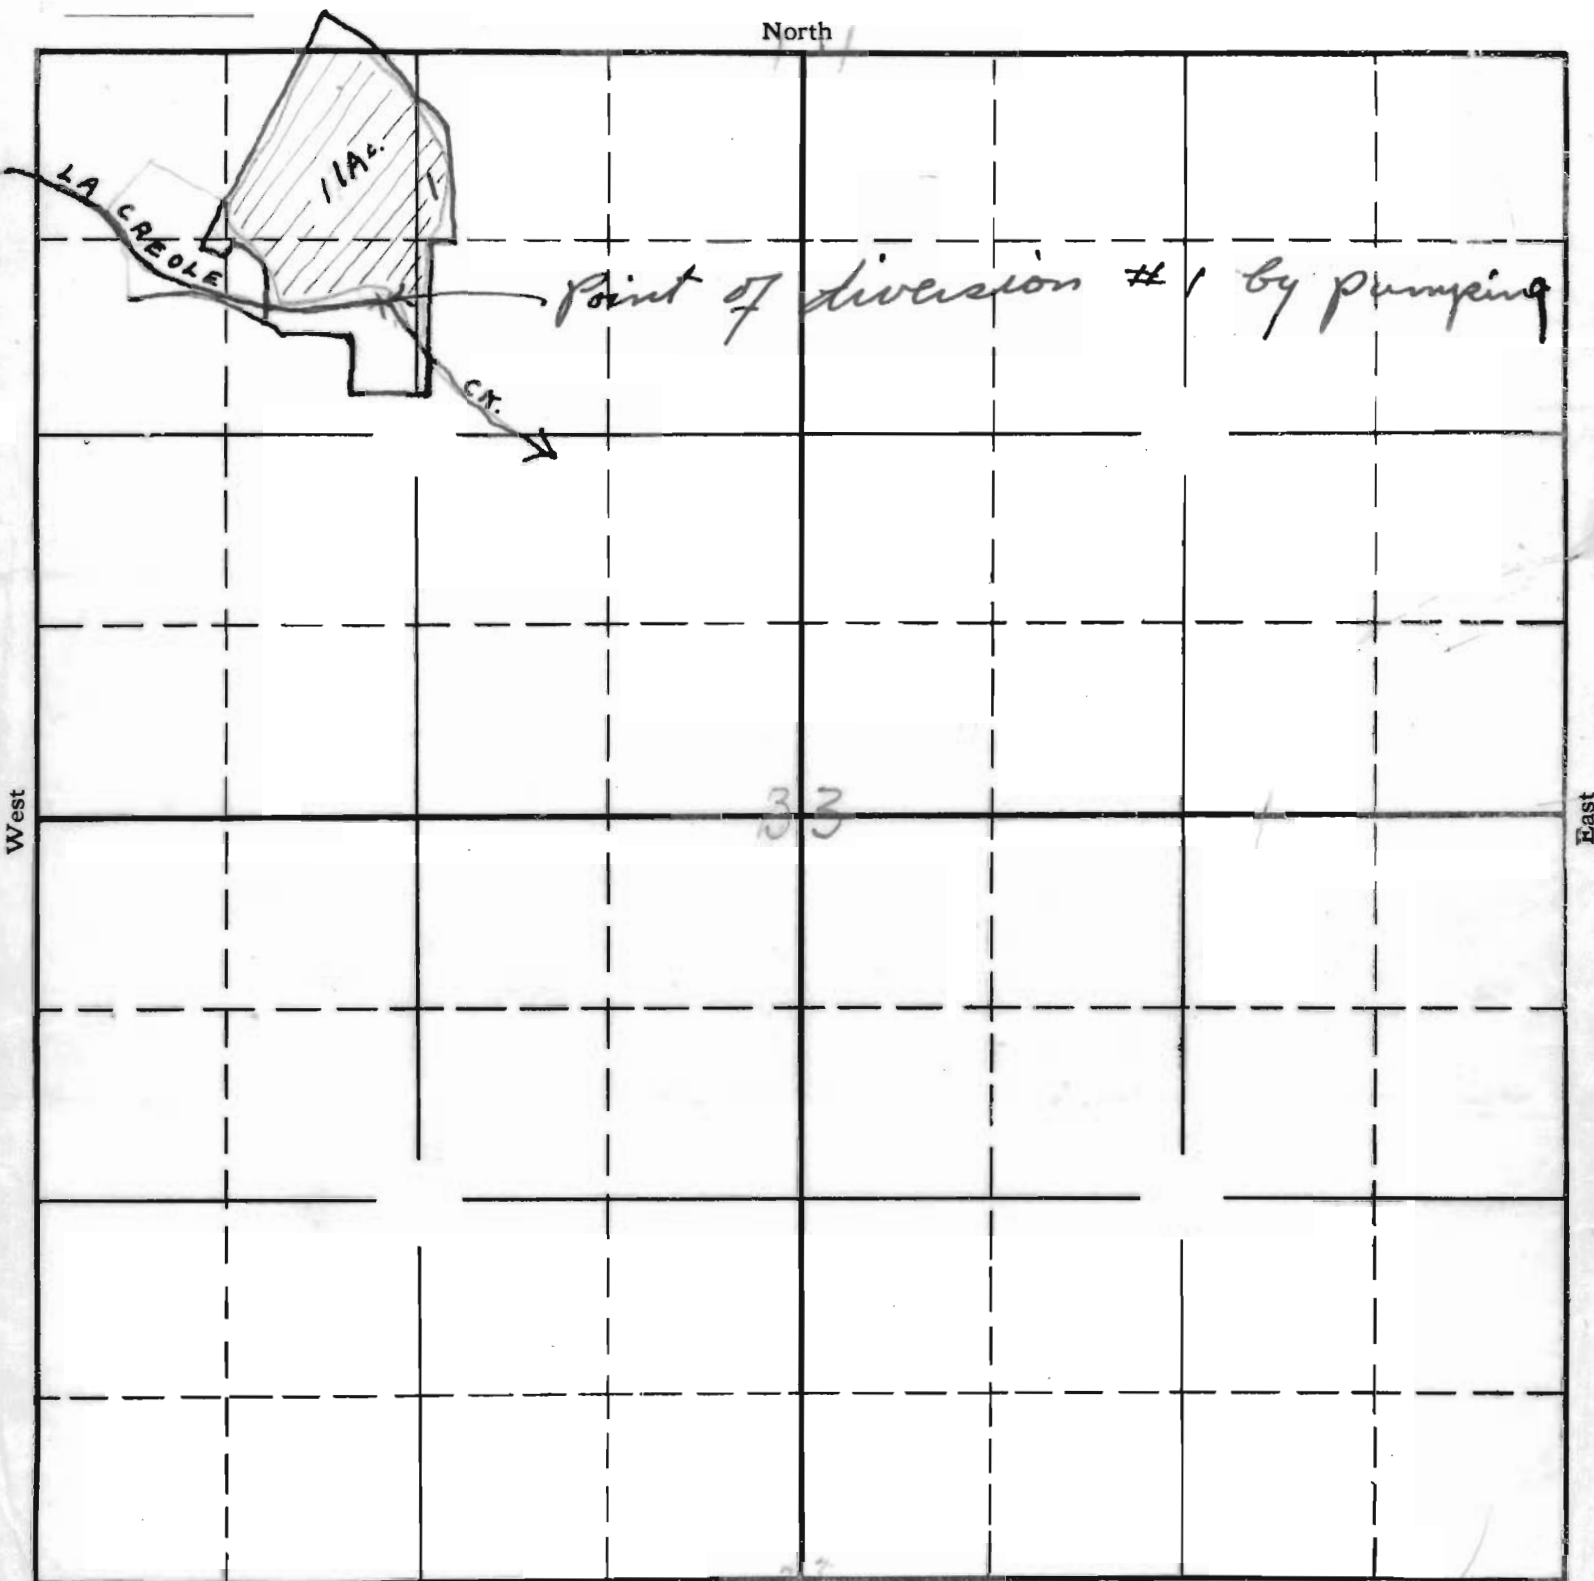

Two Maps
Section 32 & 33 -

APPLICATION No. 15382

PERMIT No. 11276