


SECTION

TOWNSHIP 35, RANGE 2E, W. M.

North

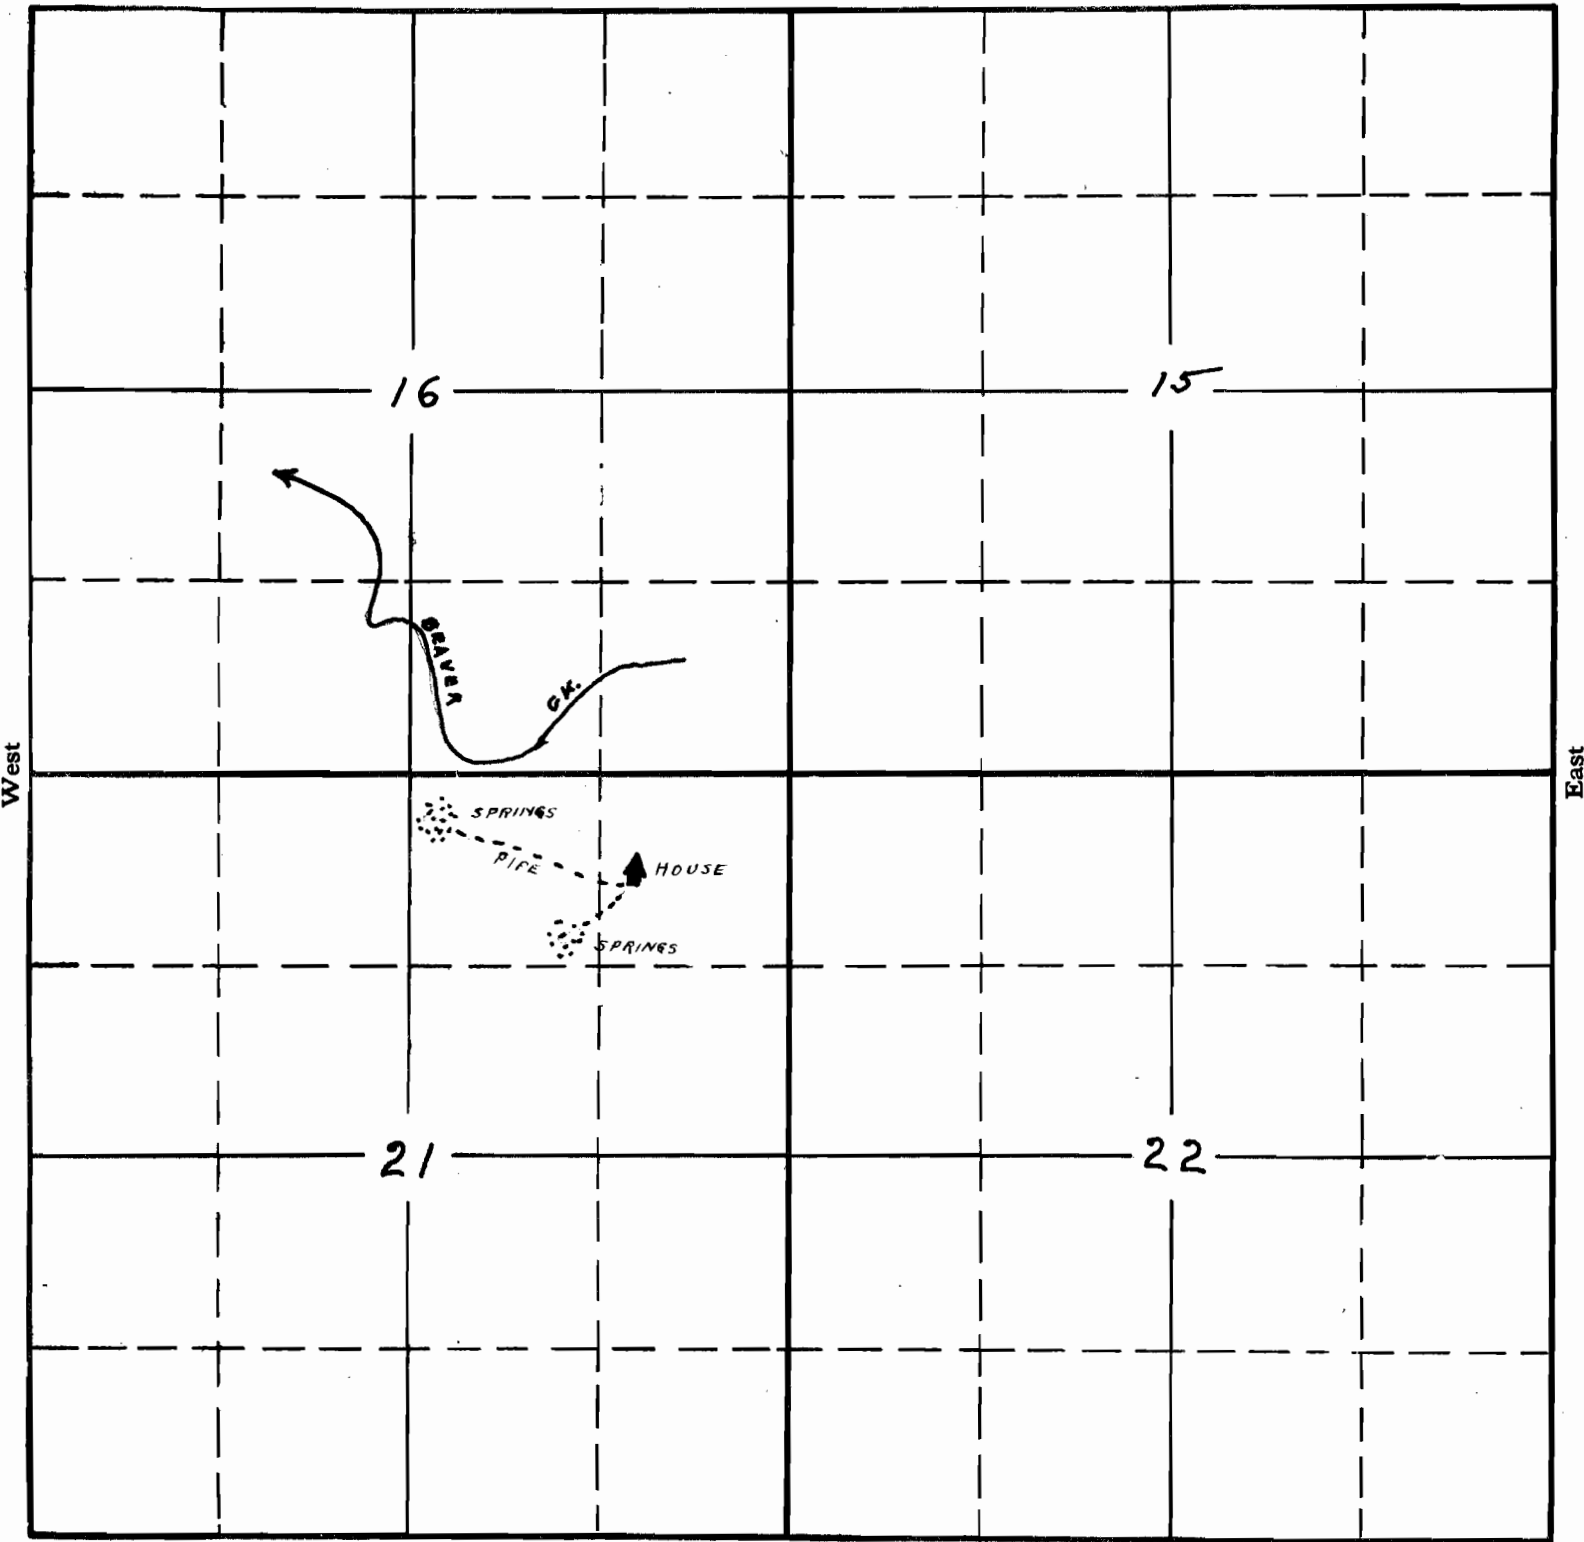

West


East

South

APPLICATION No. 15345

PERMIT No. 11286

North

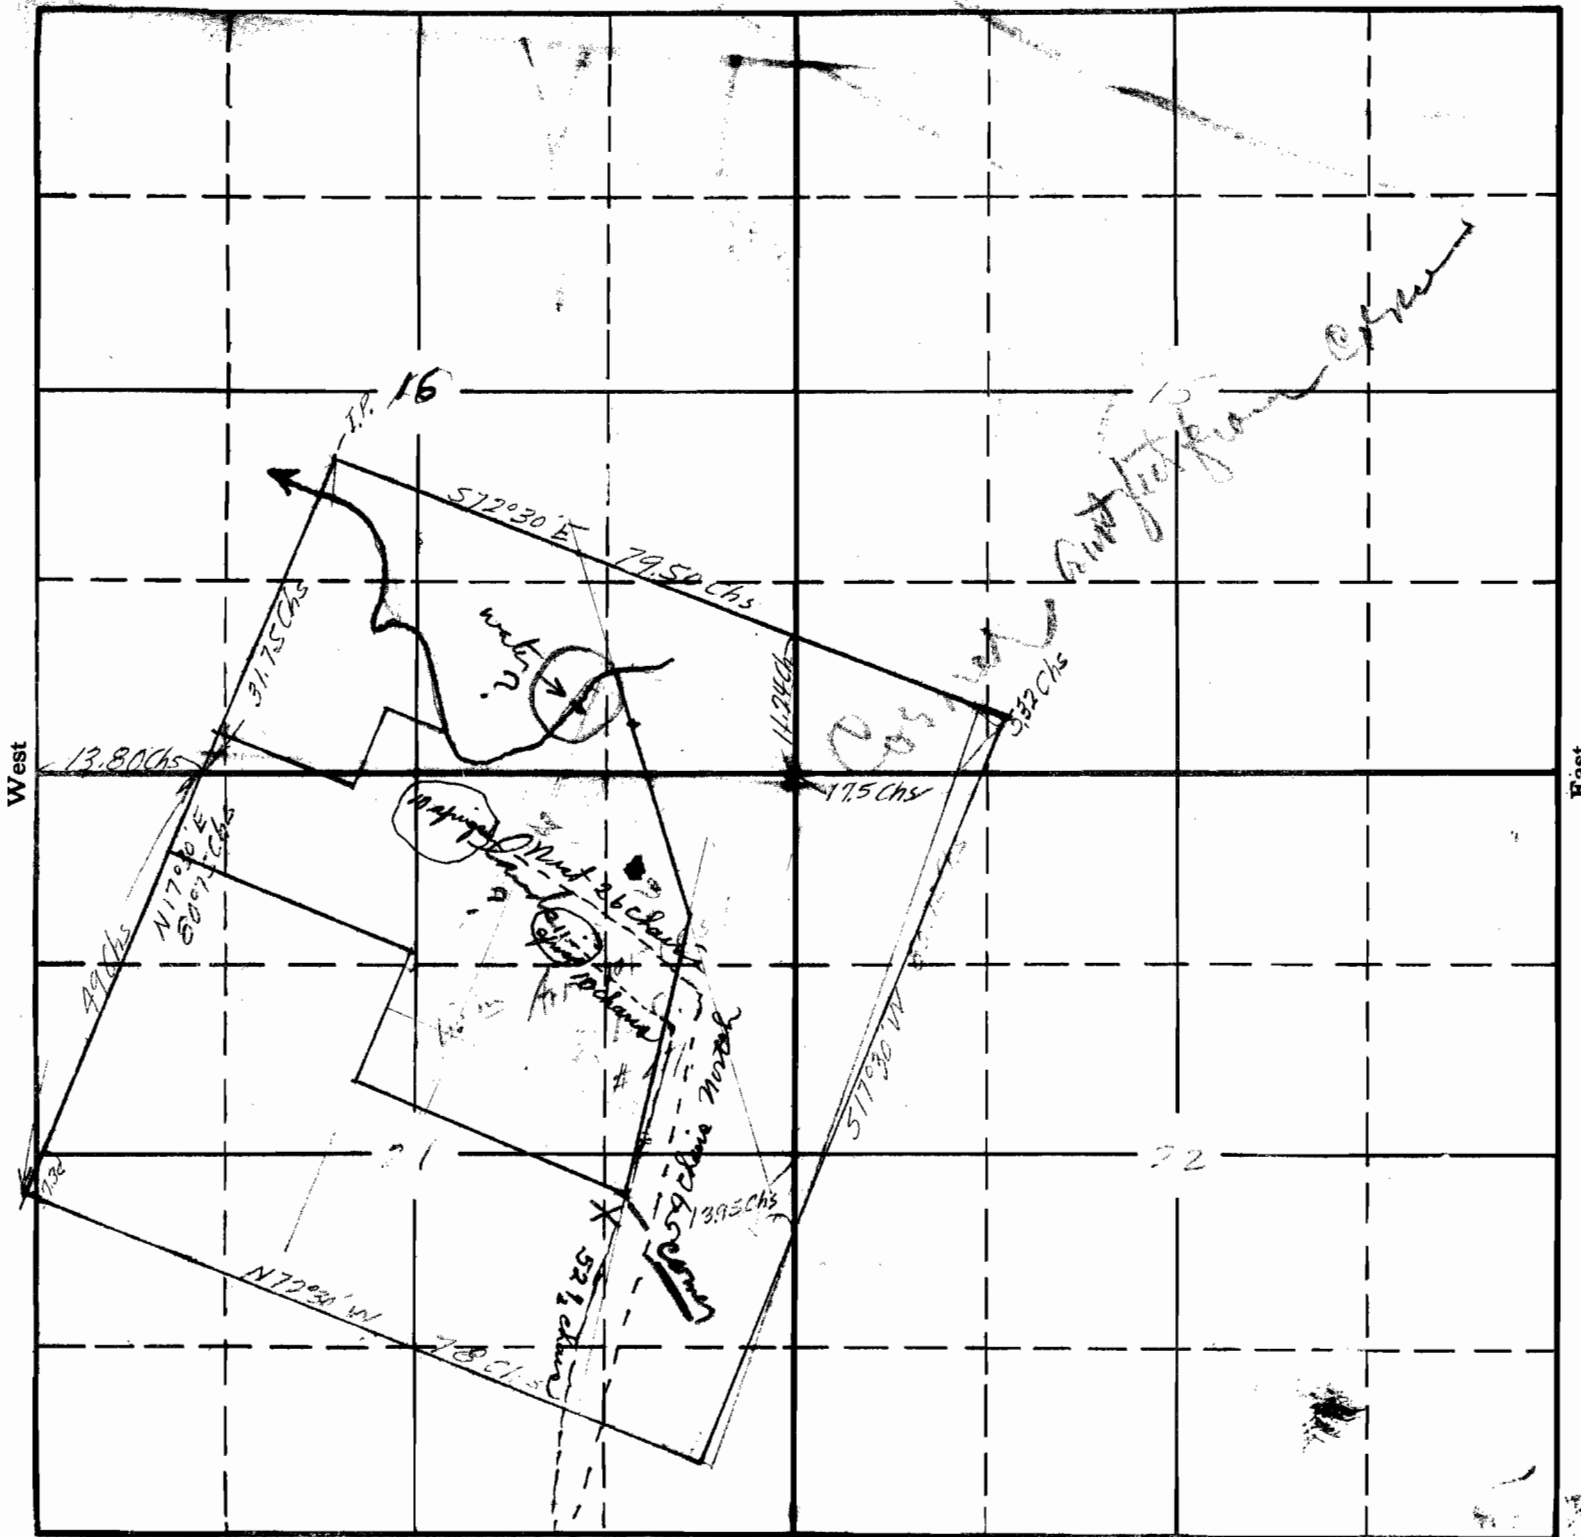

West

East

South

x 60 chains east

APPLICATION No.

PERMIT No.

66' = 1 chain