

SECTION


18.

TOWNSHIP 17N, RANGE 40W, W. M.

North

West

East

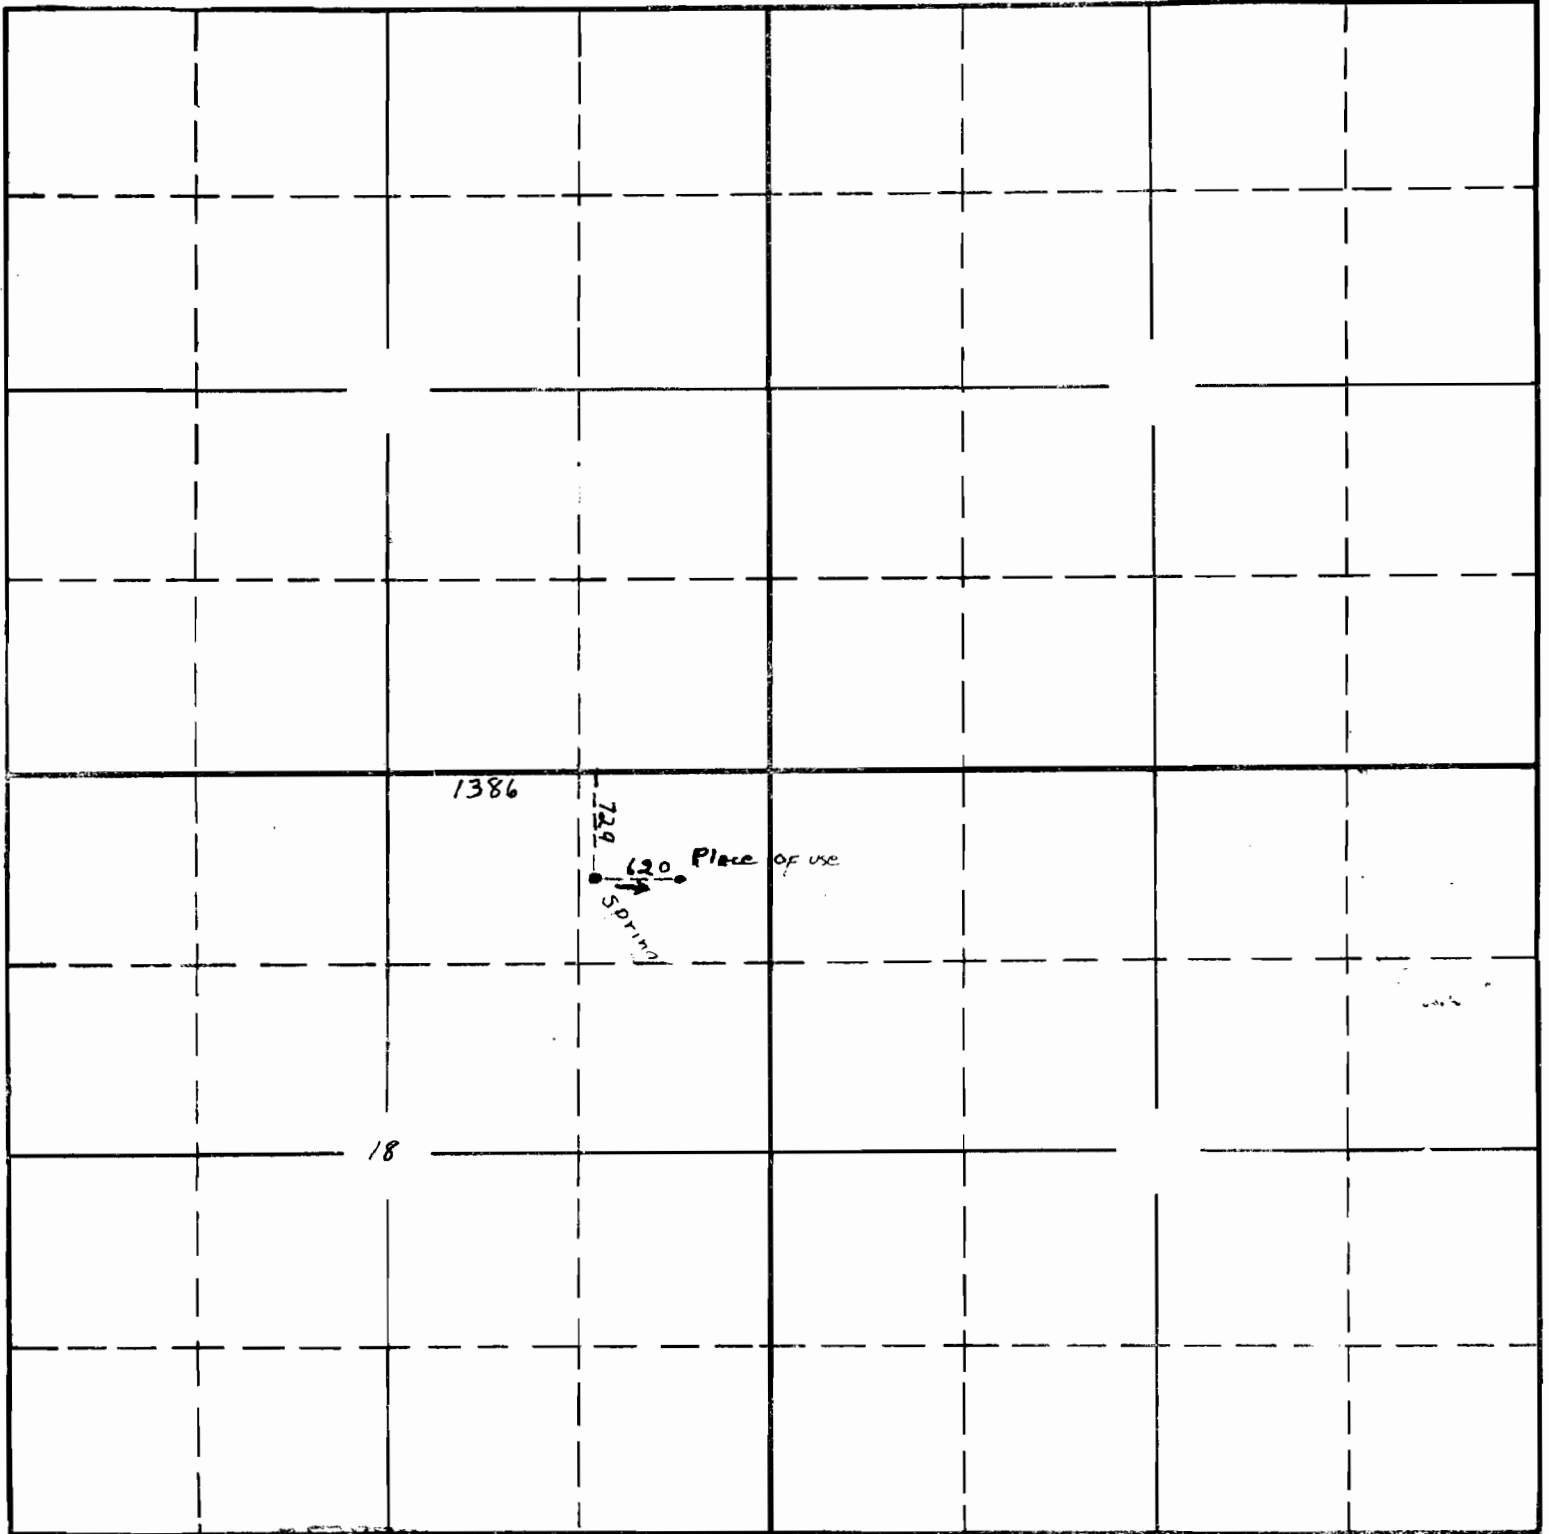

South

RECEIVED
 JUN 8 1934
 STATE ENGINEER
 JALEM CAMPBELL

APPLICATION No. 15384
 PERMIT No. 11294