


SECTION

TOWNSHIP 33 S., RANGE 7W., W. M.

North

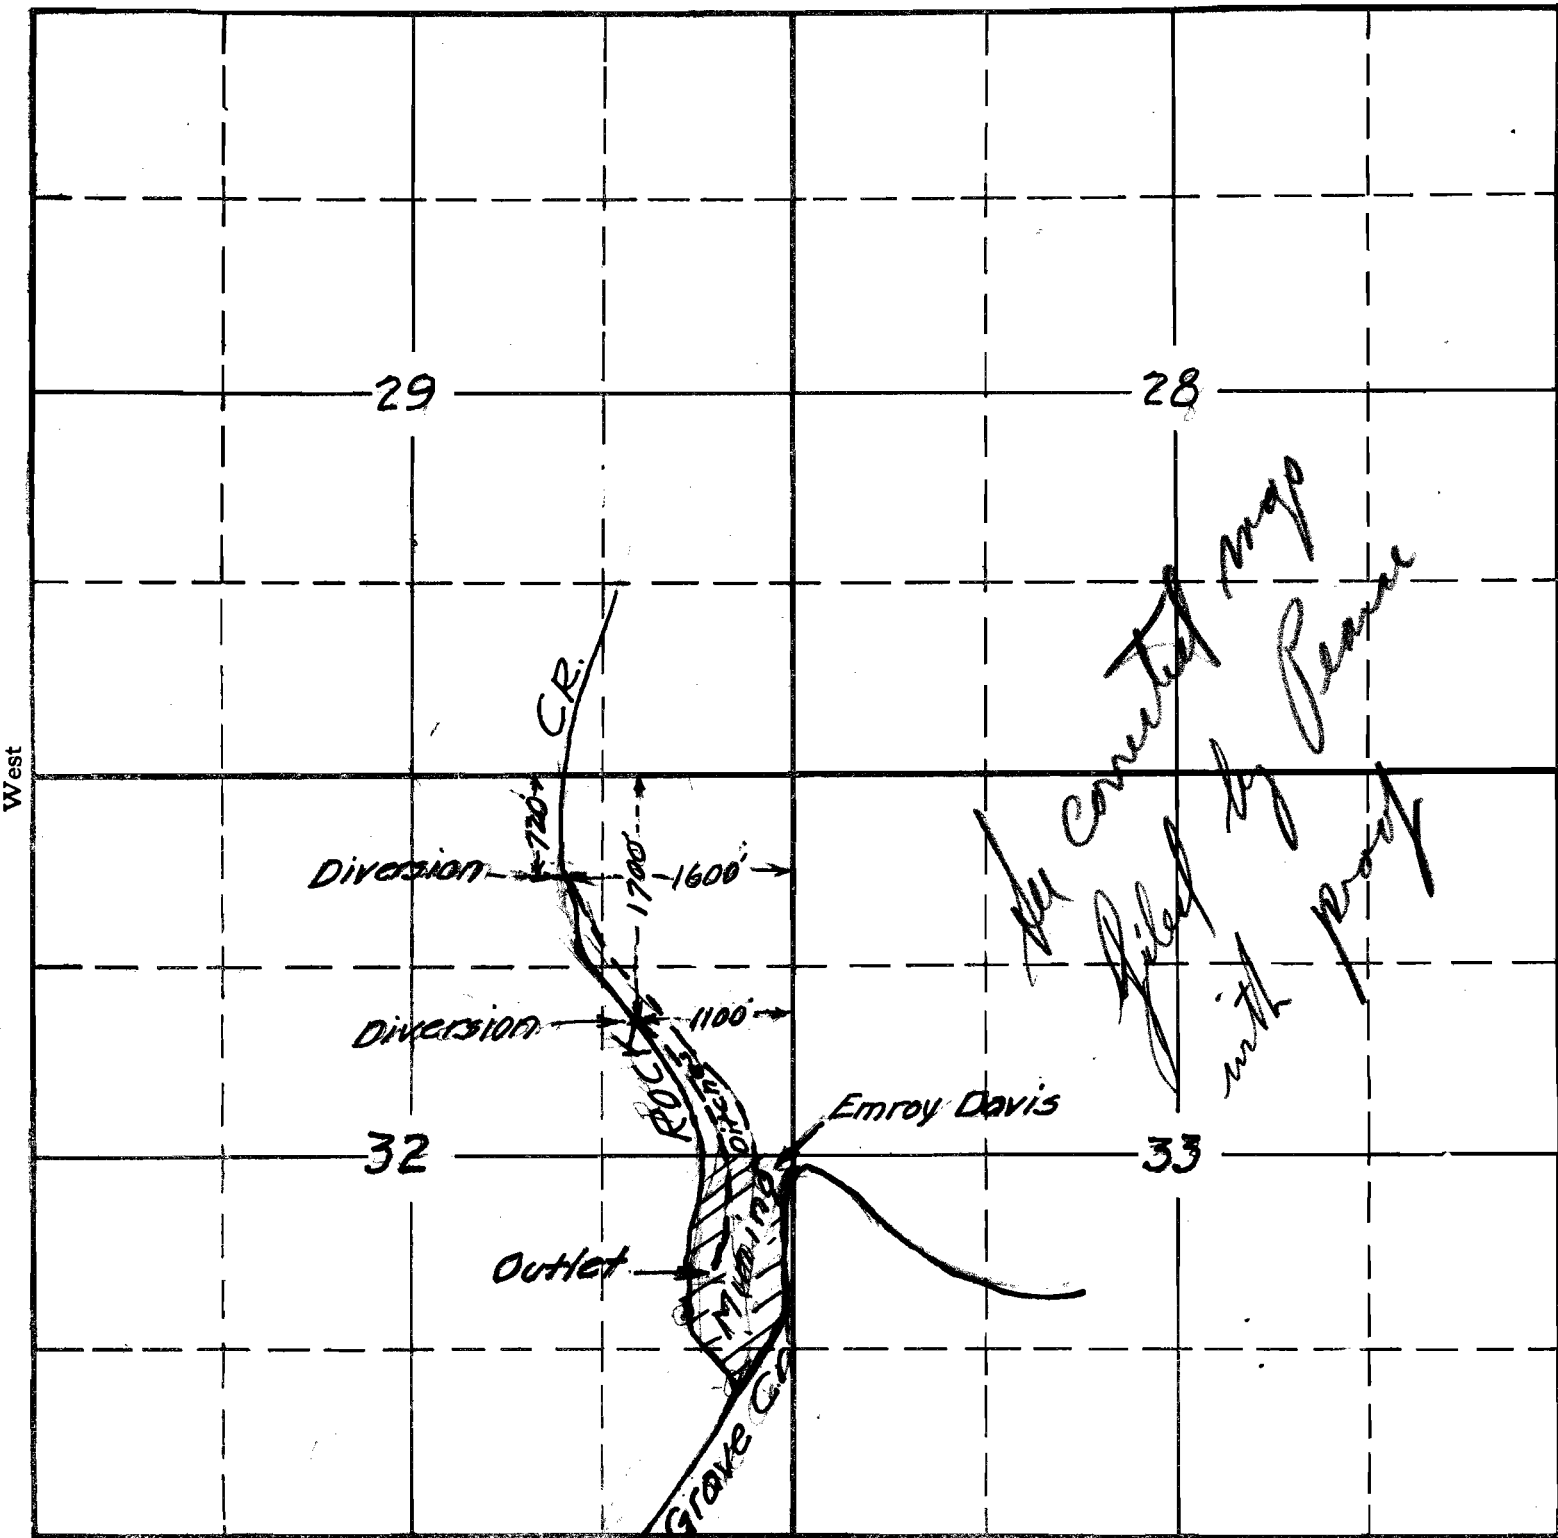

South

RECEIVED  
JUL 10 1934

APPLICATION No. 15422

PERMIT No. 11318

STATE ENGINEER  
SALEM, OREGON