


SECTION

TOWNSHIP 9S, RANGE 3W, W. M.

North

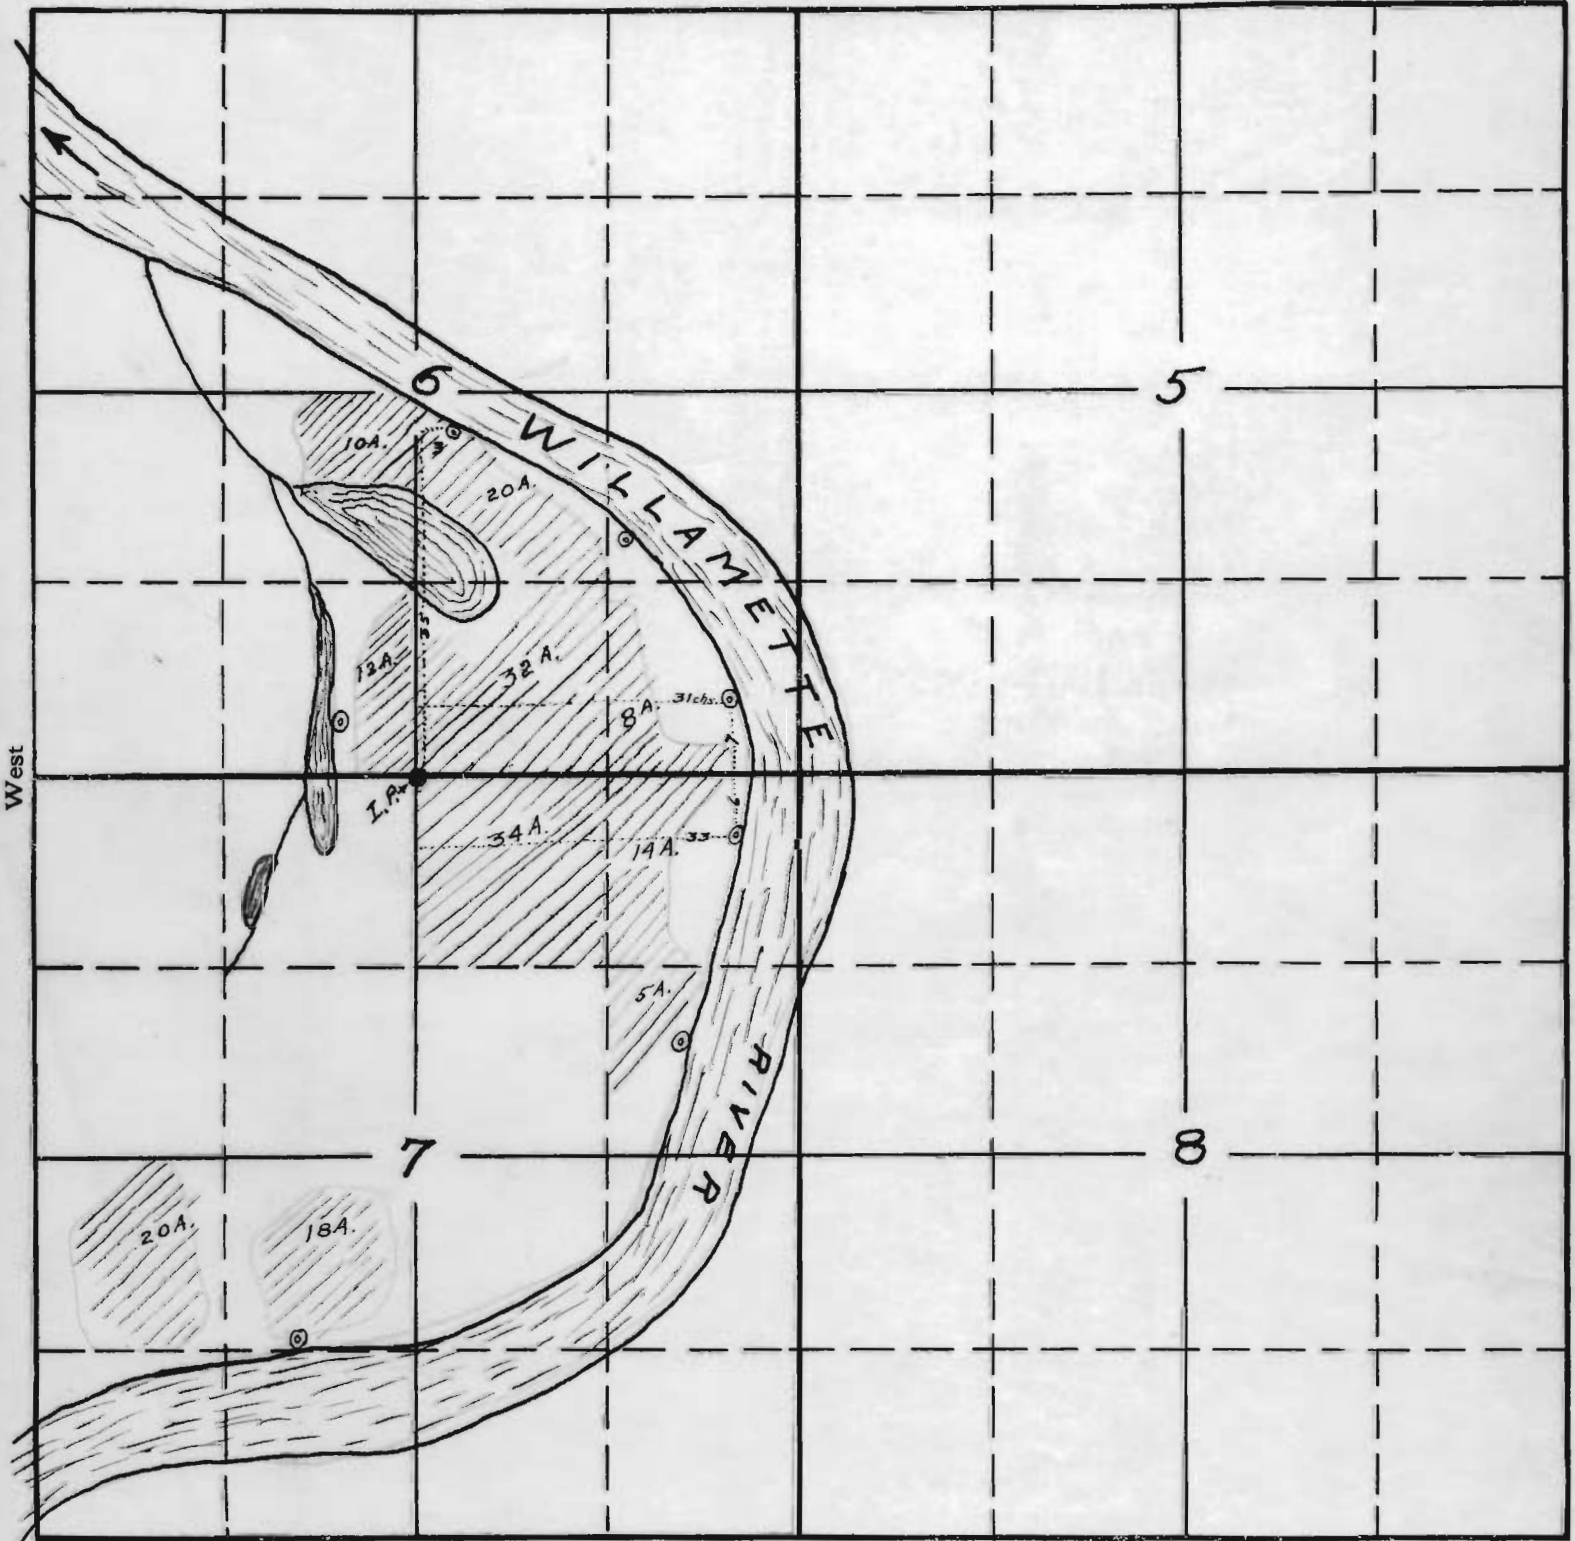

⊙ Pump locations

South

APPLICATION No. 15449

PERMIT No. 11332