

June 1, 1934
~~April 1, 1934~~

Revised-Sept. 10, 34
T.W.S.

APPLICATION No. 15380
PERMIT No. 11341


RECEIVED
JUN 5 1934

STATE ENGINEER
D. A. F. M. C. F. J. L. N.

SECTION _____

TOWNSHIP _____, RANGE _____, W. M.

North

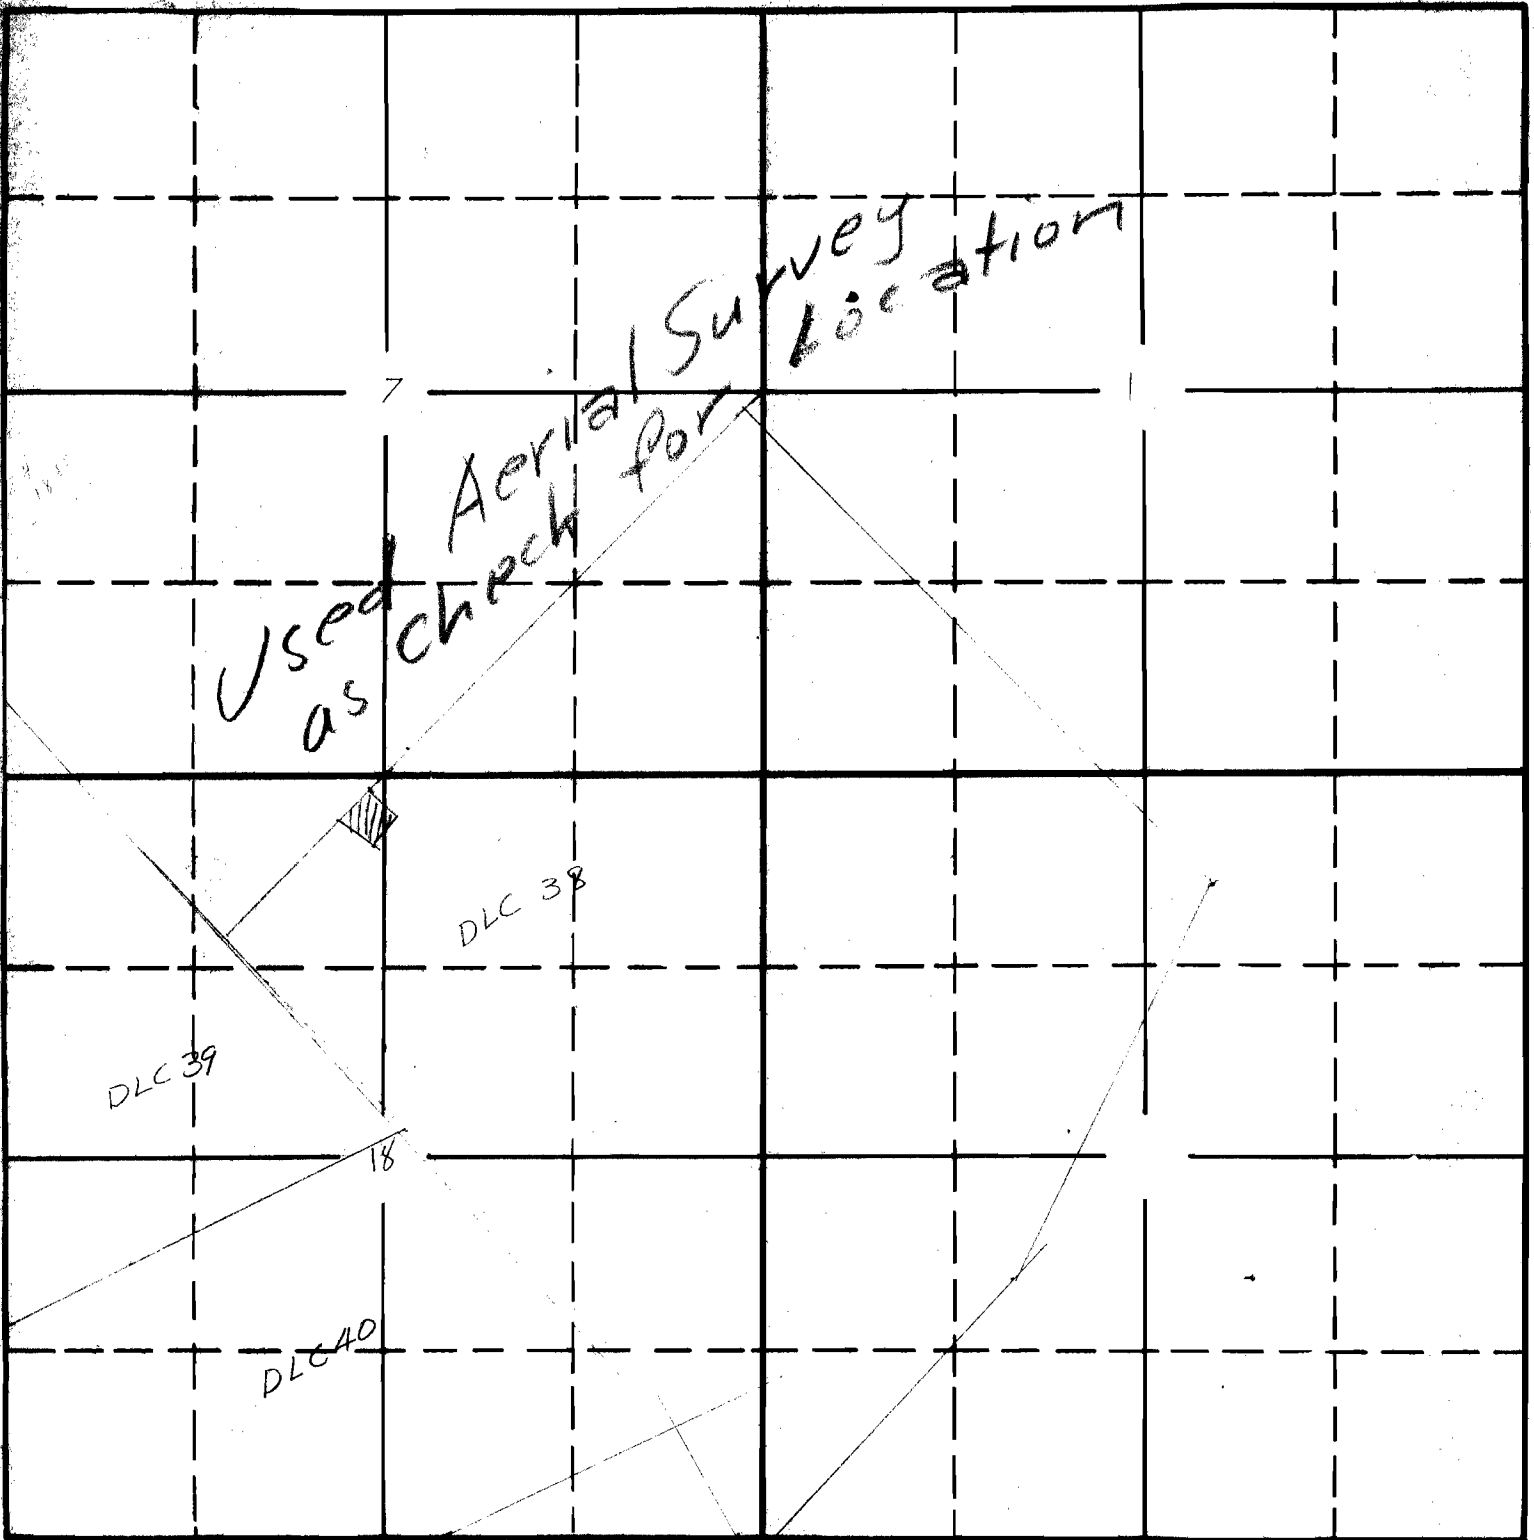

East

South

APPLICATION No.
PERMIT No.