


SECTION

TOWNSHIP 37 S., RANGE 7 W., W. M.

North

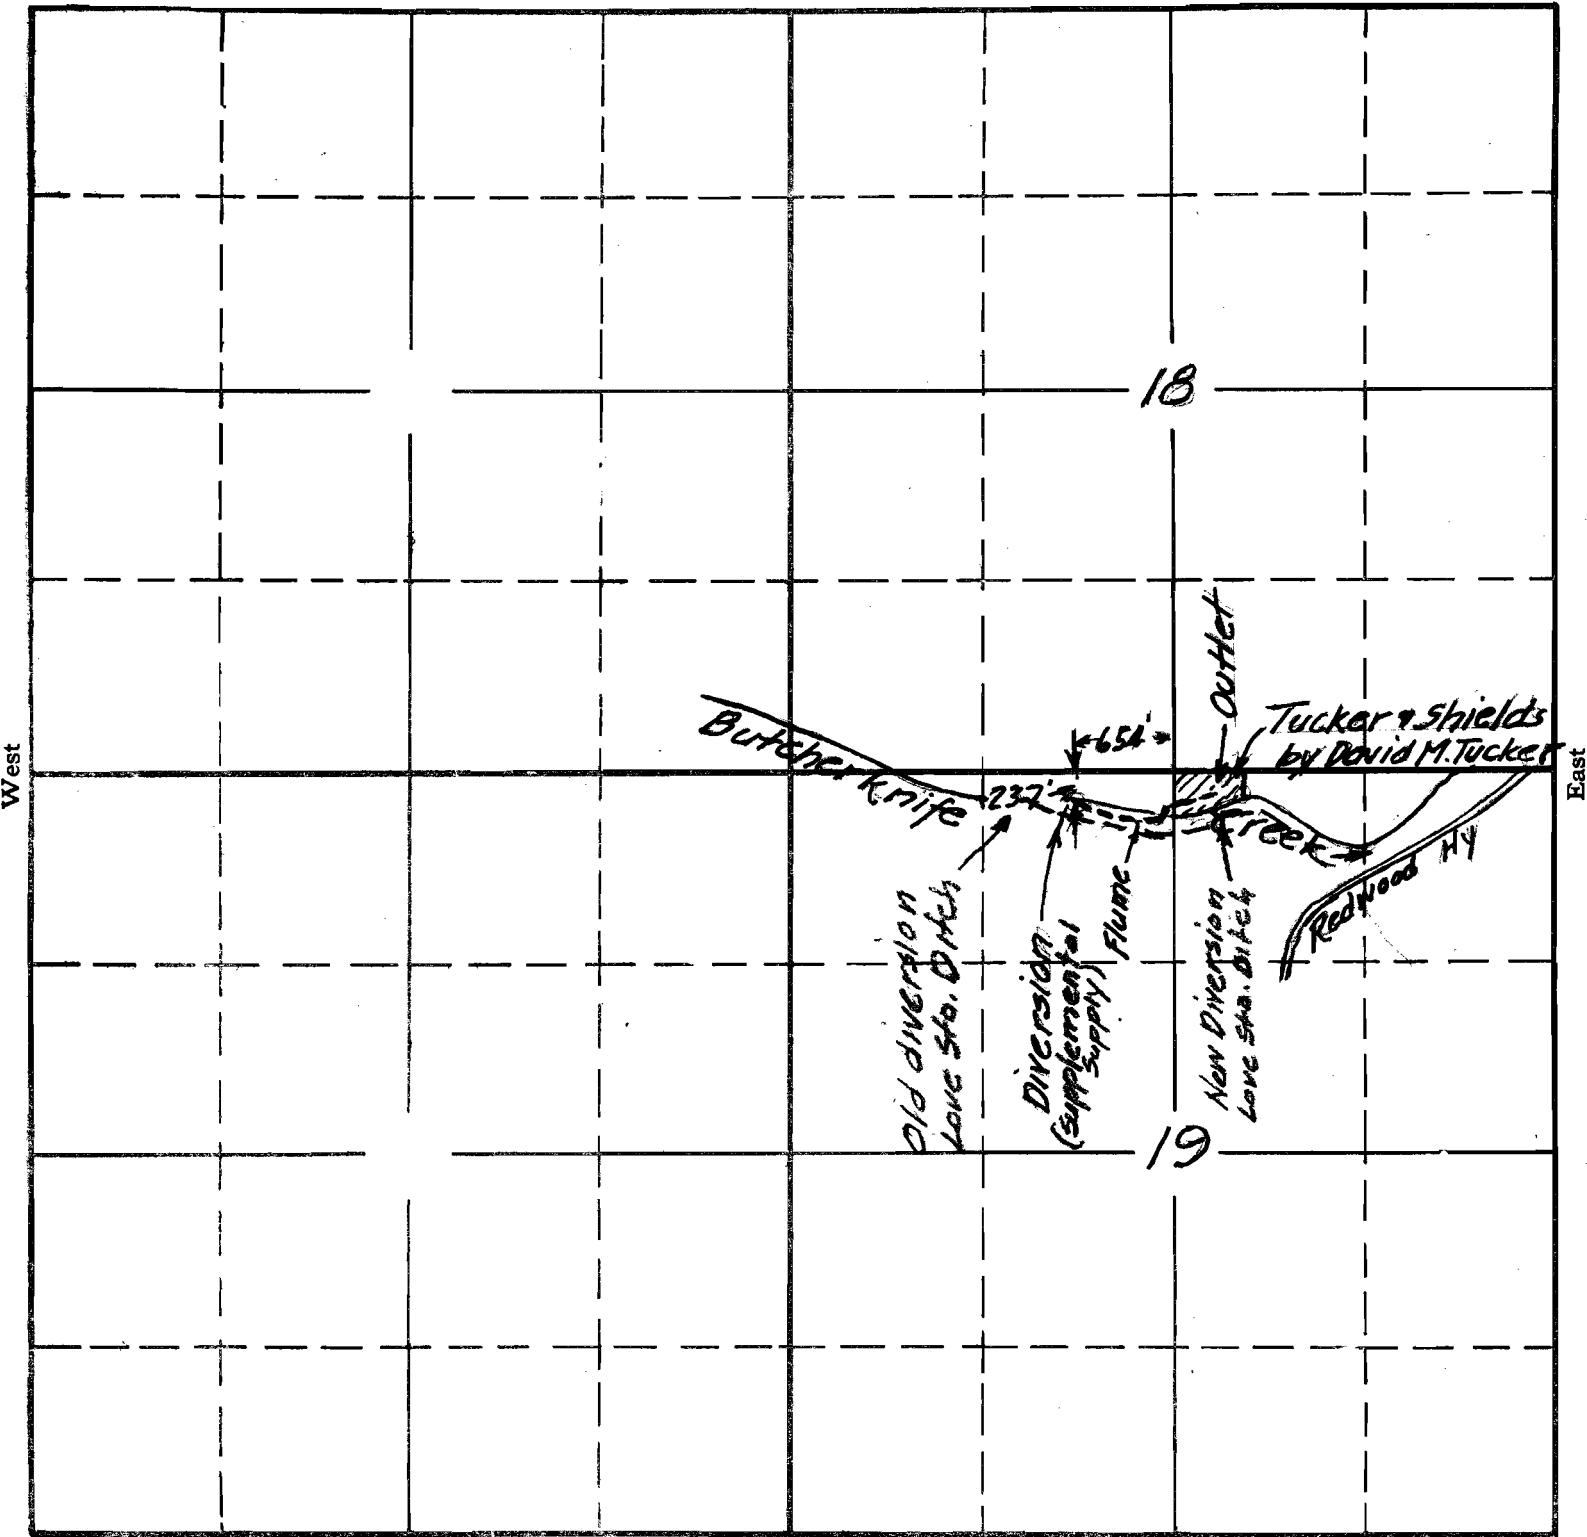

West

East

South

RECEIVED
AUG 9 1934

STATE ENGINEER
SALEM, OREGON

APPLICATION No. 15466
PERMIT No. 11359