


SECTION

TOWNSHIP 36 S, RANGE 9 W, W. M.

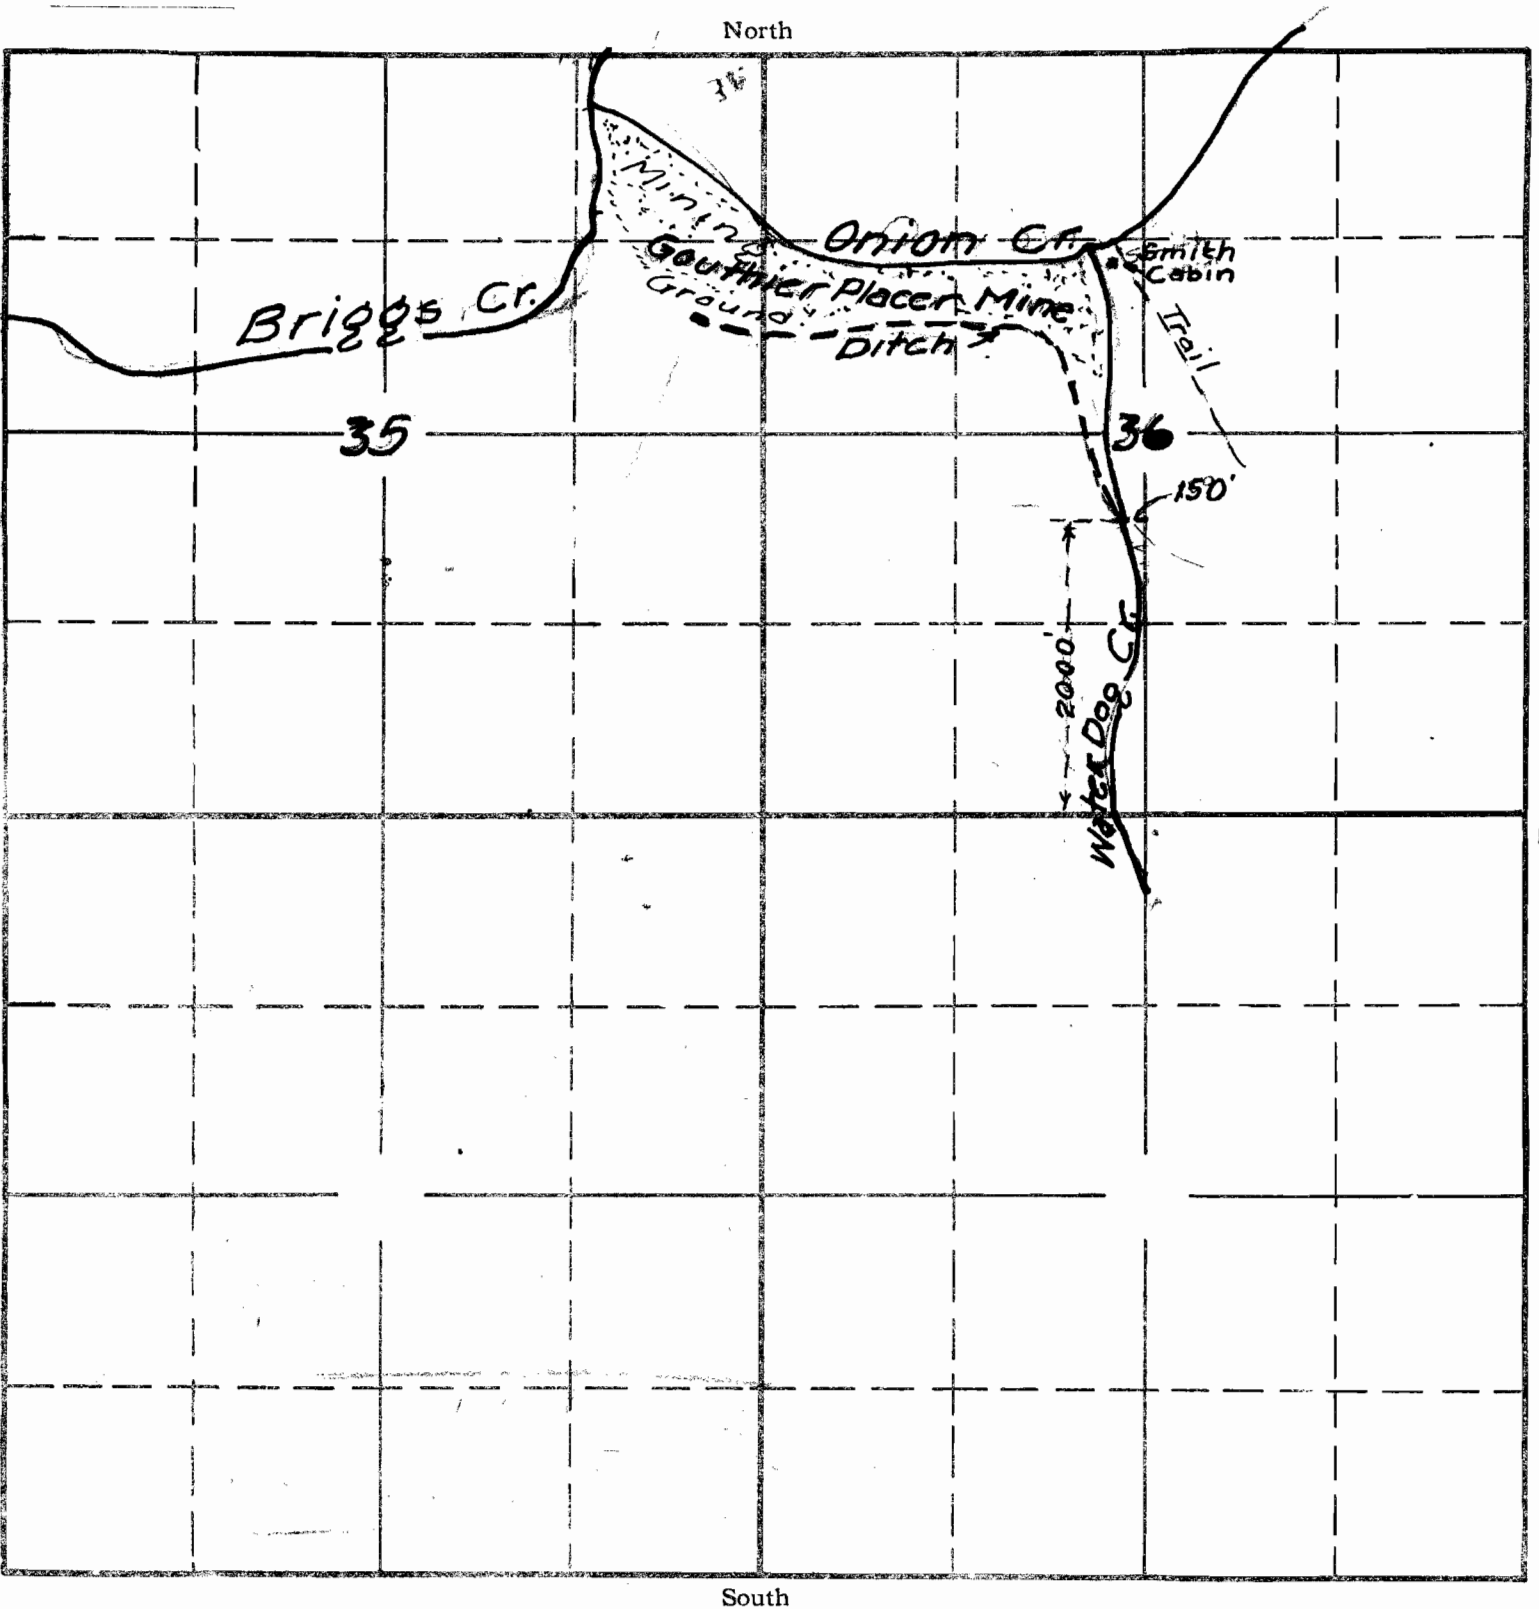

RECEIVED

APPLICATION No. 15480
 PERMIT No. 11367