


SECTION

TOWNSHIP 36 S, RANGE 6 W, W. M.

North

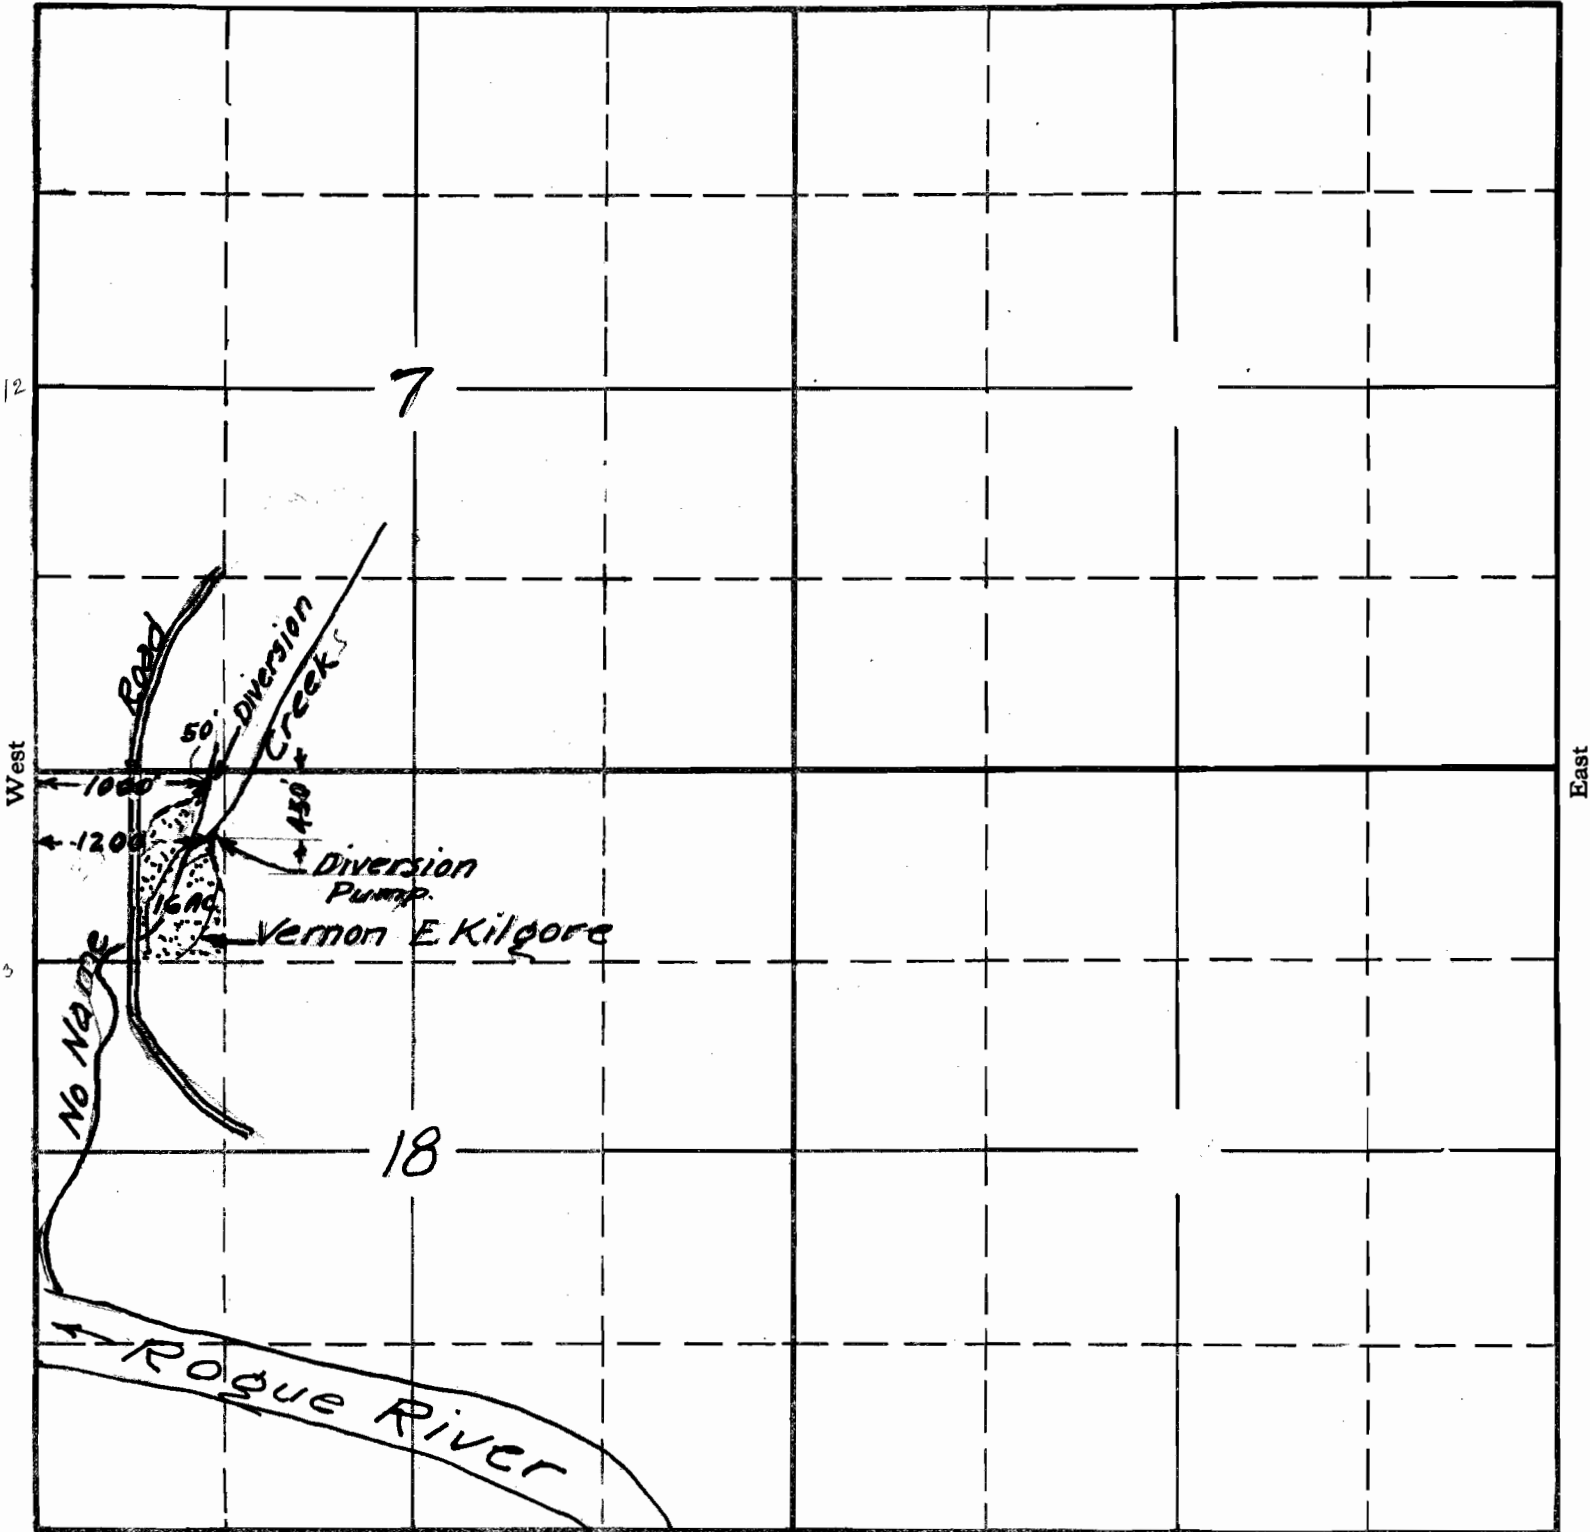

South

RECEIVED
AUG 16 1934

STATE ENGINEER
SALEM, OREGON

APPLICATION No. 15481
PERMIT No. 11368