


SECTION

16

TOWNSHIP 345, RANGE 1W, W. M.

North

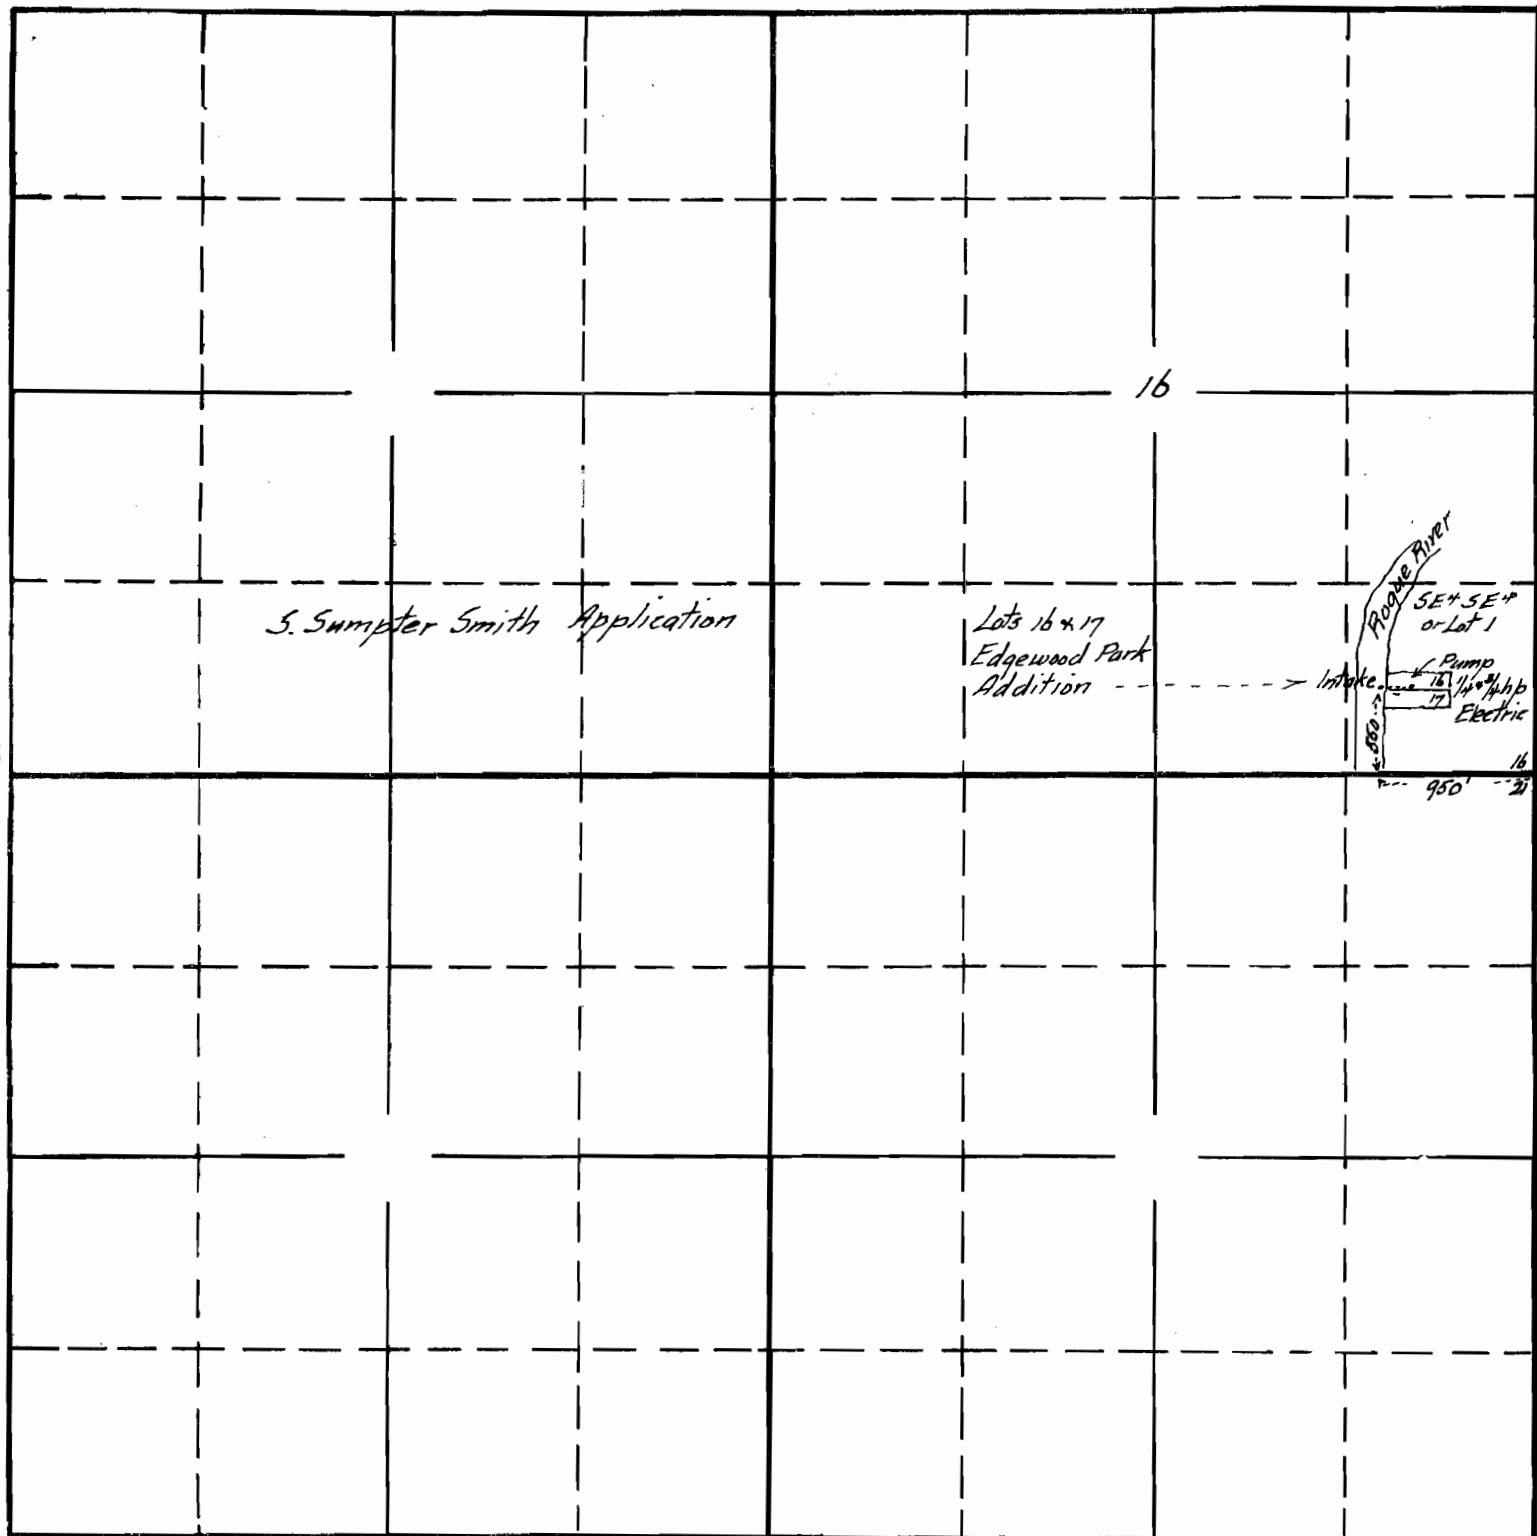

South

RECORDED
 AUG 8 1934

APPLICATION No. 15503

PERMIT No. 11385

OFFICE OF THE
