


SECTION

TOWNSHIP 145, RANGE 12W, W. M.

North

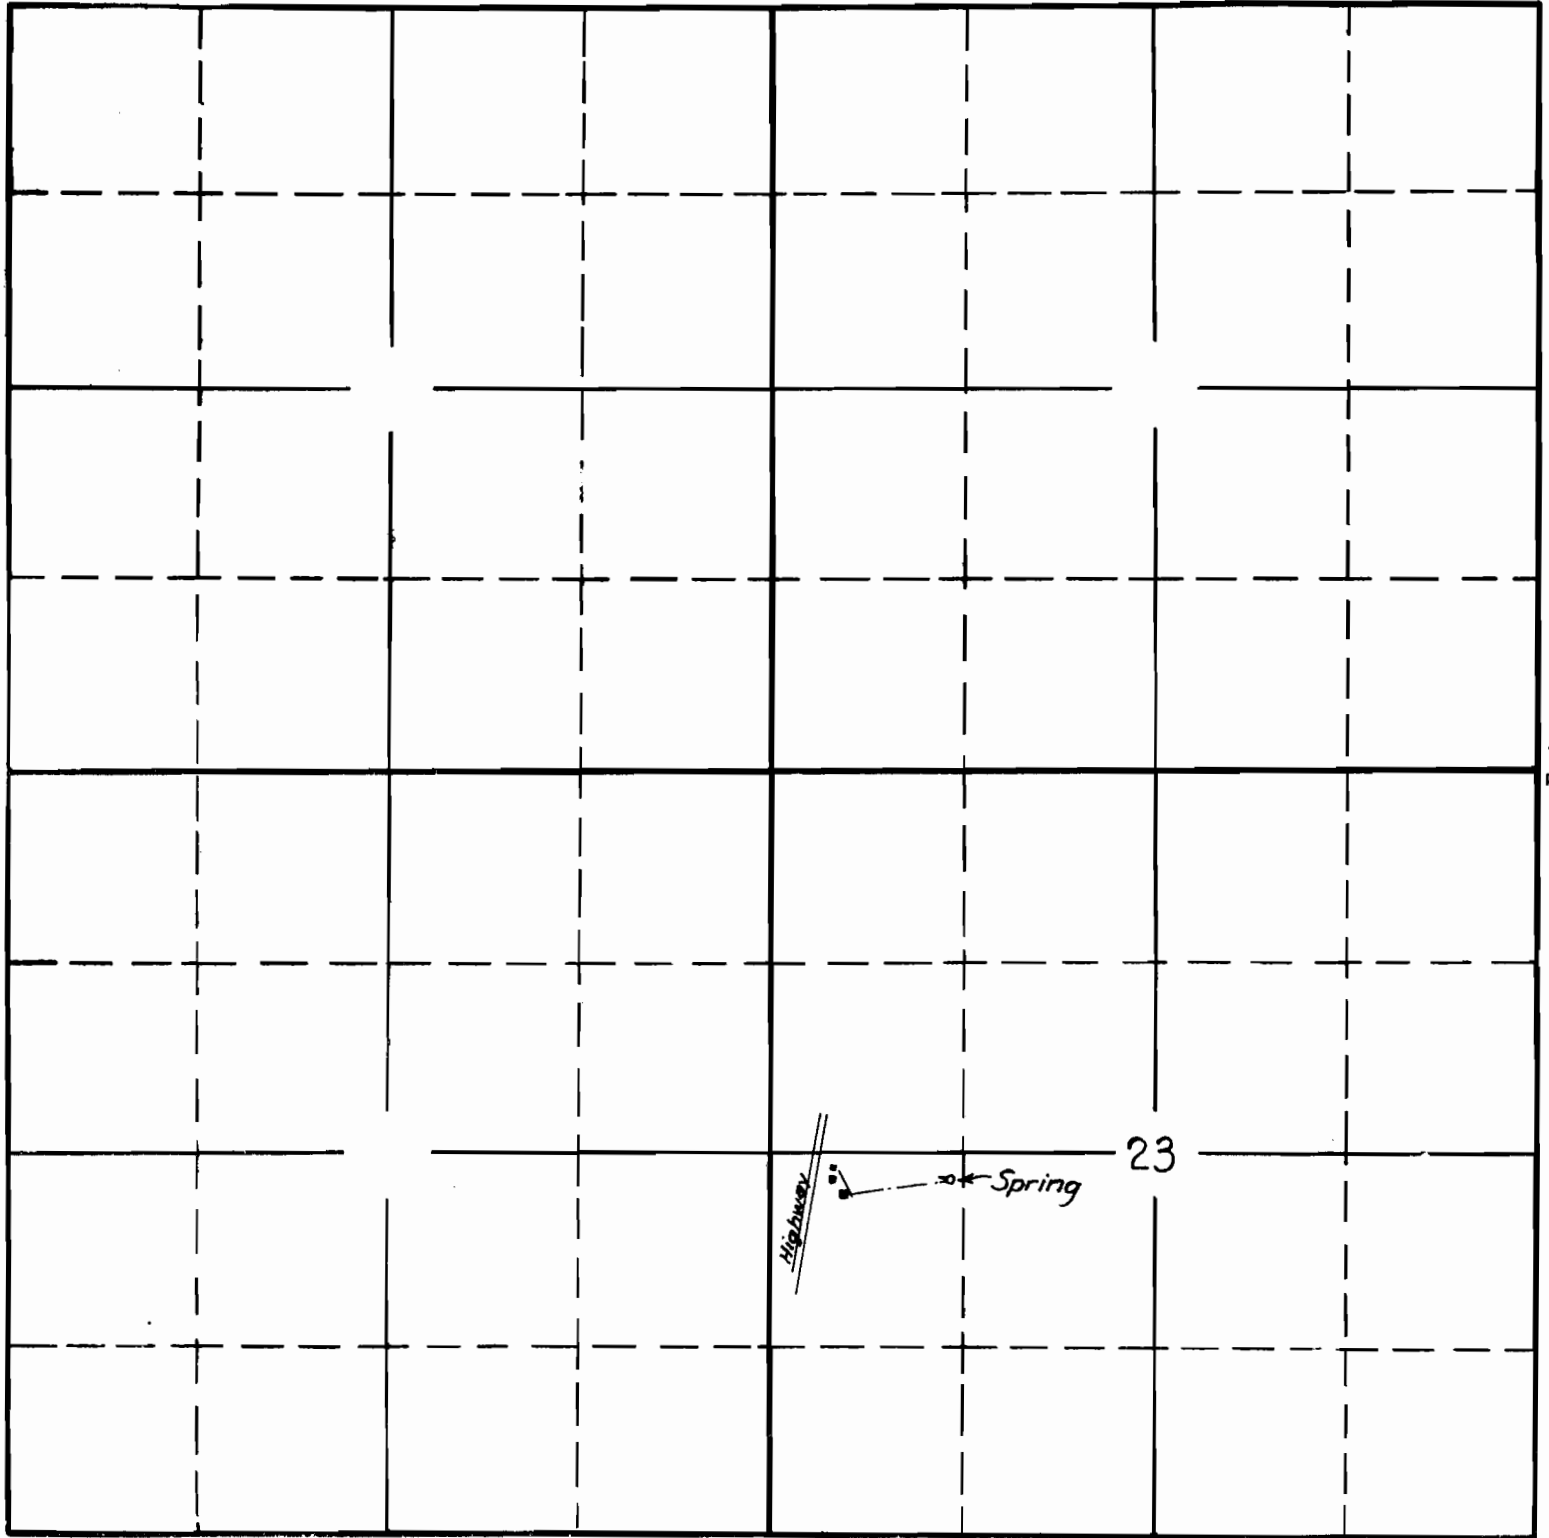

West

East

South

APPLICATION No. 15520


PERMIT No. 11388

filed with proof

SECTION

23

TOWNSHIP 14 S., RANGE 12 W., W. M.

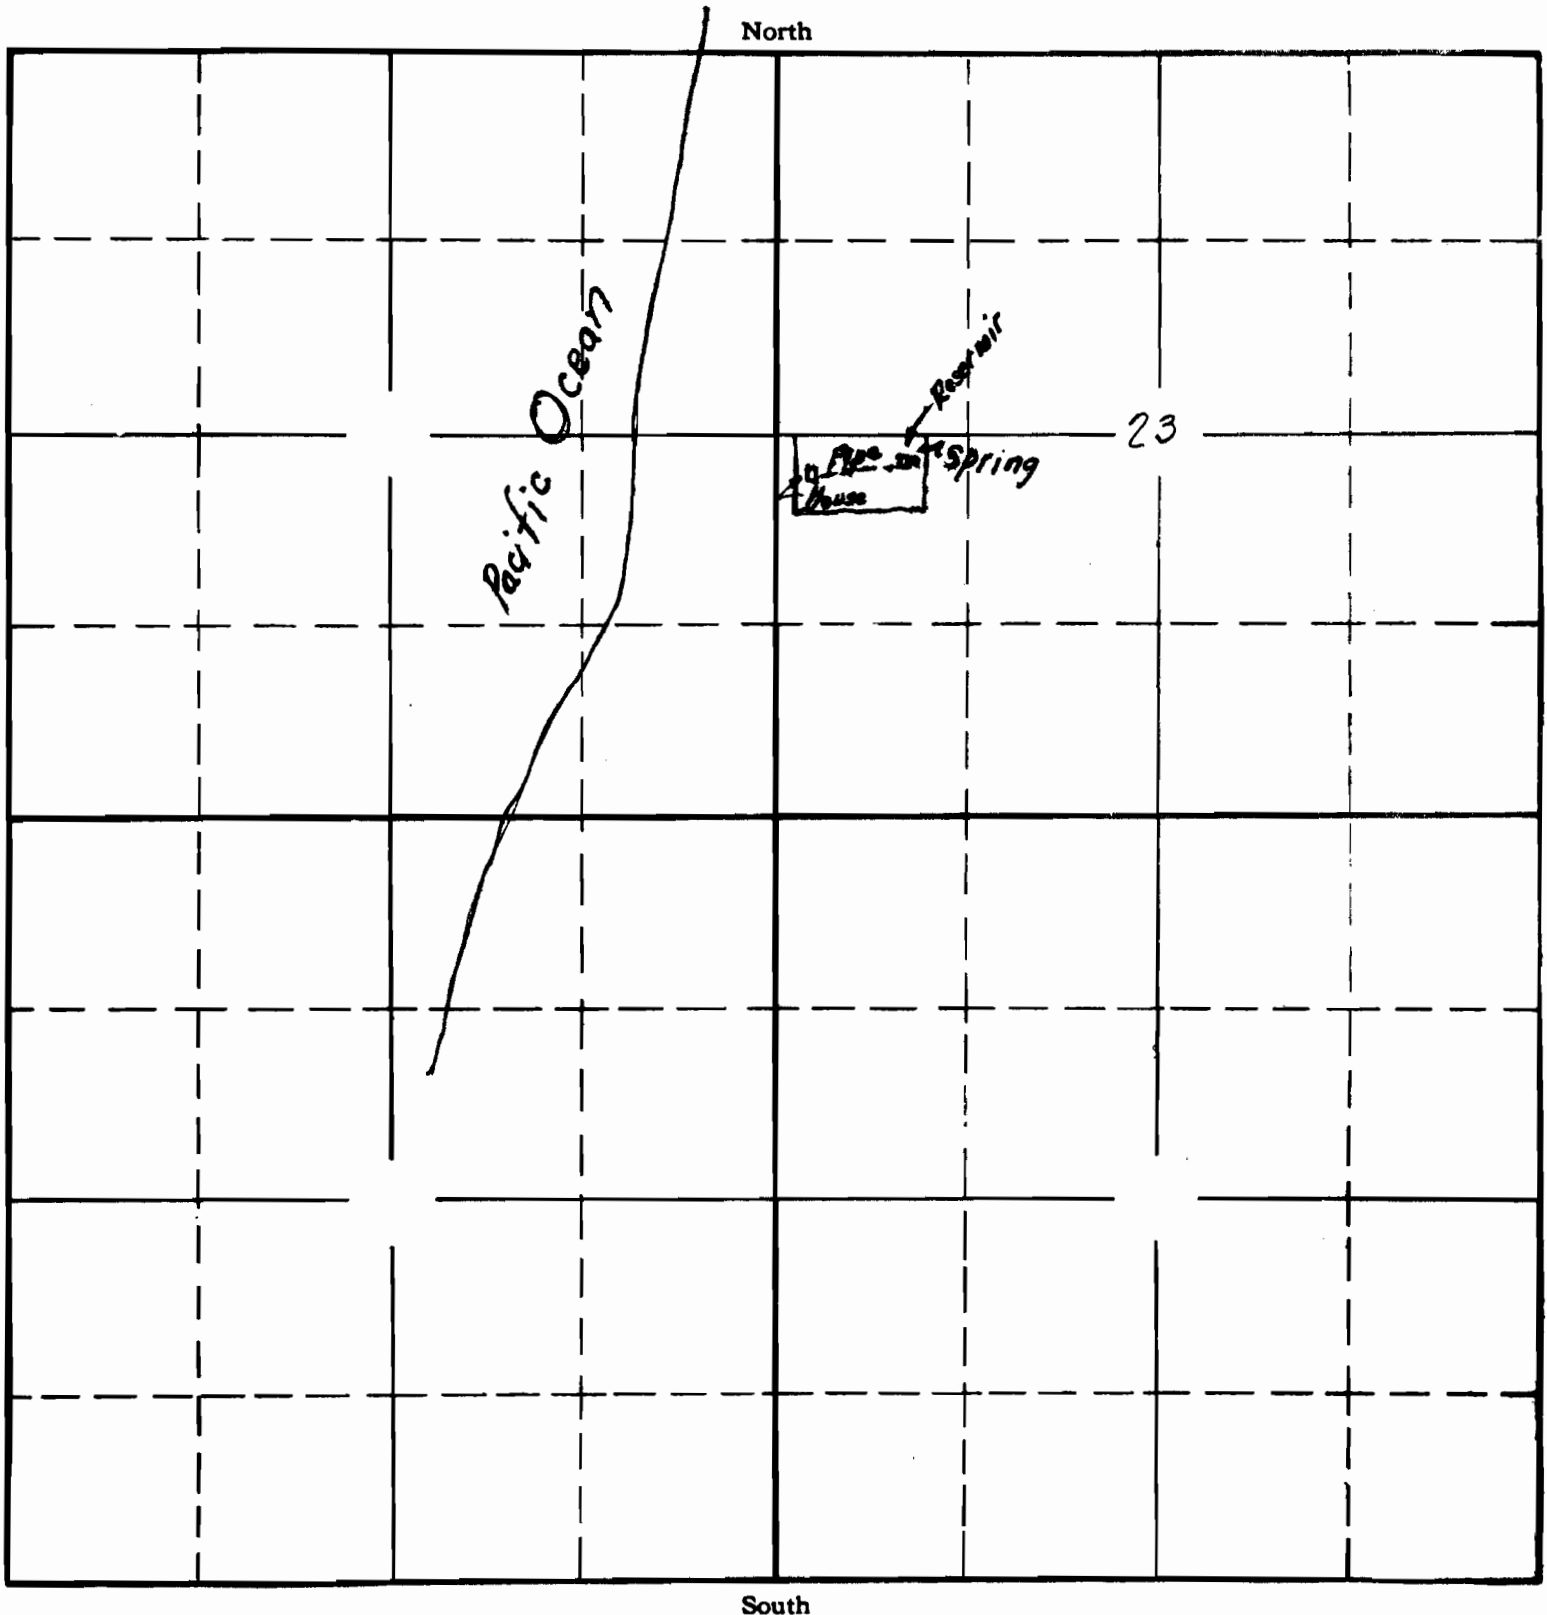

APPLICATION No. 15,520
PERMIT No. 11388