


SECTION

9

TOWNSHIP 33 S, RANGE 10 W, W. M.

*Accepted*

North

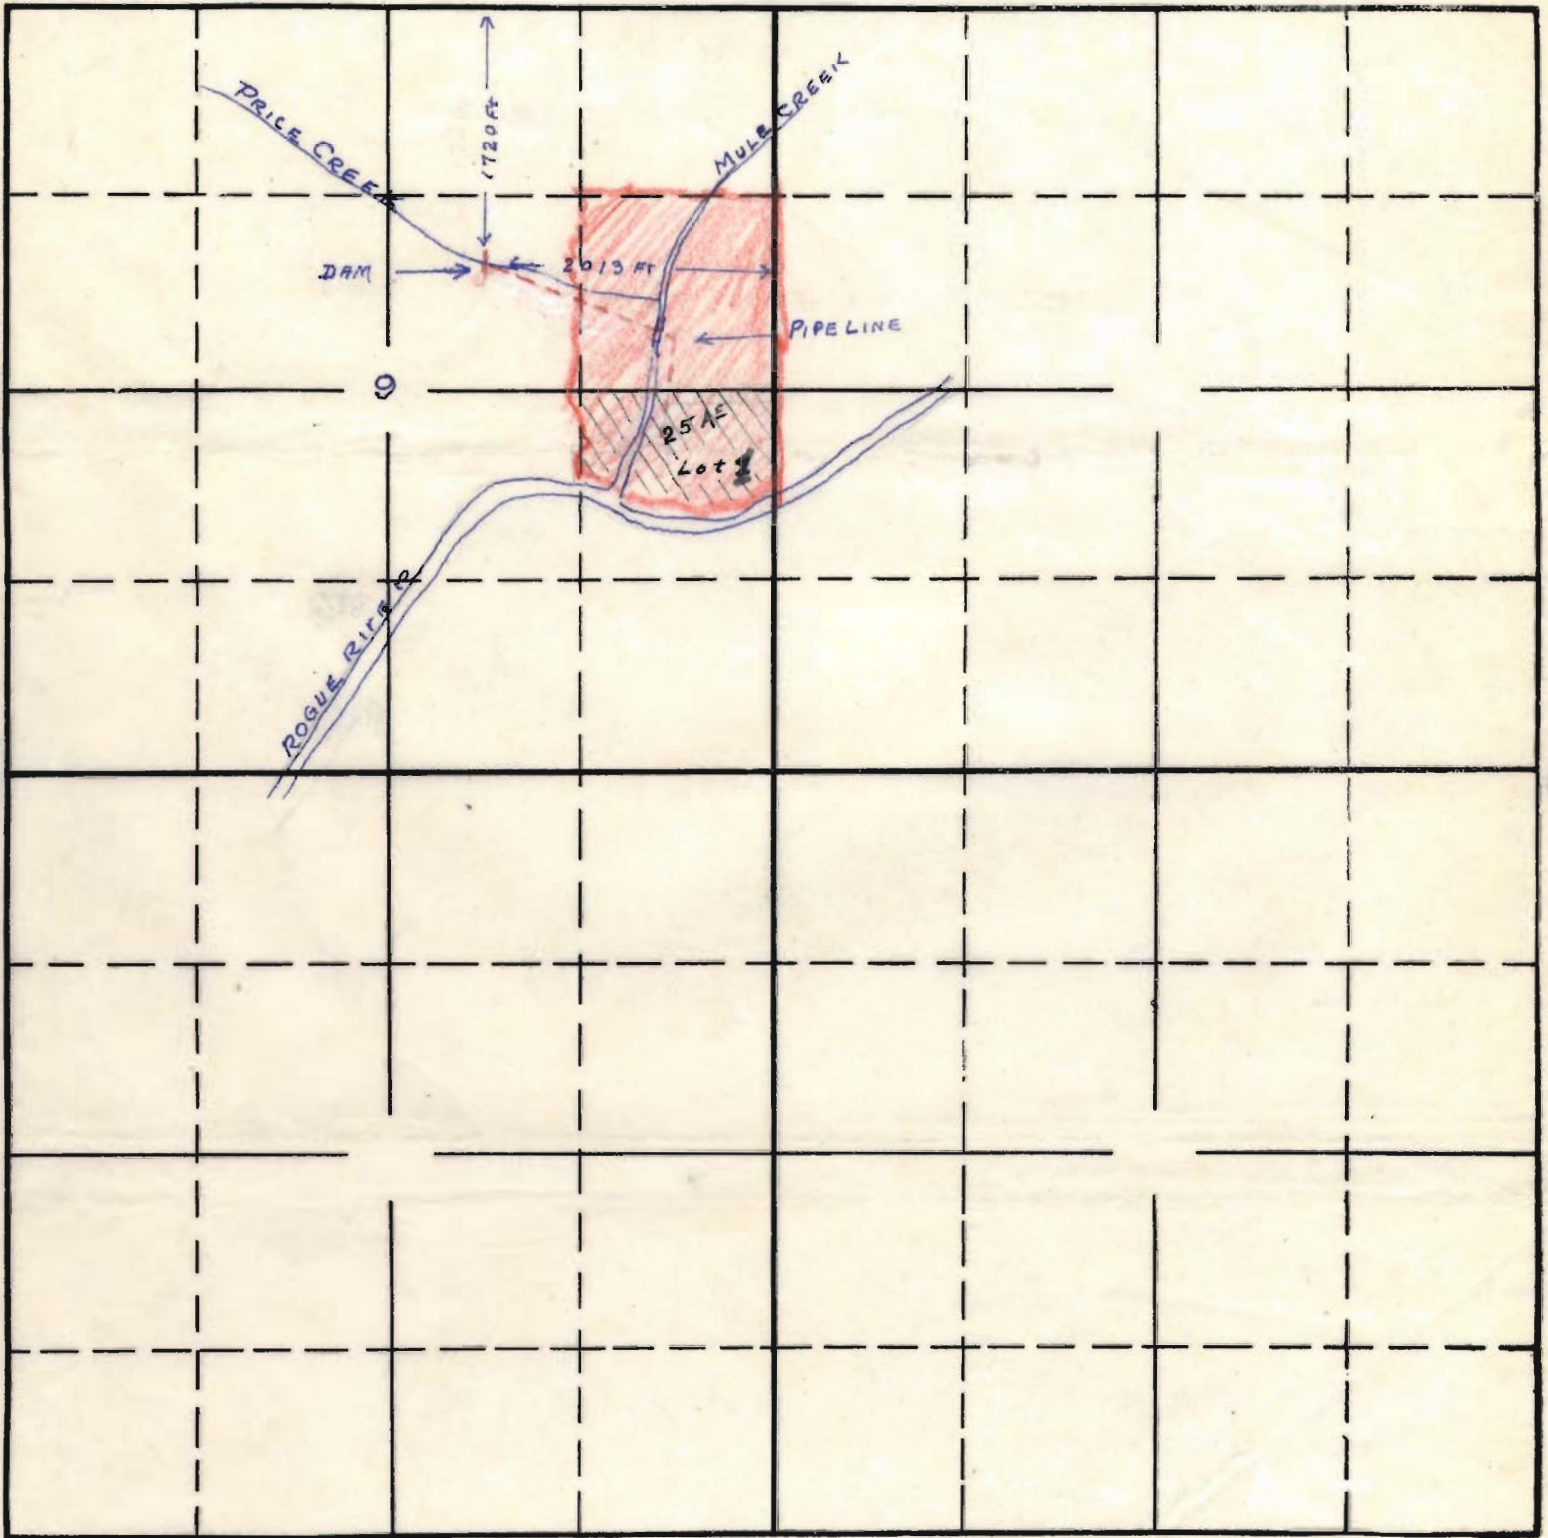

South

APPLICATION No. 15570

PERMIT No. 11439