


SECTION

TOWNSHIP 23S, RANGE 6E, W. M.

North

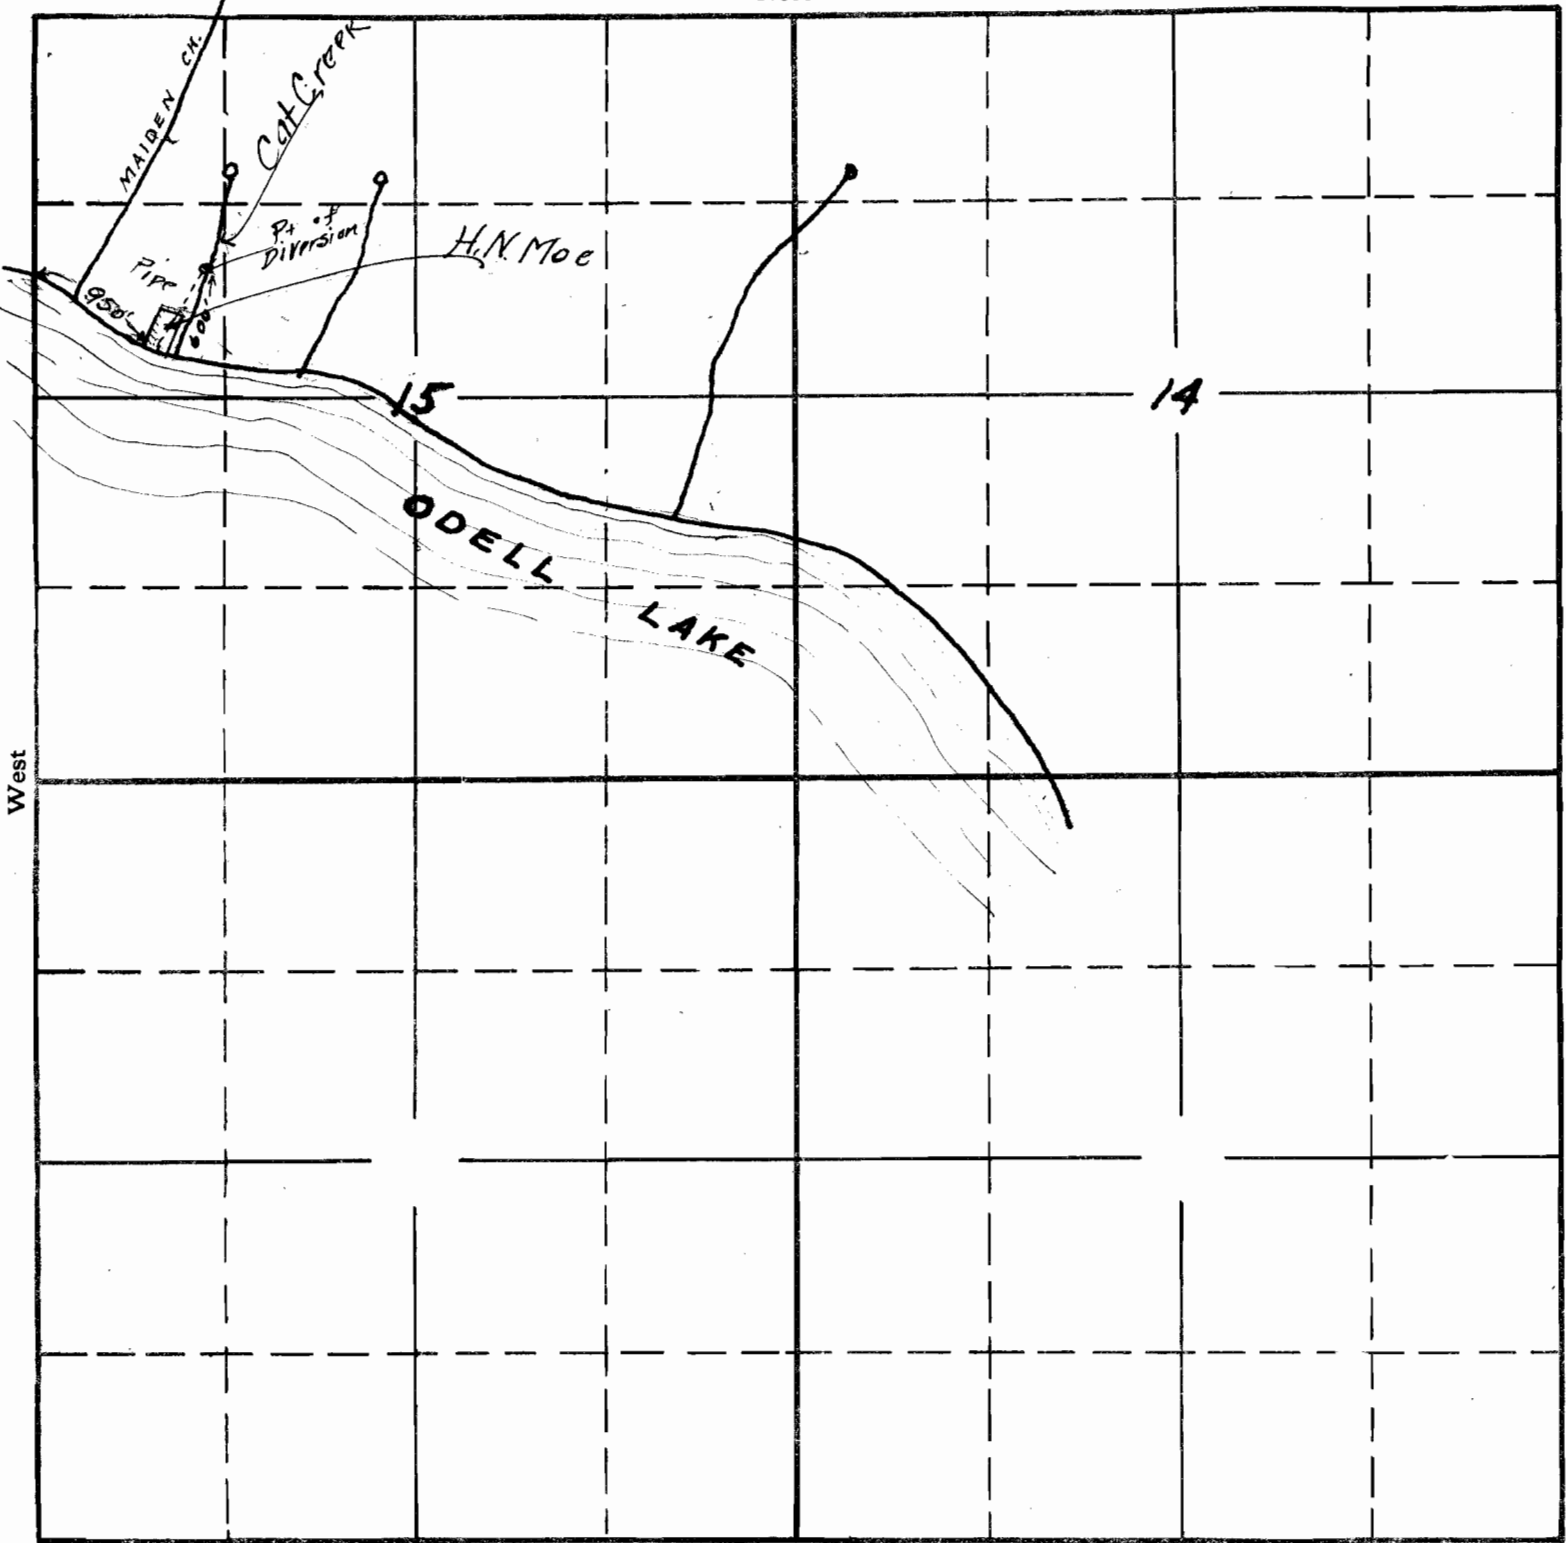

South

RECEIVED
 OCT 16 1934
 STATE ENGINEER
 SALEM, OREGON

APPLICATION No. 15584
 PERMIT No. 11444