


SECTION

\_\_\_\_\_  
\_\_\_\_\_  
\_\_\_\_\_  
\_\_\_\_\_

TOWNSHIP 55., RANGE 41E., W. M.

North

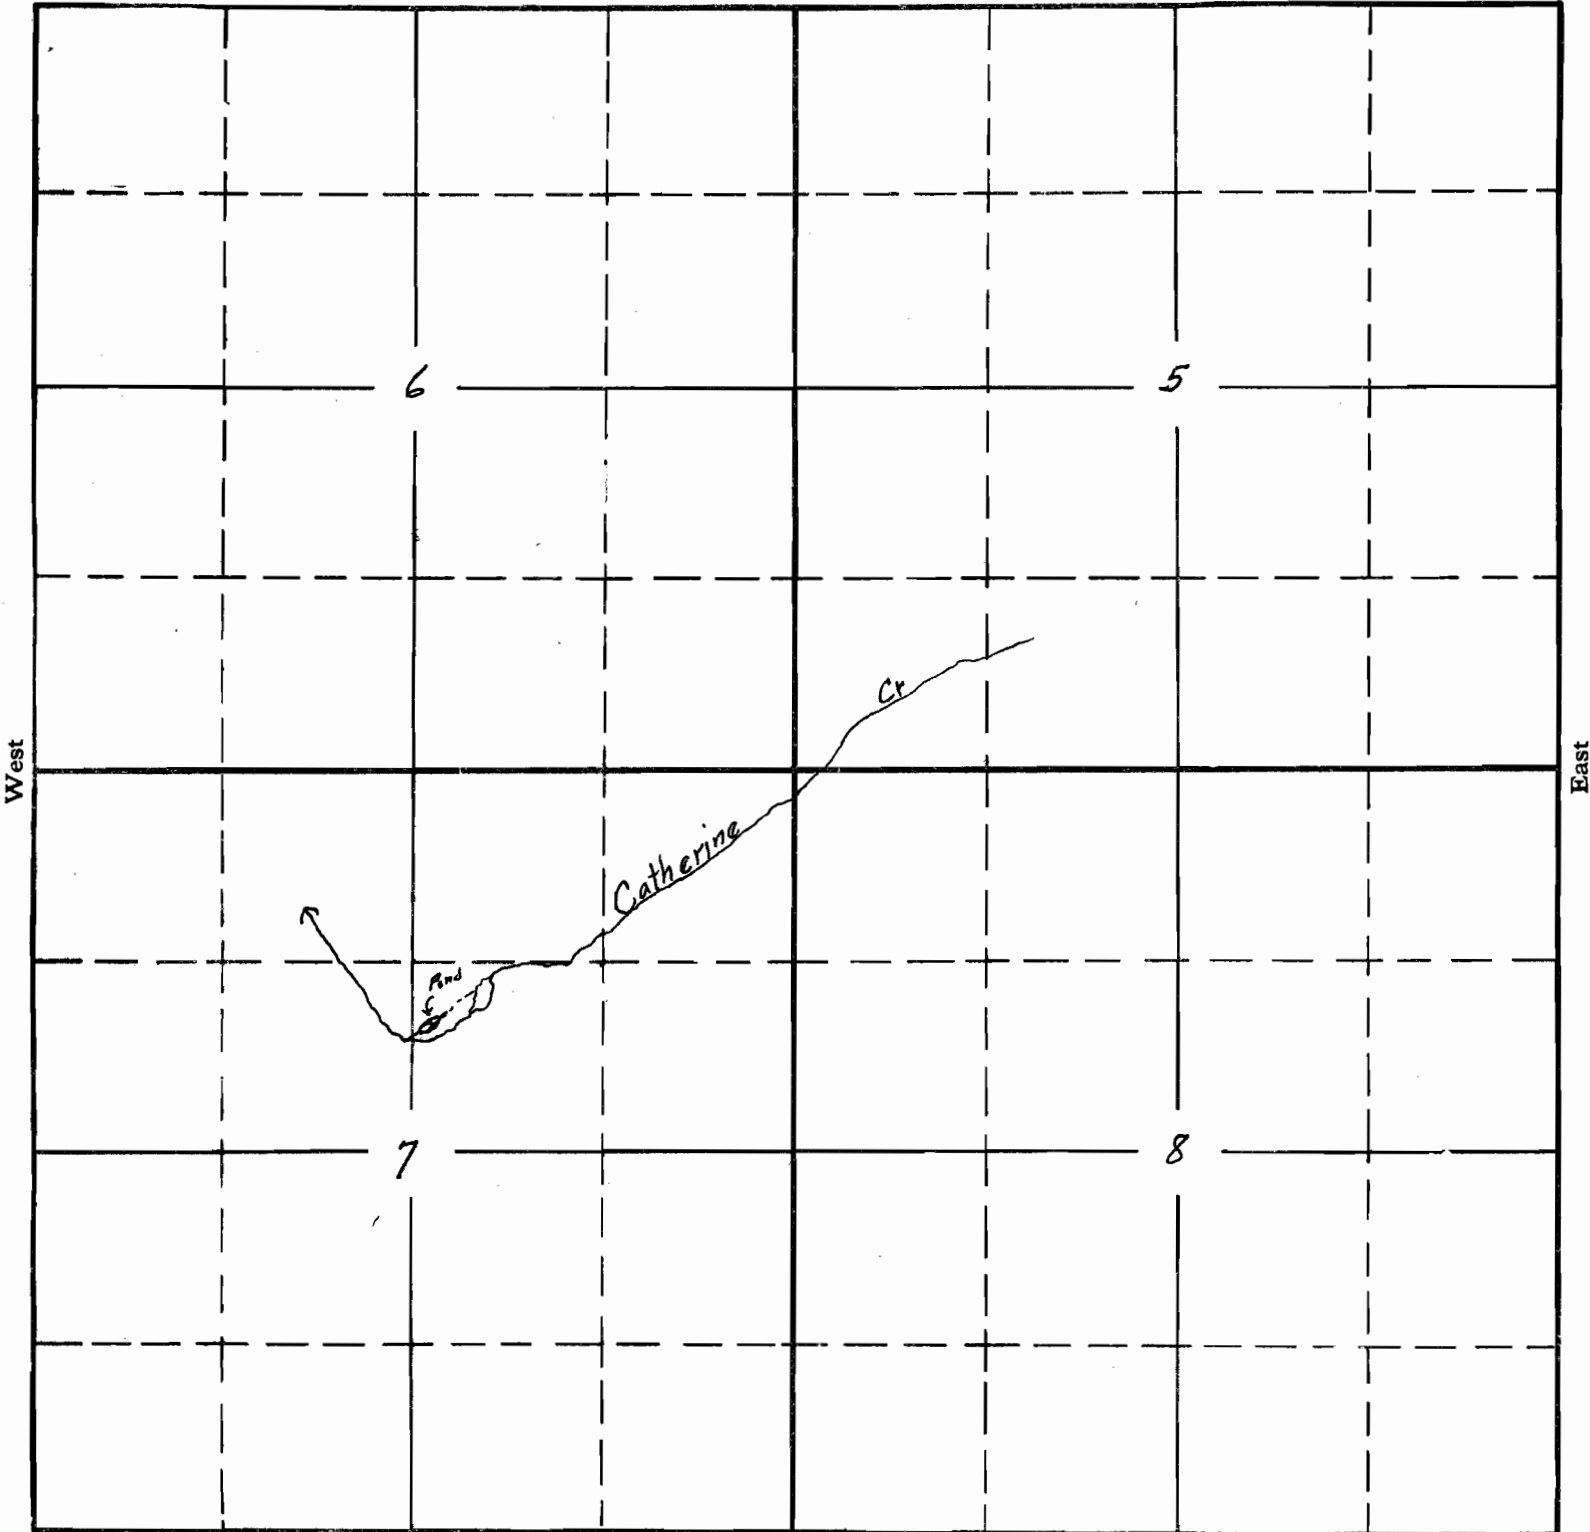

South

APPLICATION No. 15596

PERMIT No. 11449

RECEIVED  
OCT 24 1934