


TOWNSHIP 34S, RANGE 8W, W. M.

North

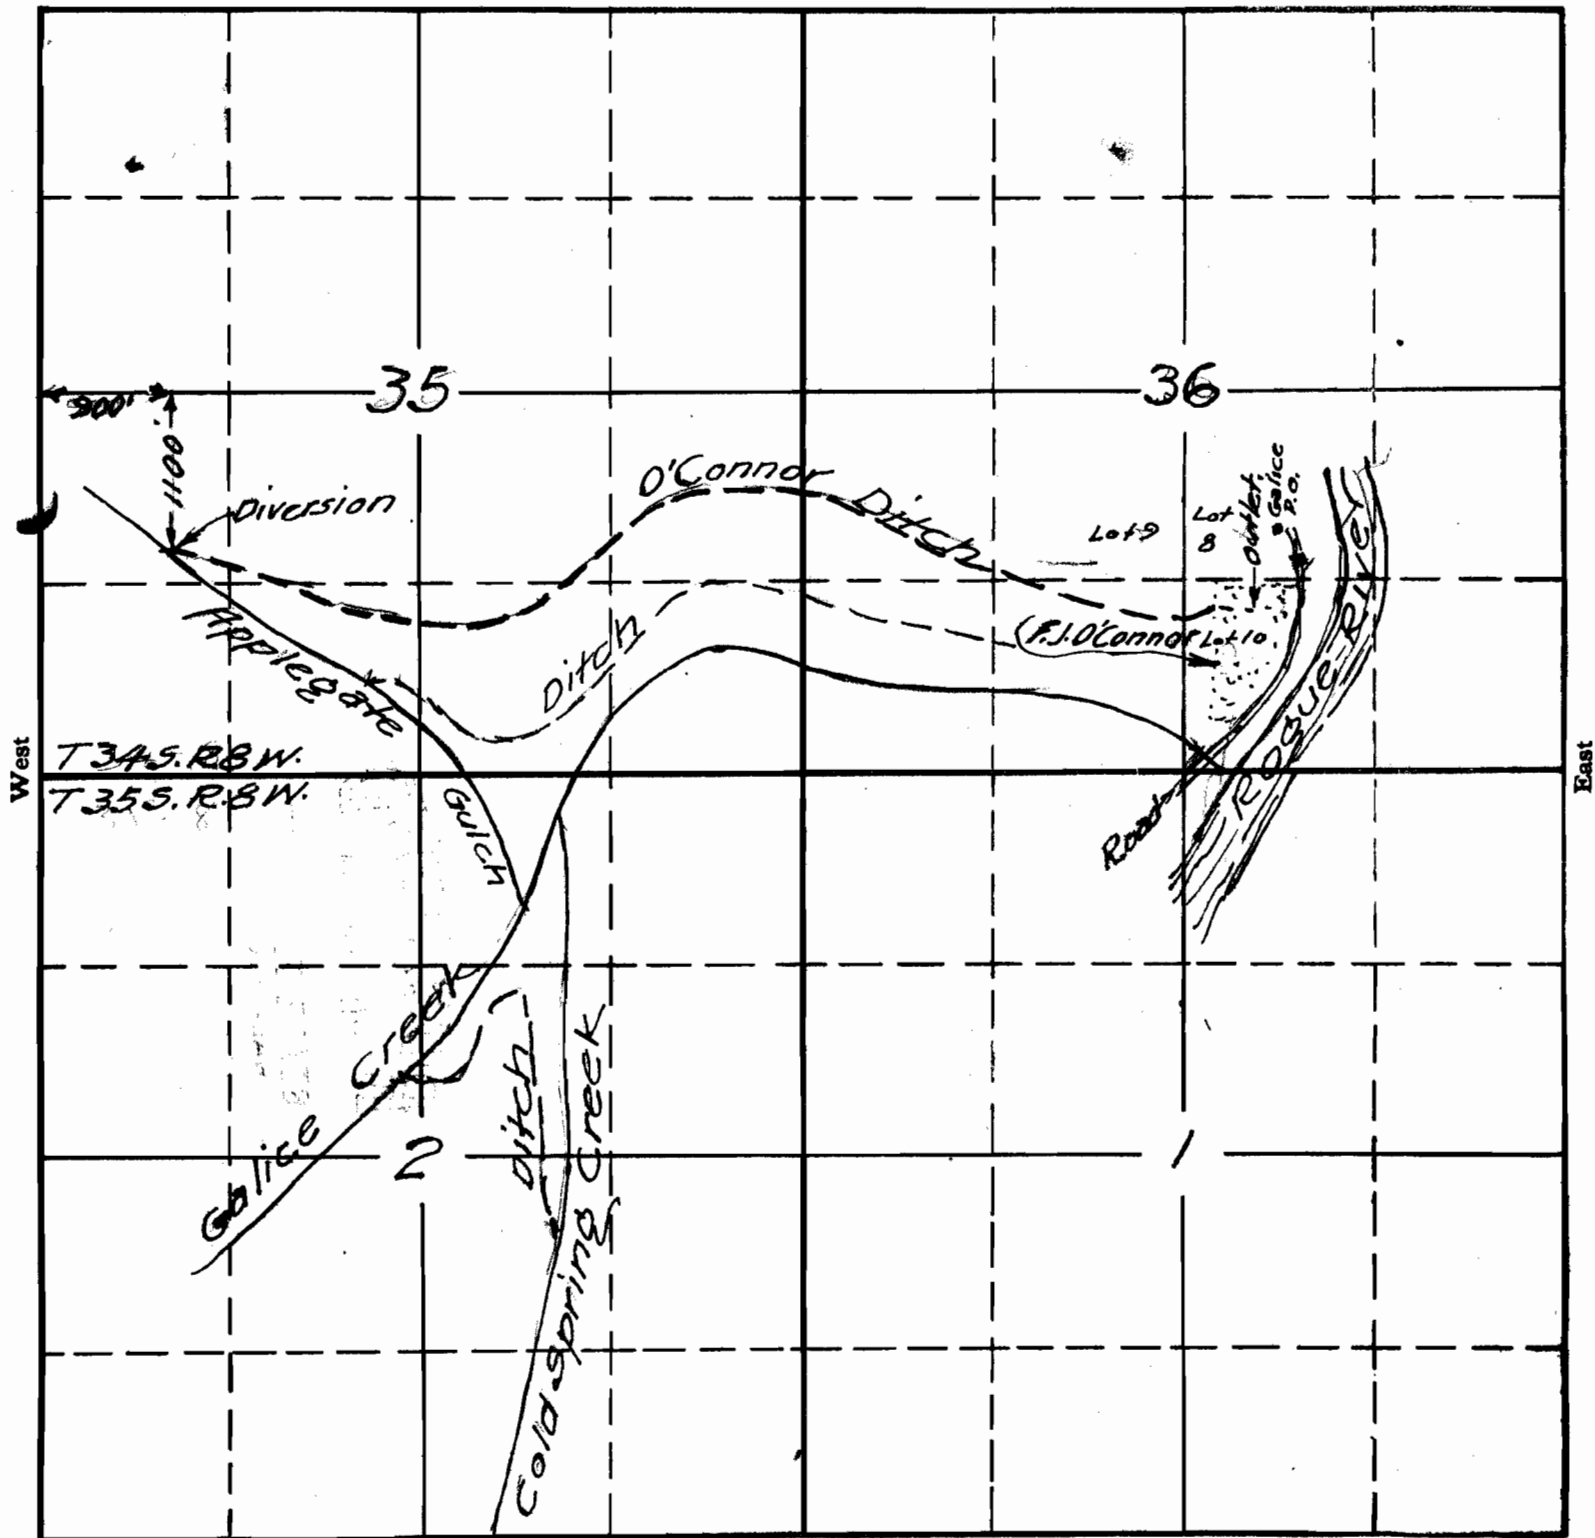

T 34S. R 8W.
T 35S. R 8W.

APPLICATION No. 15604.
PERMIT No. 11477