


Sec 19 T37SR1W.W.M.

Block 12

Block 13

Block 14

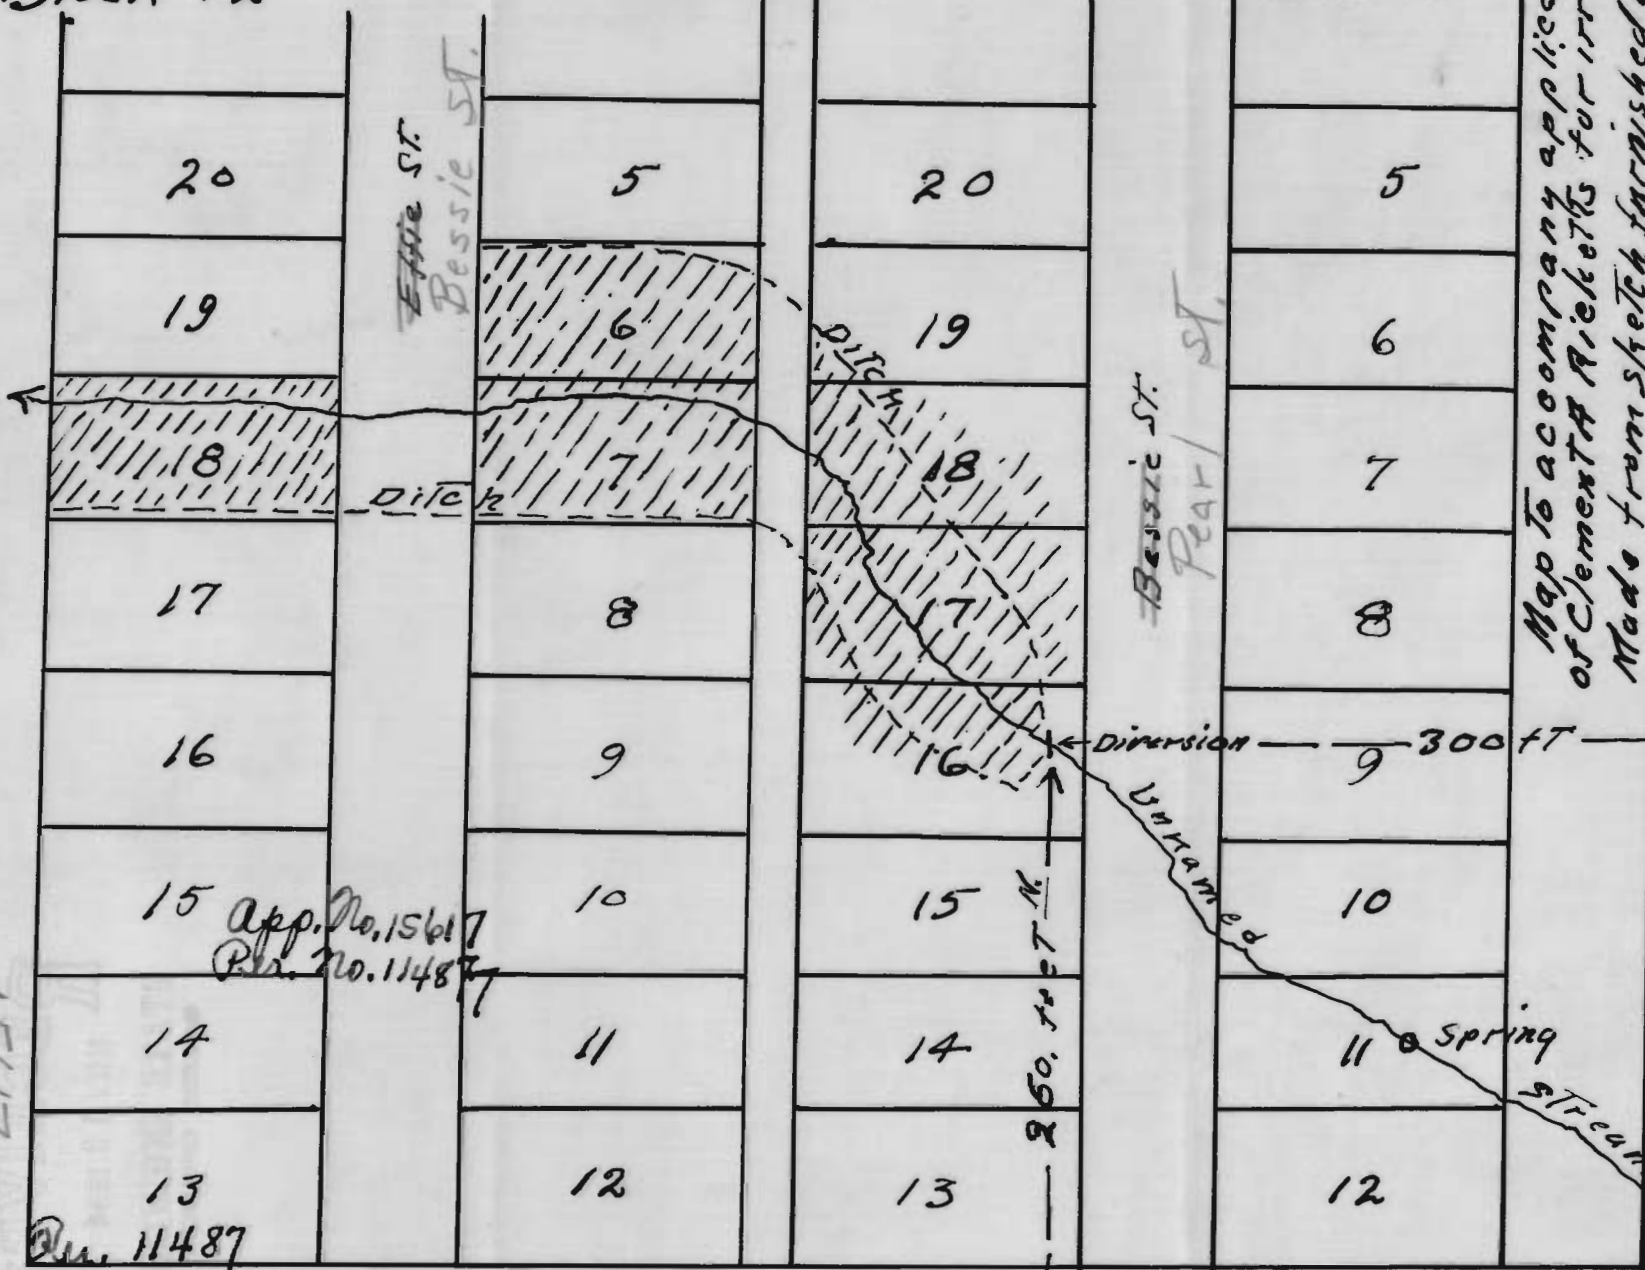

Map to accompany application  
 of Clement A. Ricketts for irrigation  
 Made from sketch furnished by him  
 and taken from survey of the  
 Laurelhurst Addition.

Sec. Cor / 19-20-30-29

JACKSON ST.

15617

Plat No. 11487

App. No. 15617  
 Plat No. 11487

Spring