


SECTION

TOWNSHIP 37S, RANGE 4N, W. M.

North

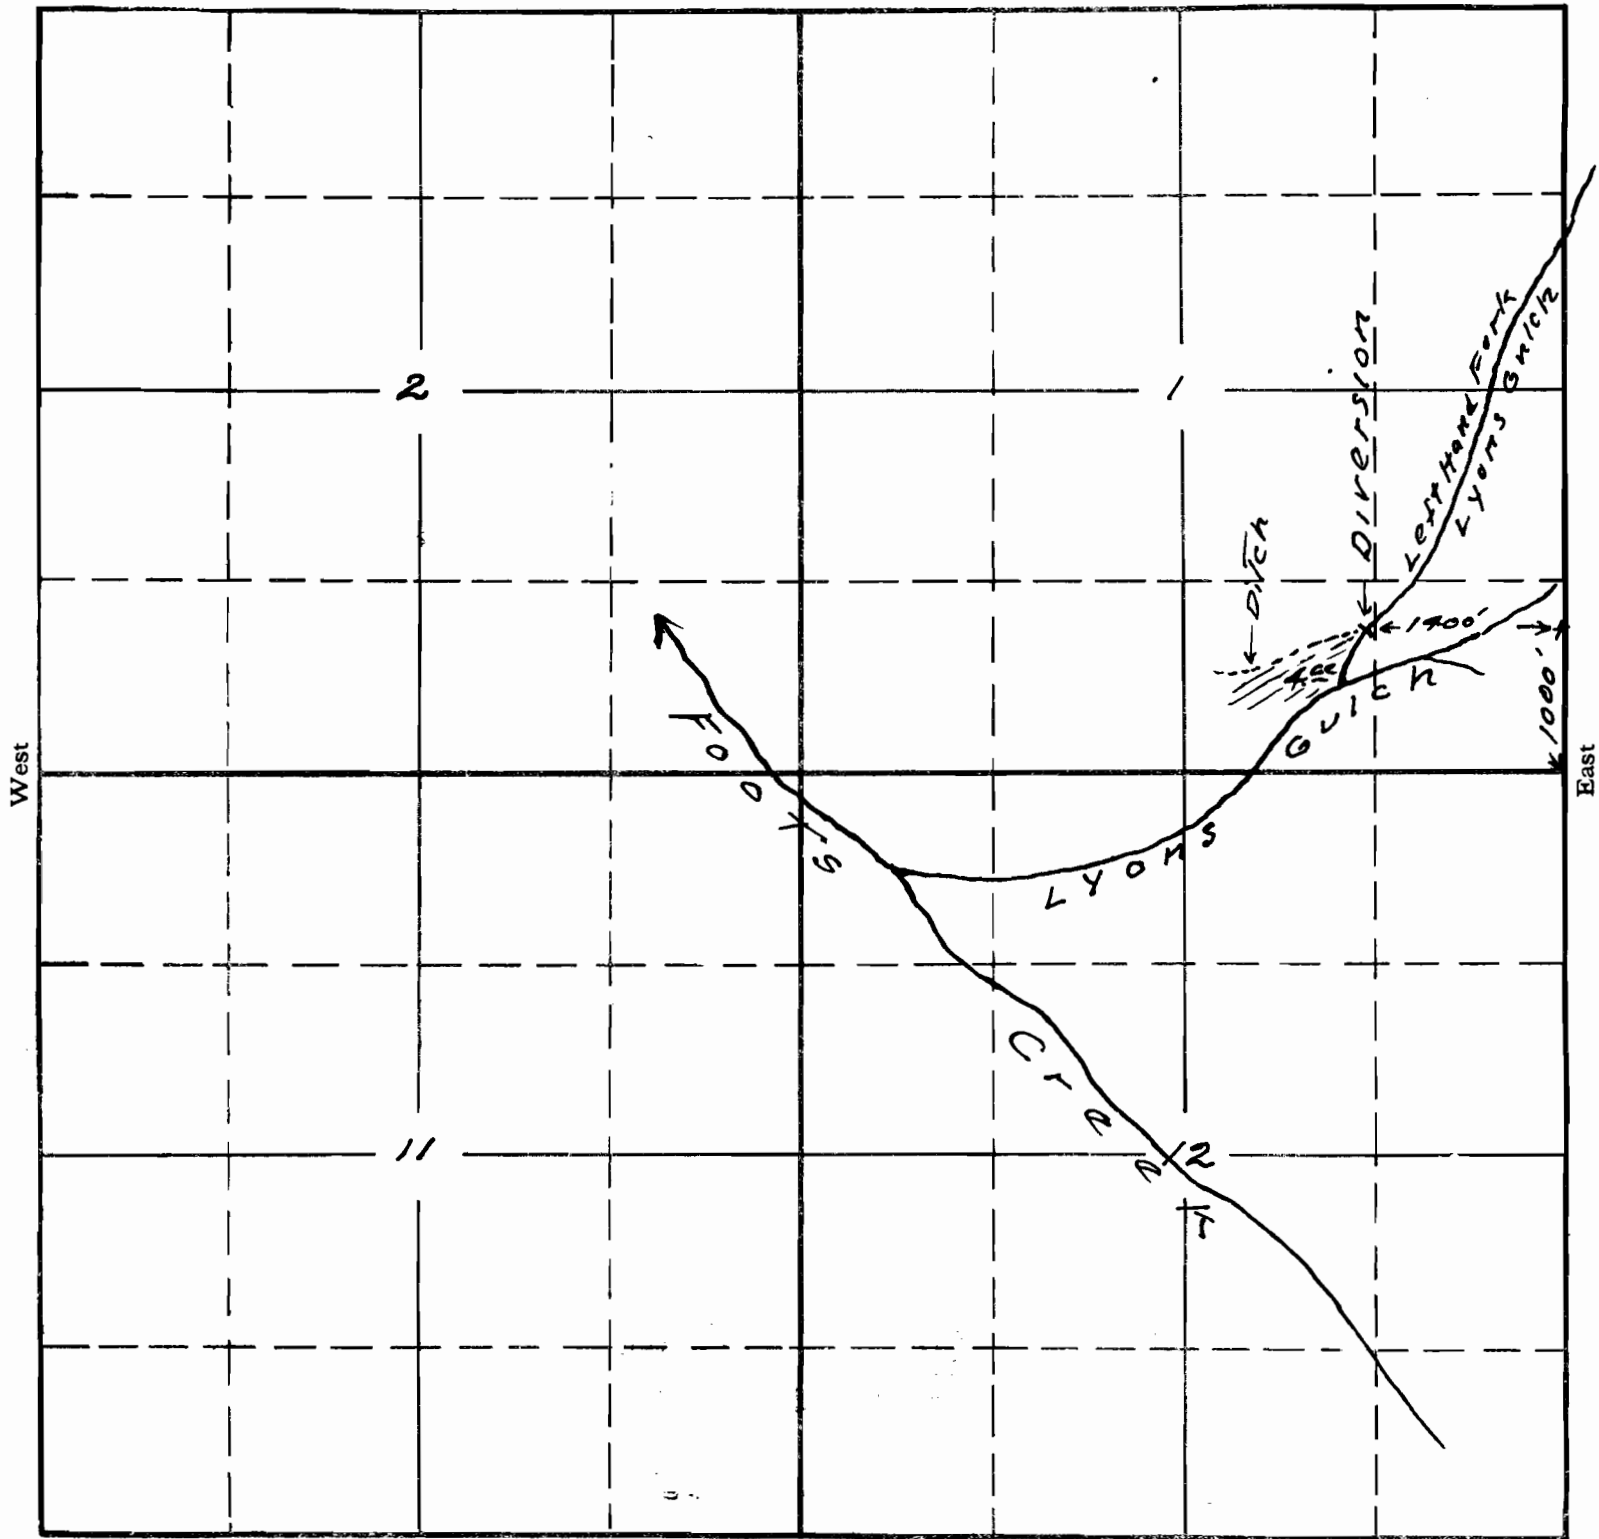

Map to accompany application of
 Chamberlin Carr. for waters
 of Left Hand Fork of Lyons Gulch
 for mining purposes

APPLICATION No. 15643
 PERMIT No. 11498